



2571

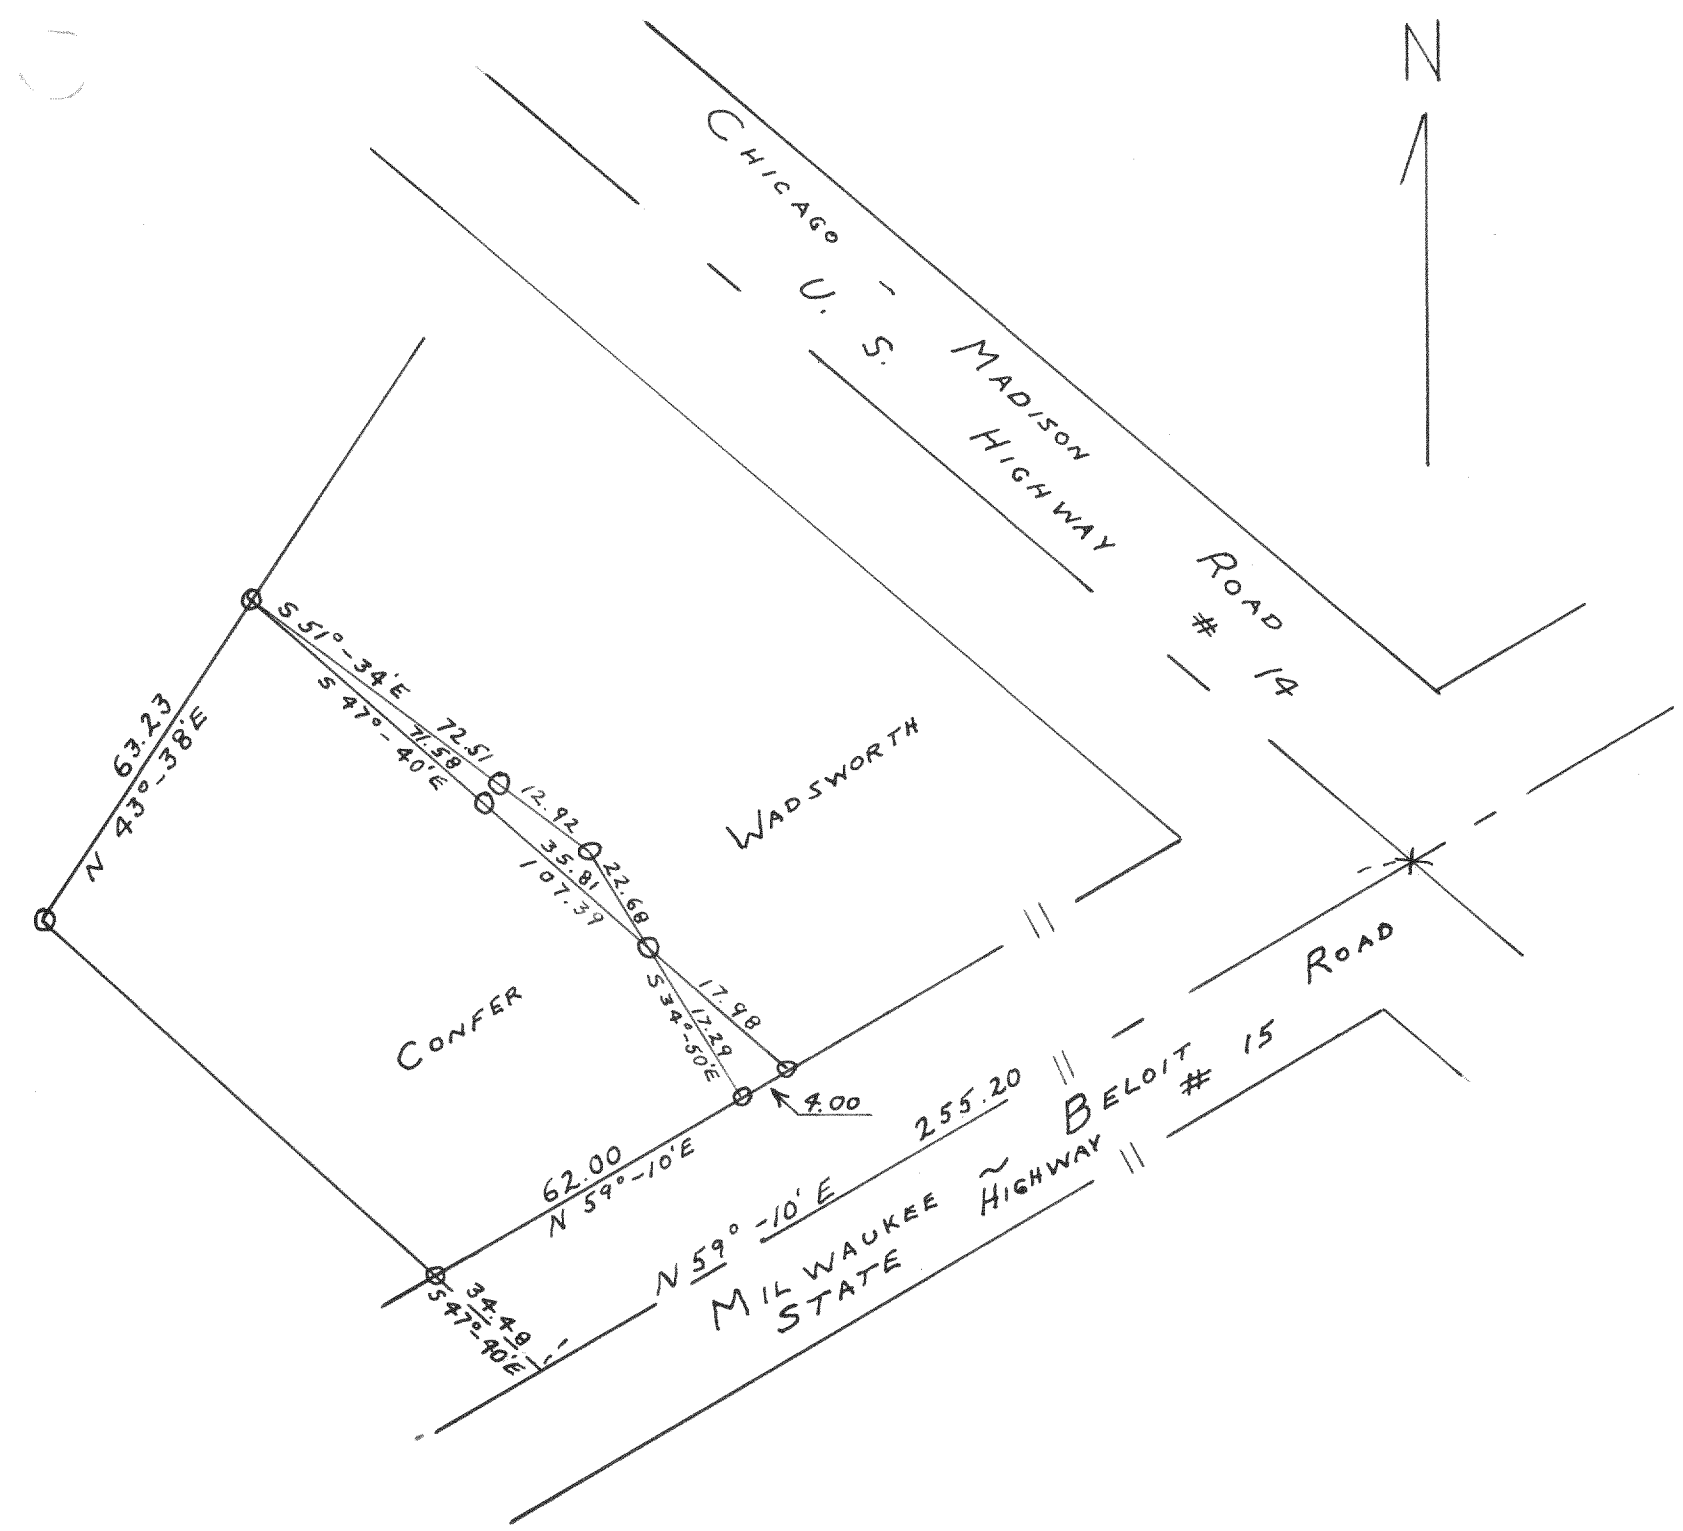

PLAT OF SURVEY OF LAND LOCATED IN
THE SOUTHWEST QUARTER OF SECTION 27,
T2N, R15E, VILLAGE OF DARIEN WALWORTH
COUNTY, WISCONSIN.
JUNE 1952

Lloyd L. Jensen SA
COUNTY SURVEYOR

2572

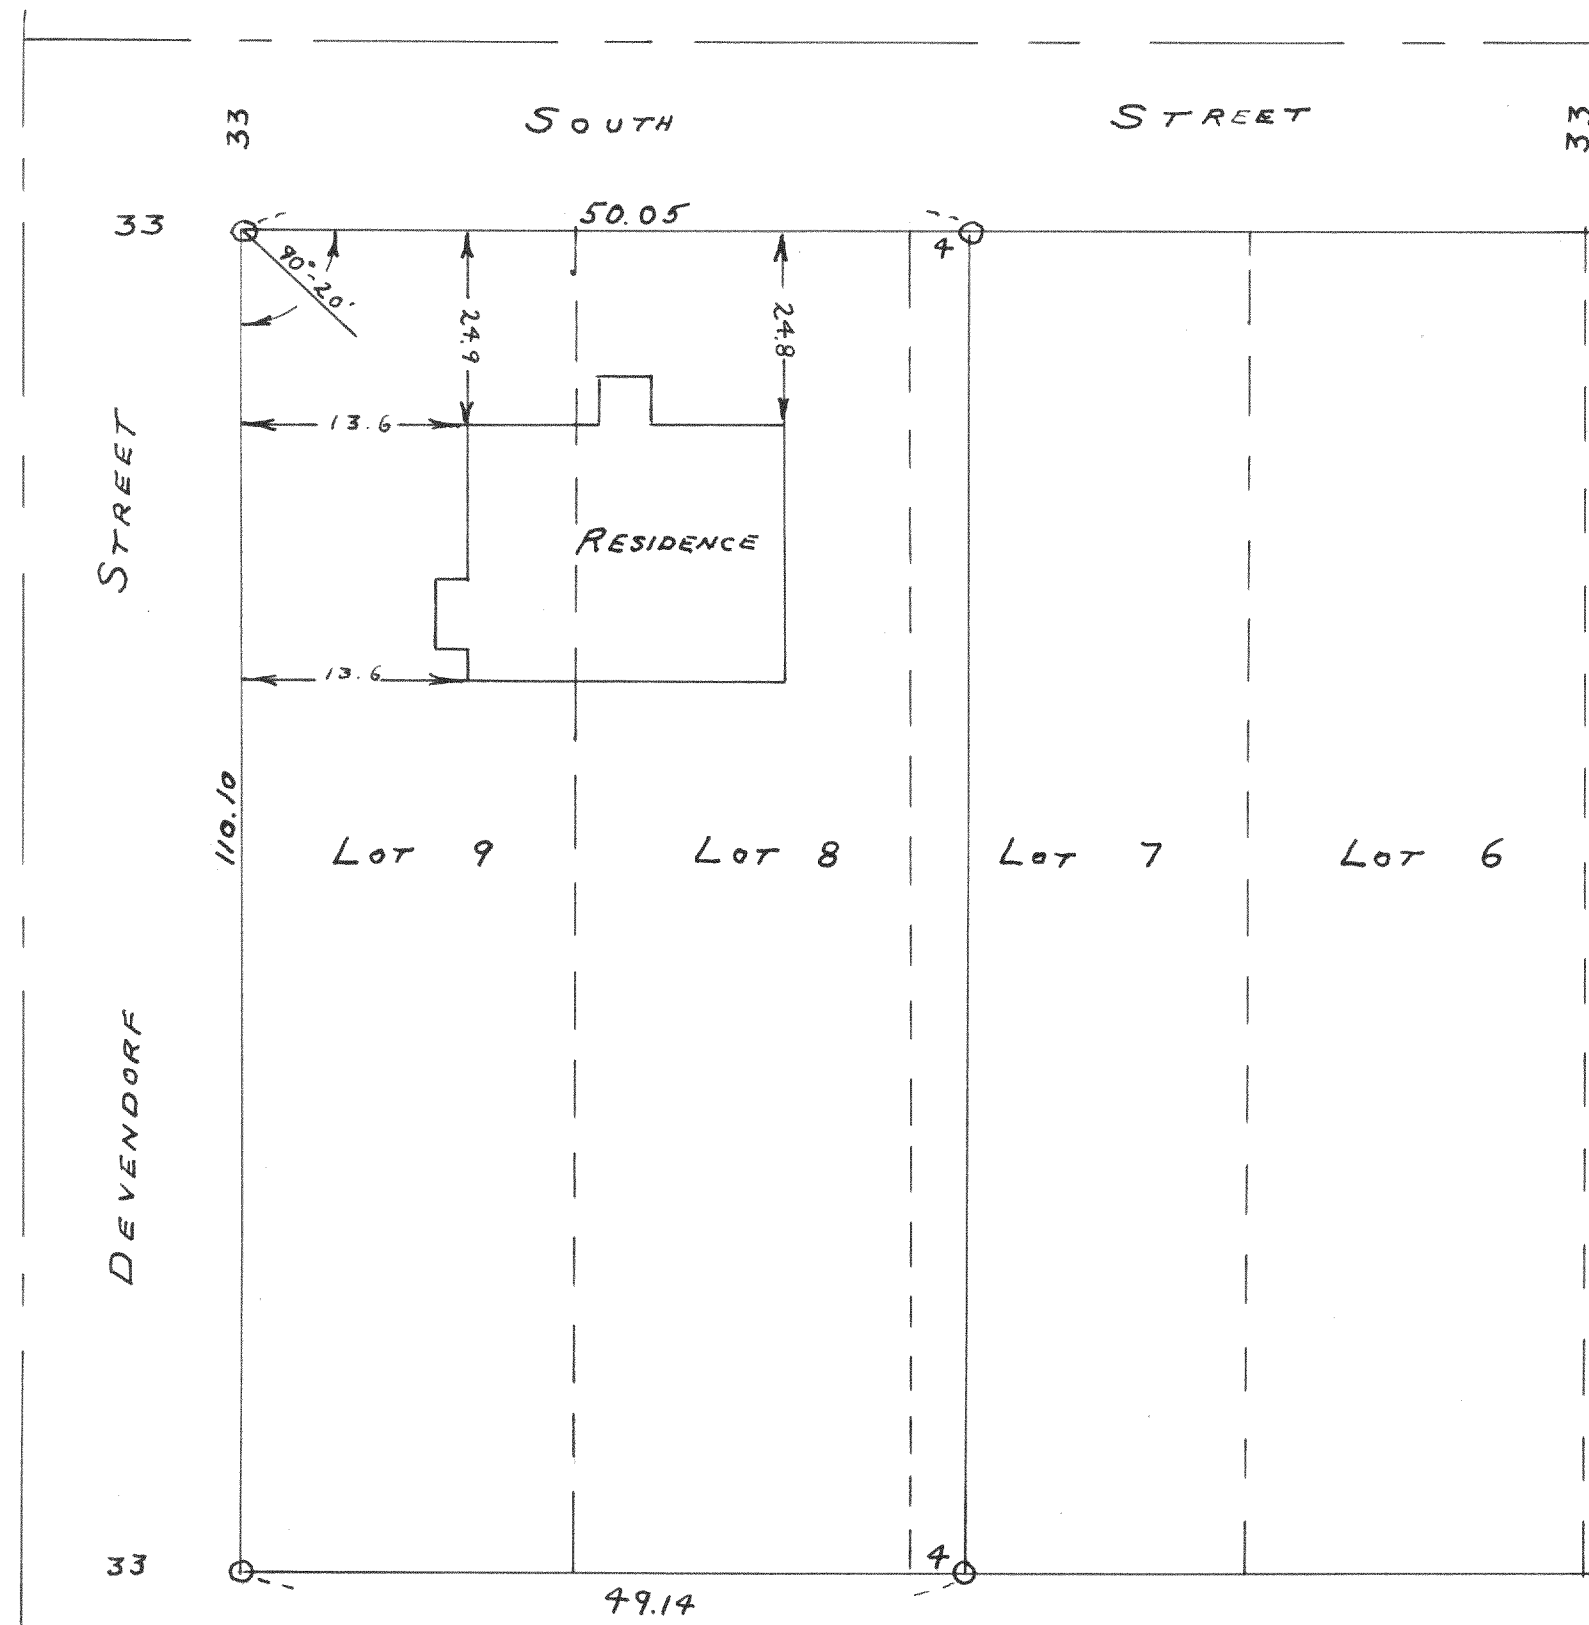

PLAT OF SURVEY OF THE WEST 4' OF LOT 7
AND LOTS 8 AND 9, BLOCK 3 IN ELKHORN
GARDENS; LOCATED IN THE CITY OF ELKHORN
WALWORTH COUNTY, WISCONSIN.
APRIL 3, 1952

Lloyd L. Jensen SA
COUNTY SURVEYOR