


2573

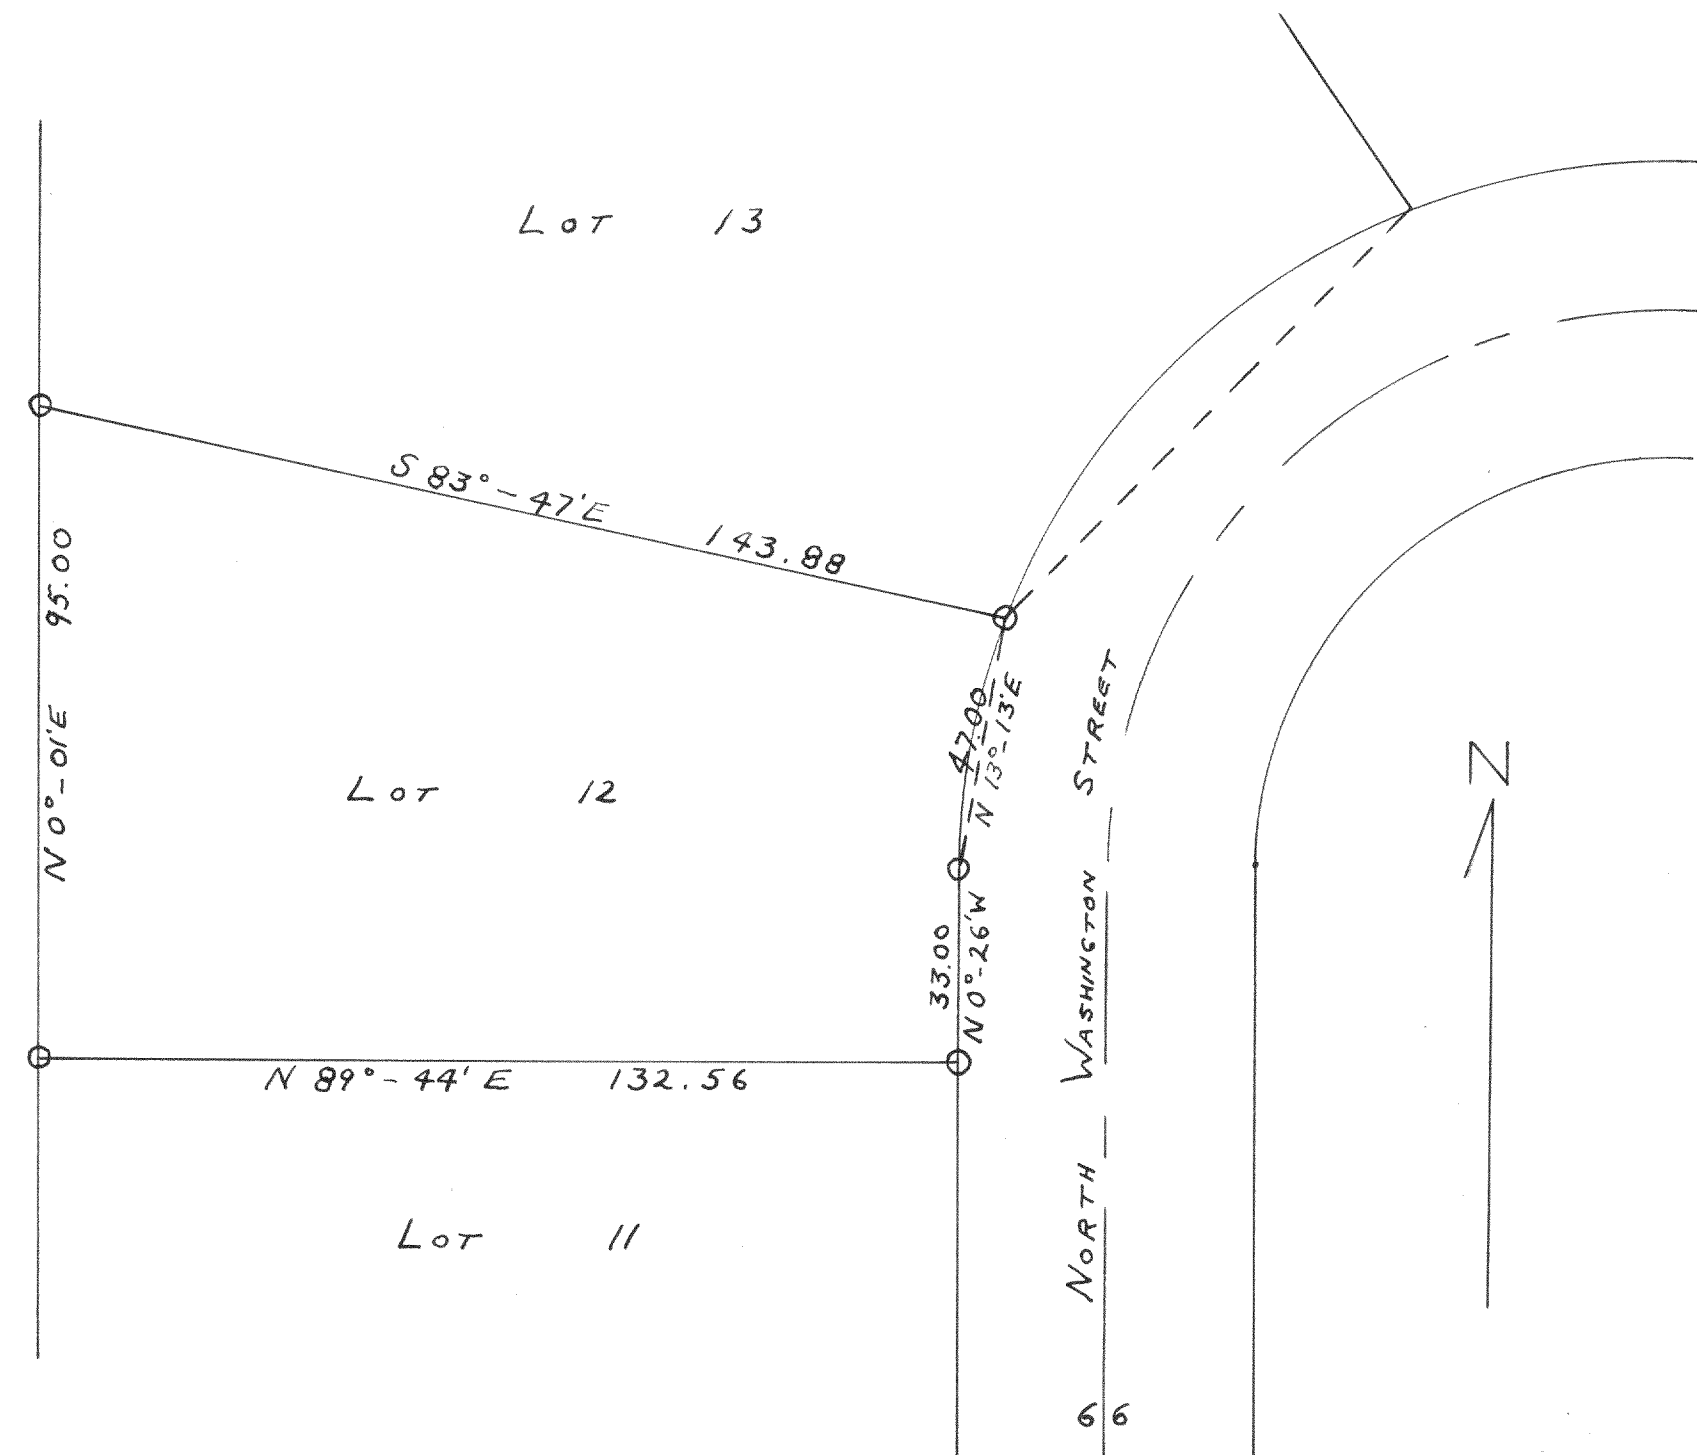

STATE OF WISCONSIN) SS
 WALWORTH COUNTY)

I, LLOYD L. JENSEN DO HEREBY CERTIFY THAT
 I HAVE SURVEYED THE PROPERTY DESCRIBED ACCORDING
 TO THE OFFICIAL RECORDS AS, LOT 12 MANN BROTHERS
 ADDITION, LOCATED IN THE CITY OF ELKHORN
 WALWORTH COUNTY, WISCONSIN, AND THAT THE PLAT
 ABOVE IS A CORRECT REPRESENTATION OF THE
 LOT LINES OF BUILDINGS THEREON.
 ELKHORN, WISCONSIN NOV. 10, 1952

Lloyd L. Jensen SA
 COUNTY SURVEYOR

2574



STATE OF WISCONSIN) SS
 WALWORTH COUNTY)

I, LLOYD L. JENSEN DO HEREBY CERTIFY THAT
 I HAVE SURVEYED THE PROPERTY SHOWN HEREON,
 AND THAT THE PLAT ABOVE IS A CORRECT
 REPRESENTATION OF THE PROPERTY LINES AND
 PRINCIPAL LINES OF BUILDINGS THEREON.

ELKHORN, WISCONSIN, NOV. 8, 1952

Lloyd L. Jensen SA
 COUNTY SURVEYOR