



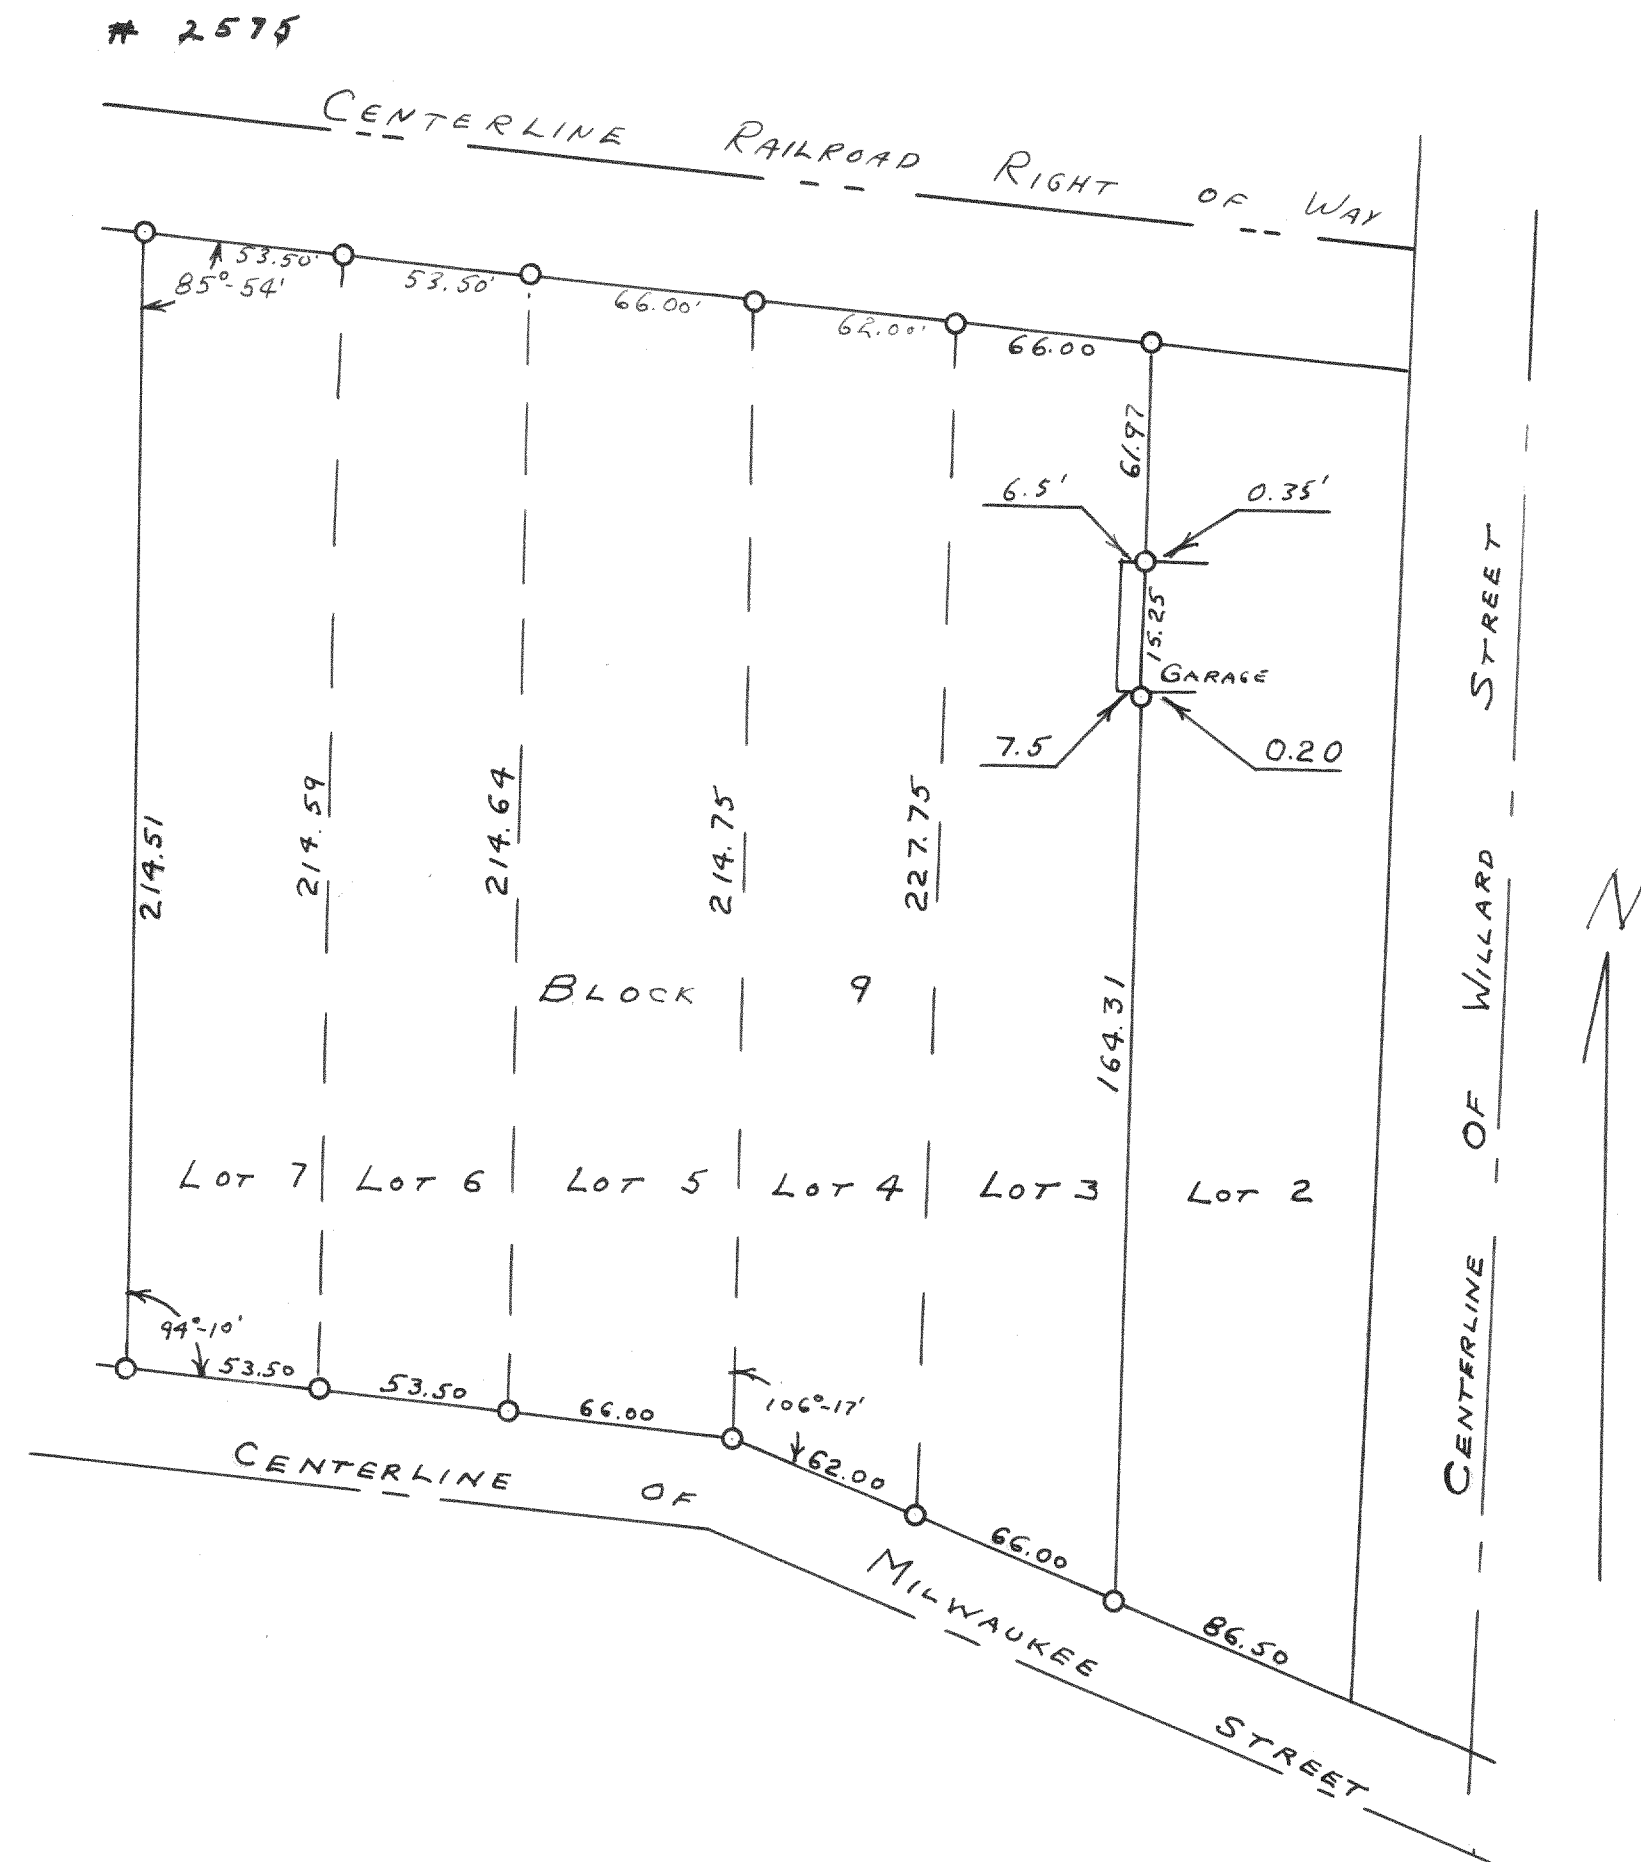

PLAT OF SURVEY OF LOTS 3 TO 7
INCLUSIVE, BLOCK 9 OF S.C. HALL'S TO
THE CITY OF WHITEWATER, WALWORTH
COUNTY, WISCONSIN

MAY 1952

Lloyd L. Jensen SA
COUNTY SURVEYOR

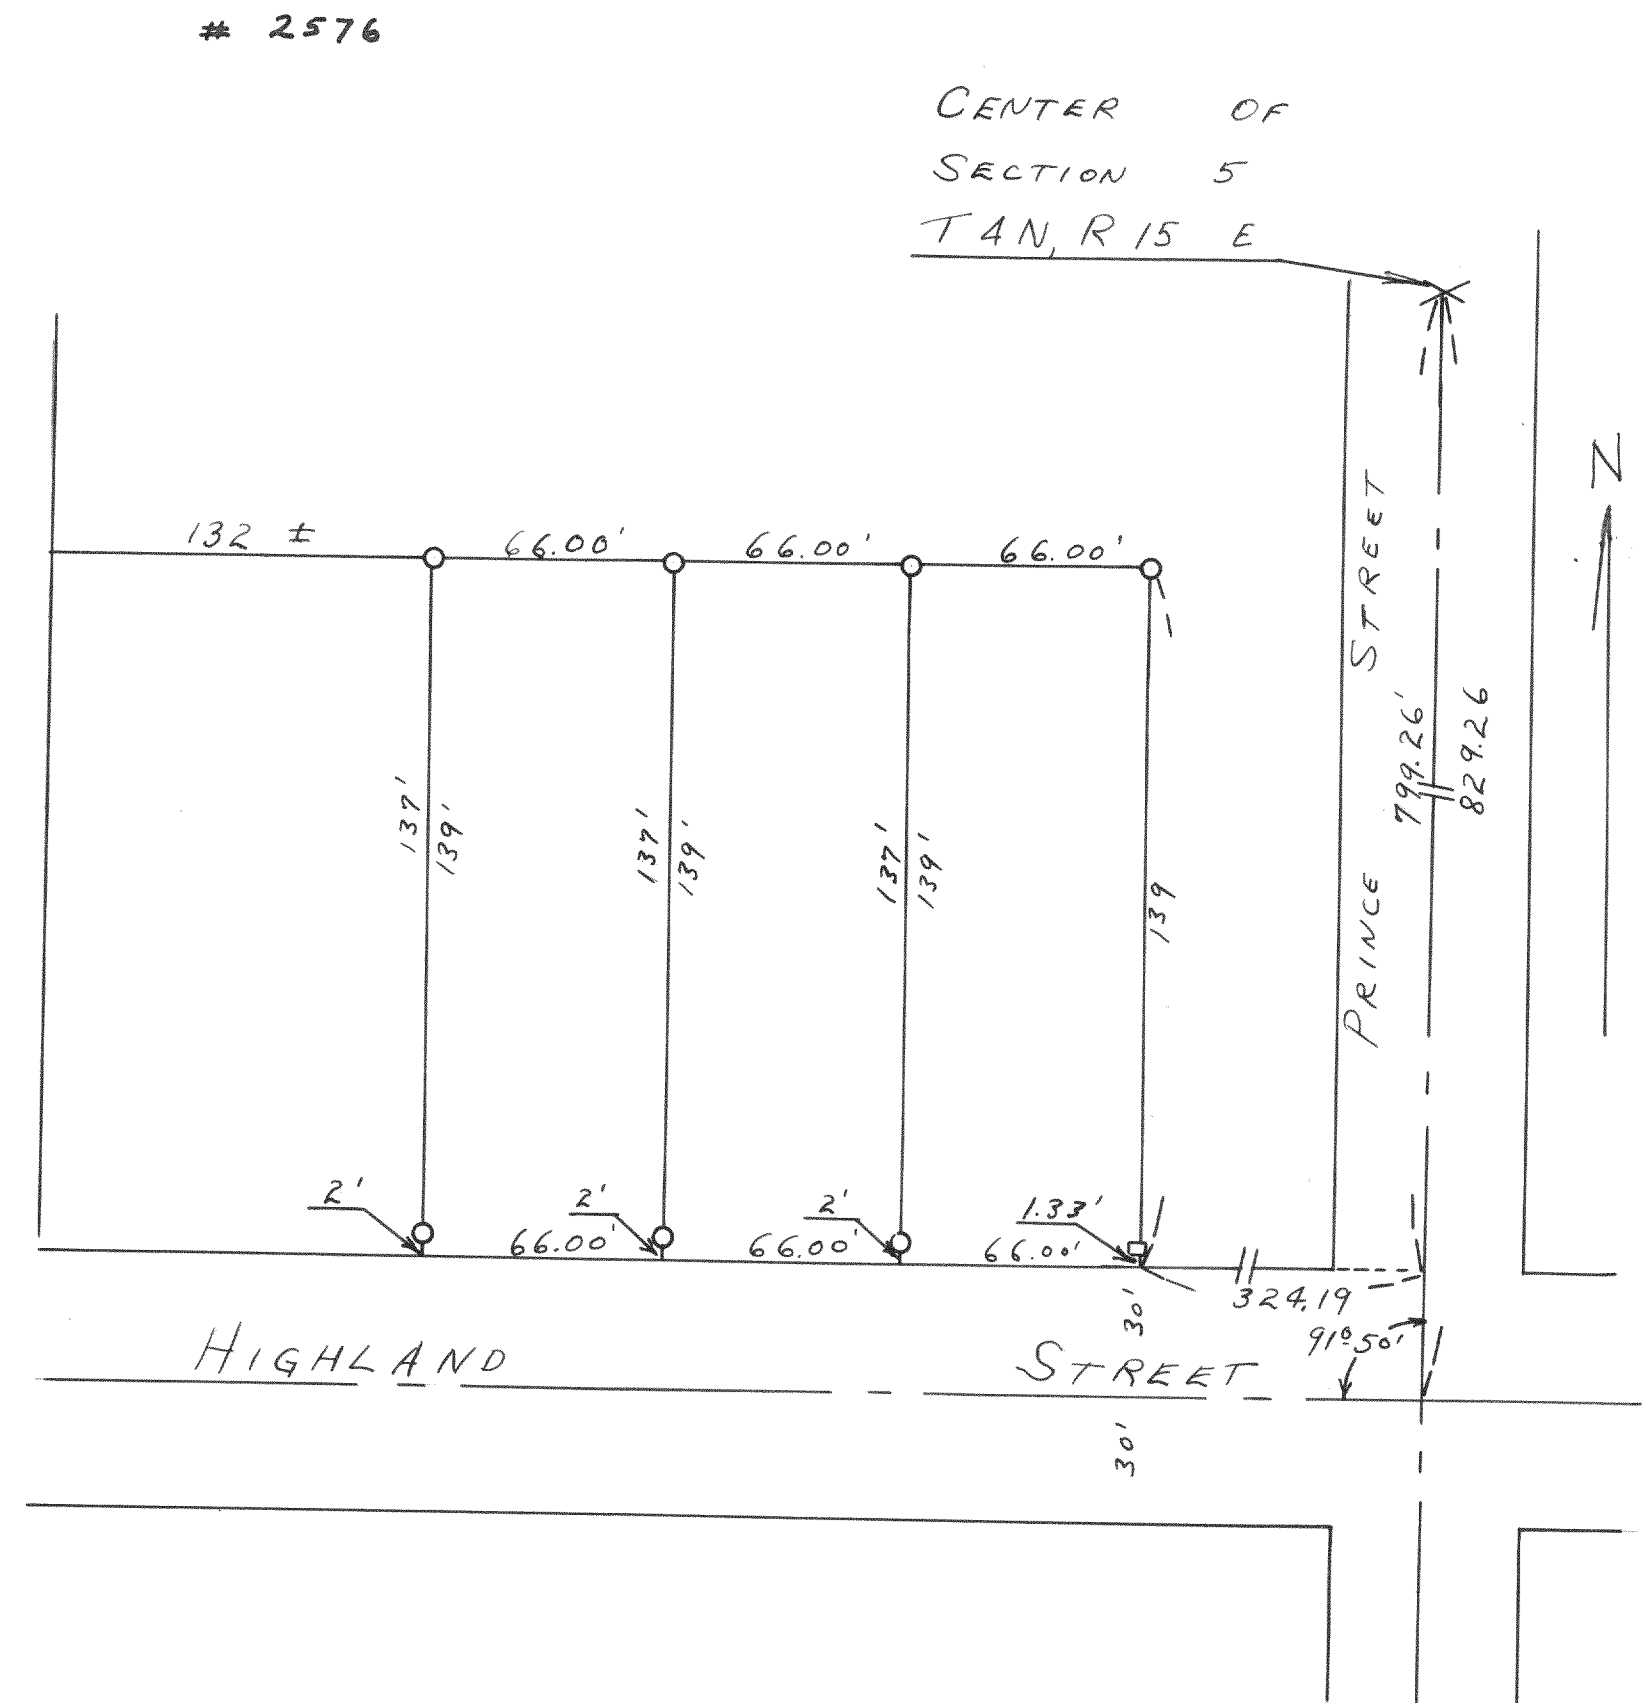

PLAT OF SURVEY OF LAND LOCATED
IN THE SOUTHWEST 1/4 OF SECTION 5,
T4N, R15E, CITY OF WHITEWATER,
WALWORTH COUNTY, WISCONSIN.

APRIL 3, 1952

Lloyd L. Jensen SA
COUNTY SURVEYOR