


2577

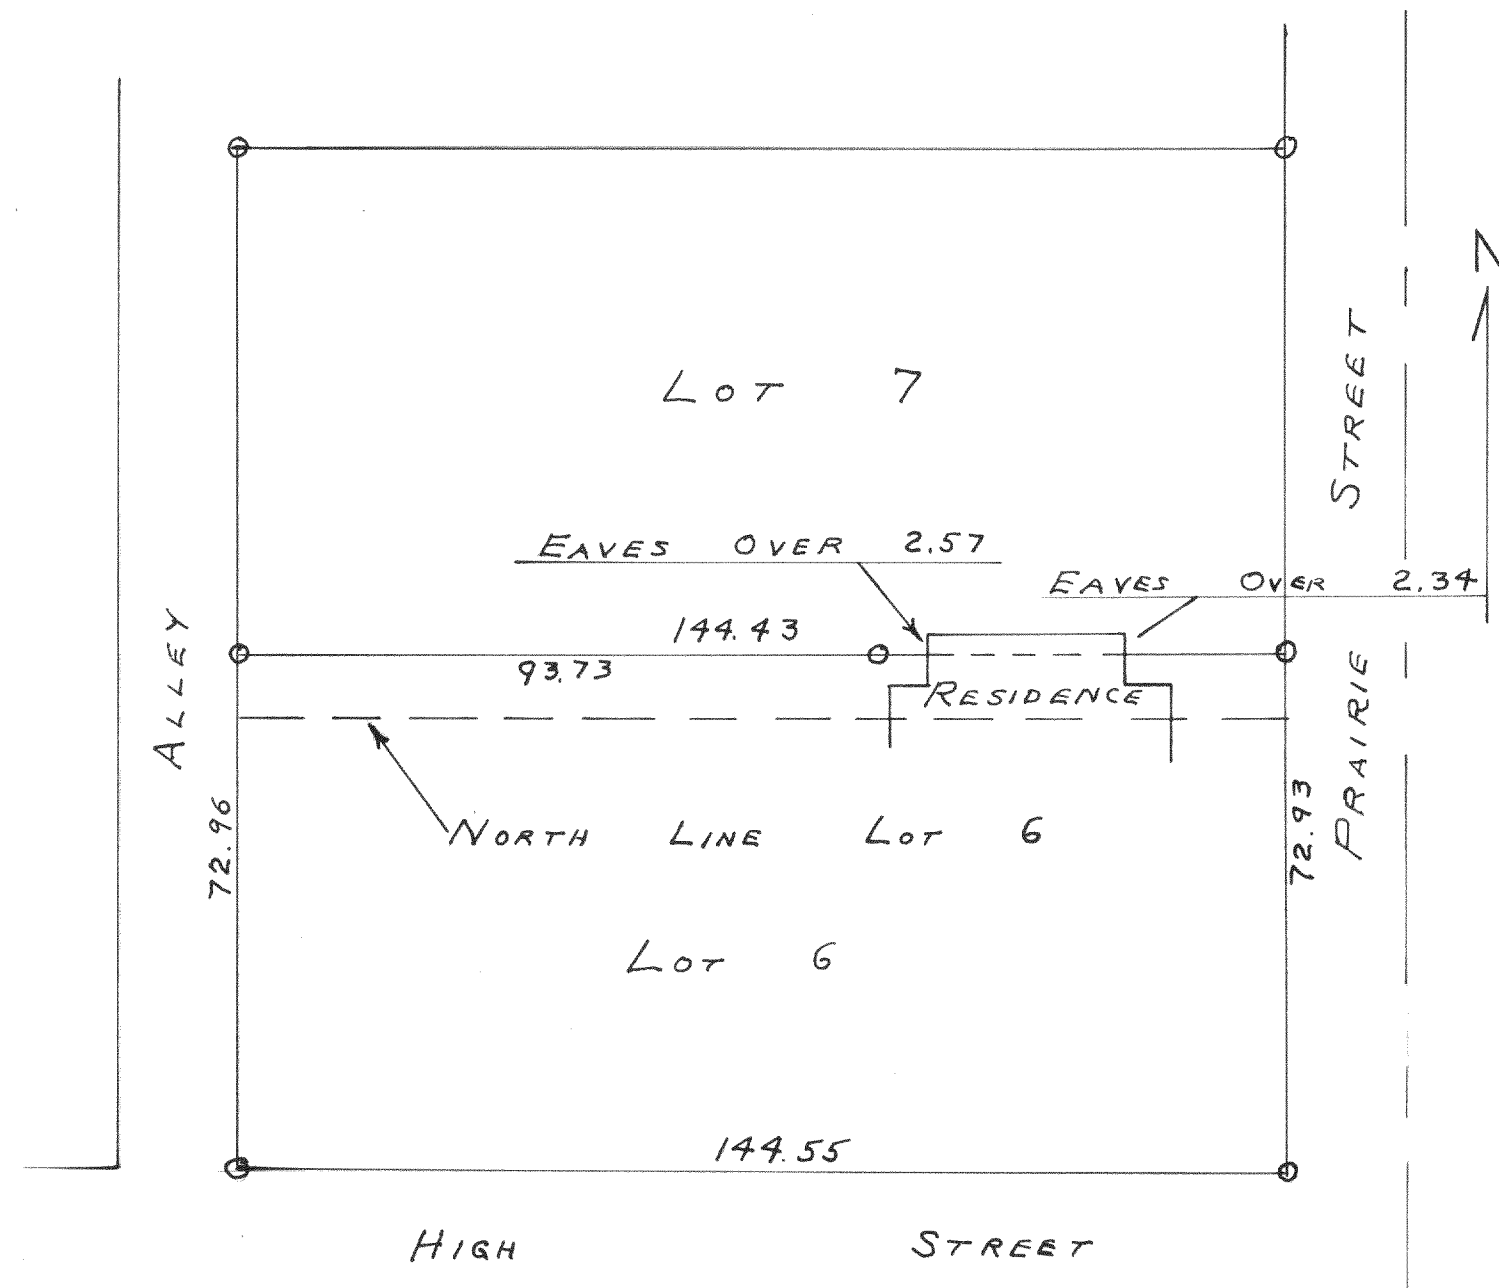


PLAT OF SURVEY OF LOT 6 AND
PART OF LOT 7 BLOCK 20 CHAPMAN
AND LUDINGTON'S ADDITION LOCATED IN
THE CITY OF WHITEWATER WALWORTH
COUNTY, WISCONSIN.

MAY 9, 1952

Lloyd L. Jensen SA
COUNTY SURVEYOR

2578

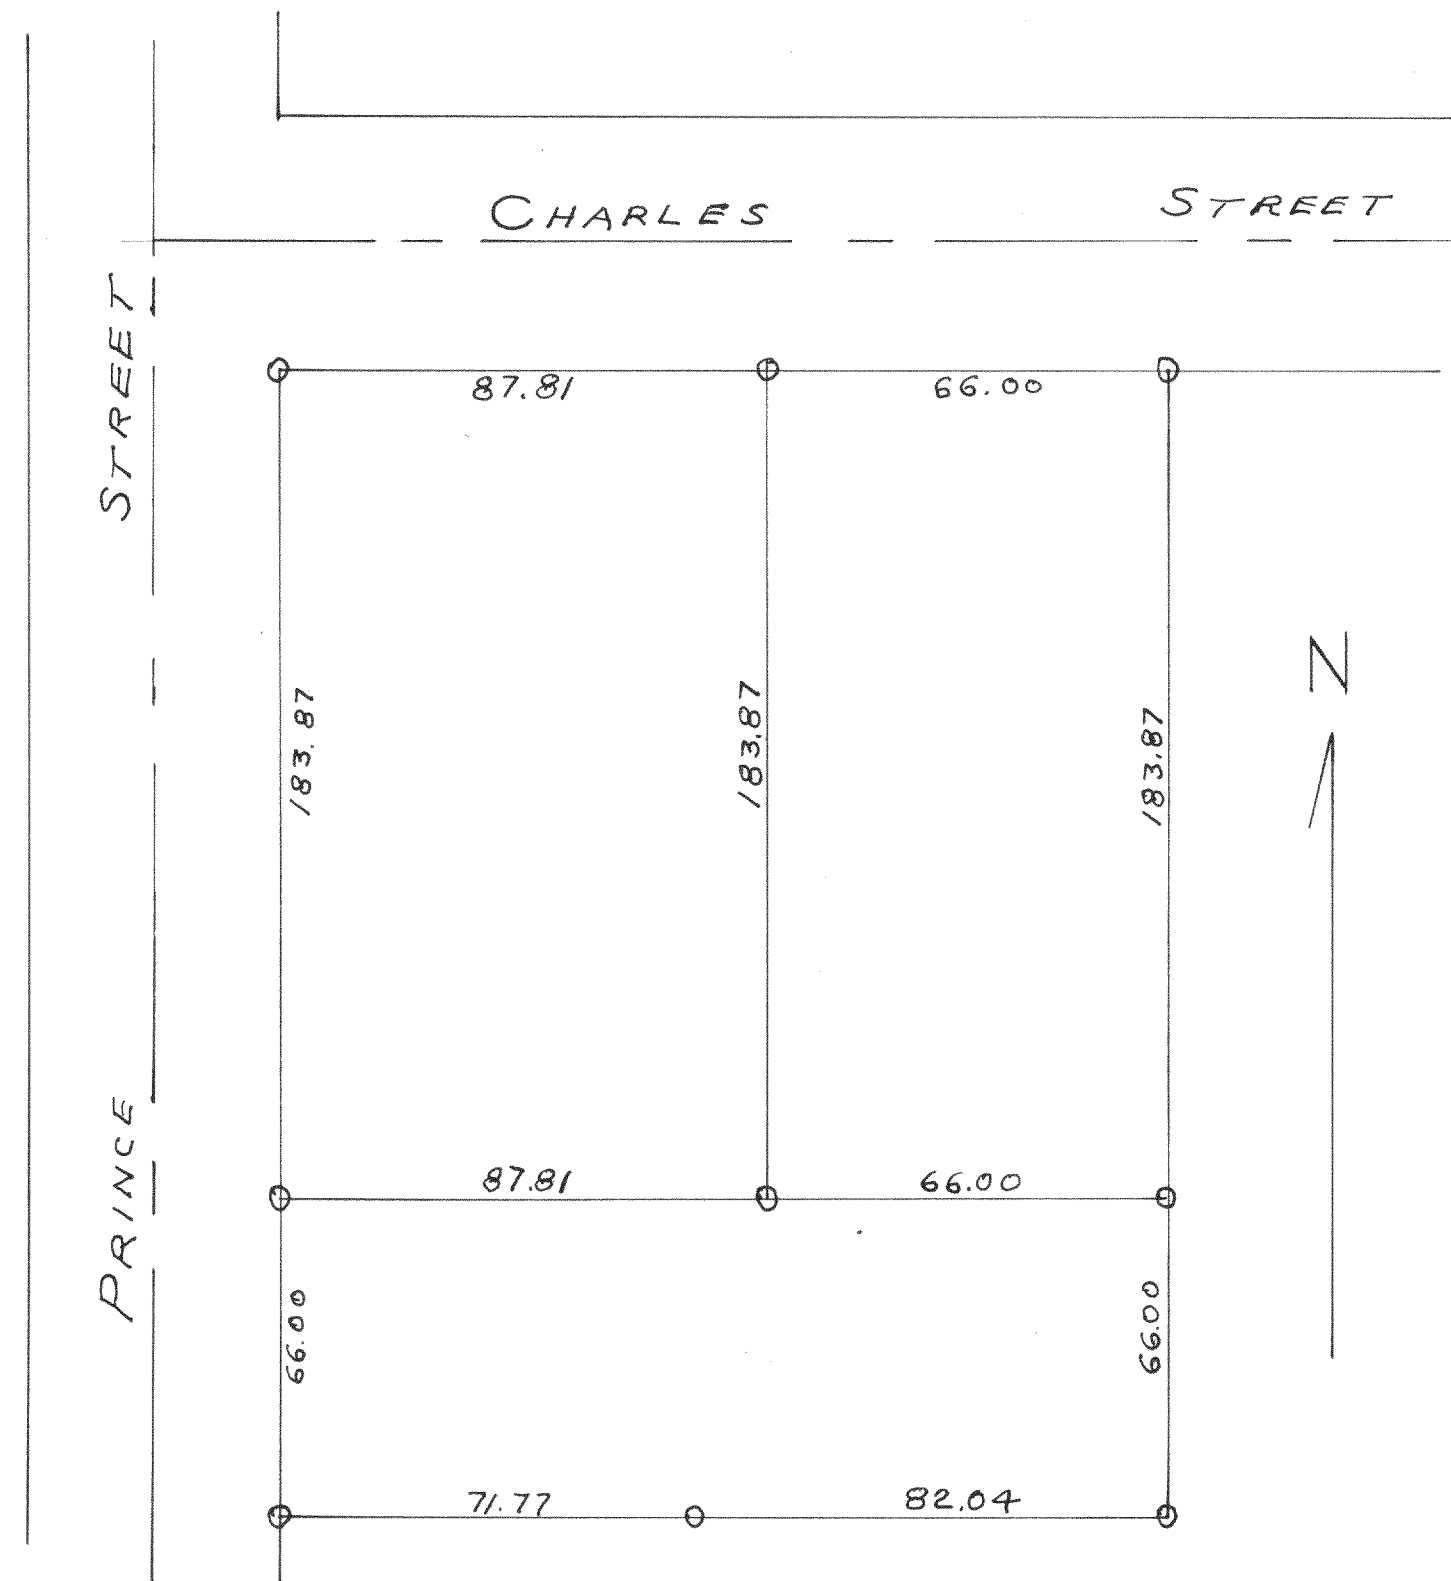

PLAT OF SURVEY OF PARCELS OF LAND
LOCATED IN LOT 4, BLOCK 3, BIRGE'S
ADDITION TO THE CITY OF WHITEWATER,
WALWORTH COUNTY, WISCONSIN

APRIL 1952

Lloyd L. Jensen SA
COUNTY SURVEYOR