


2583

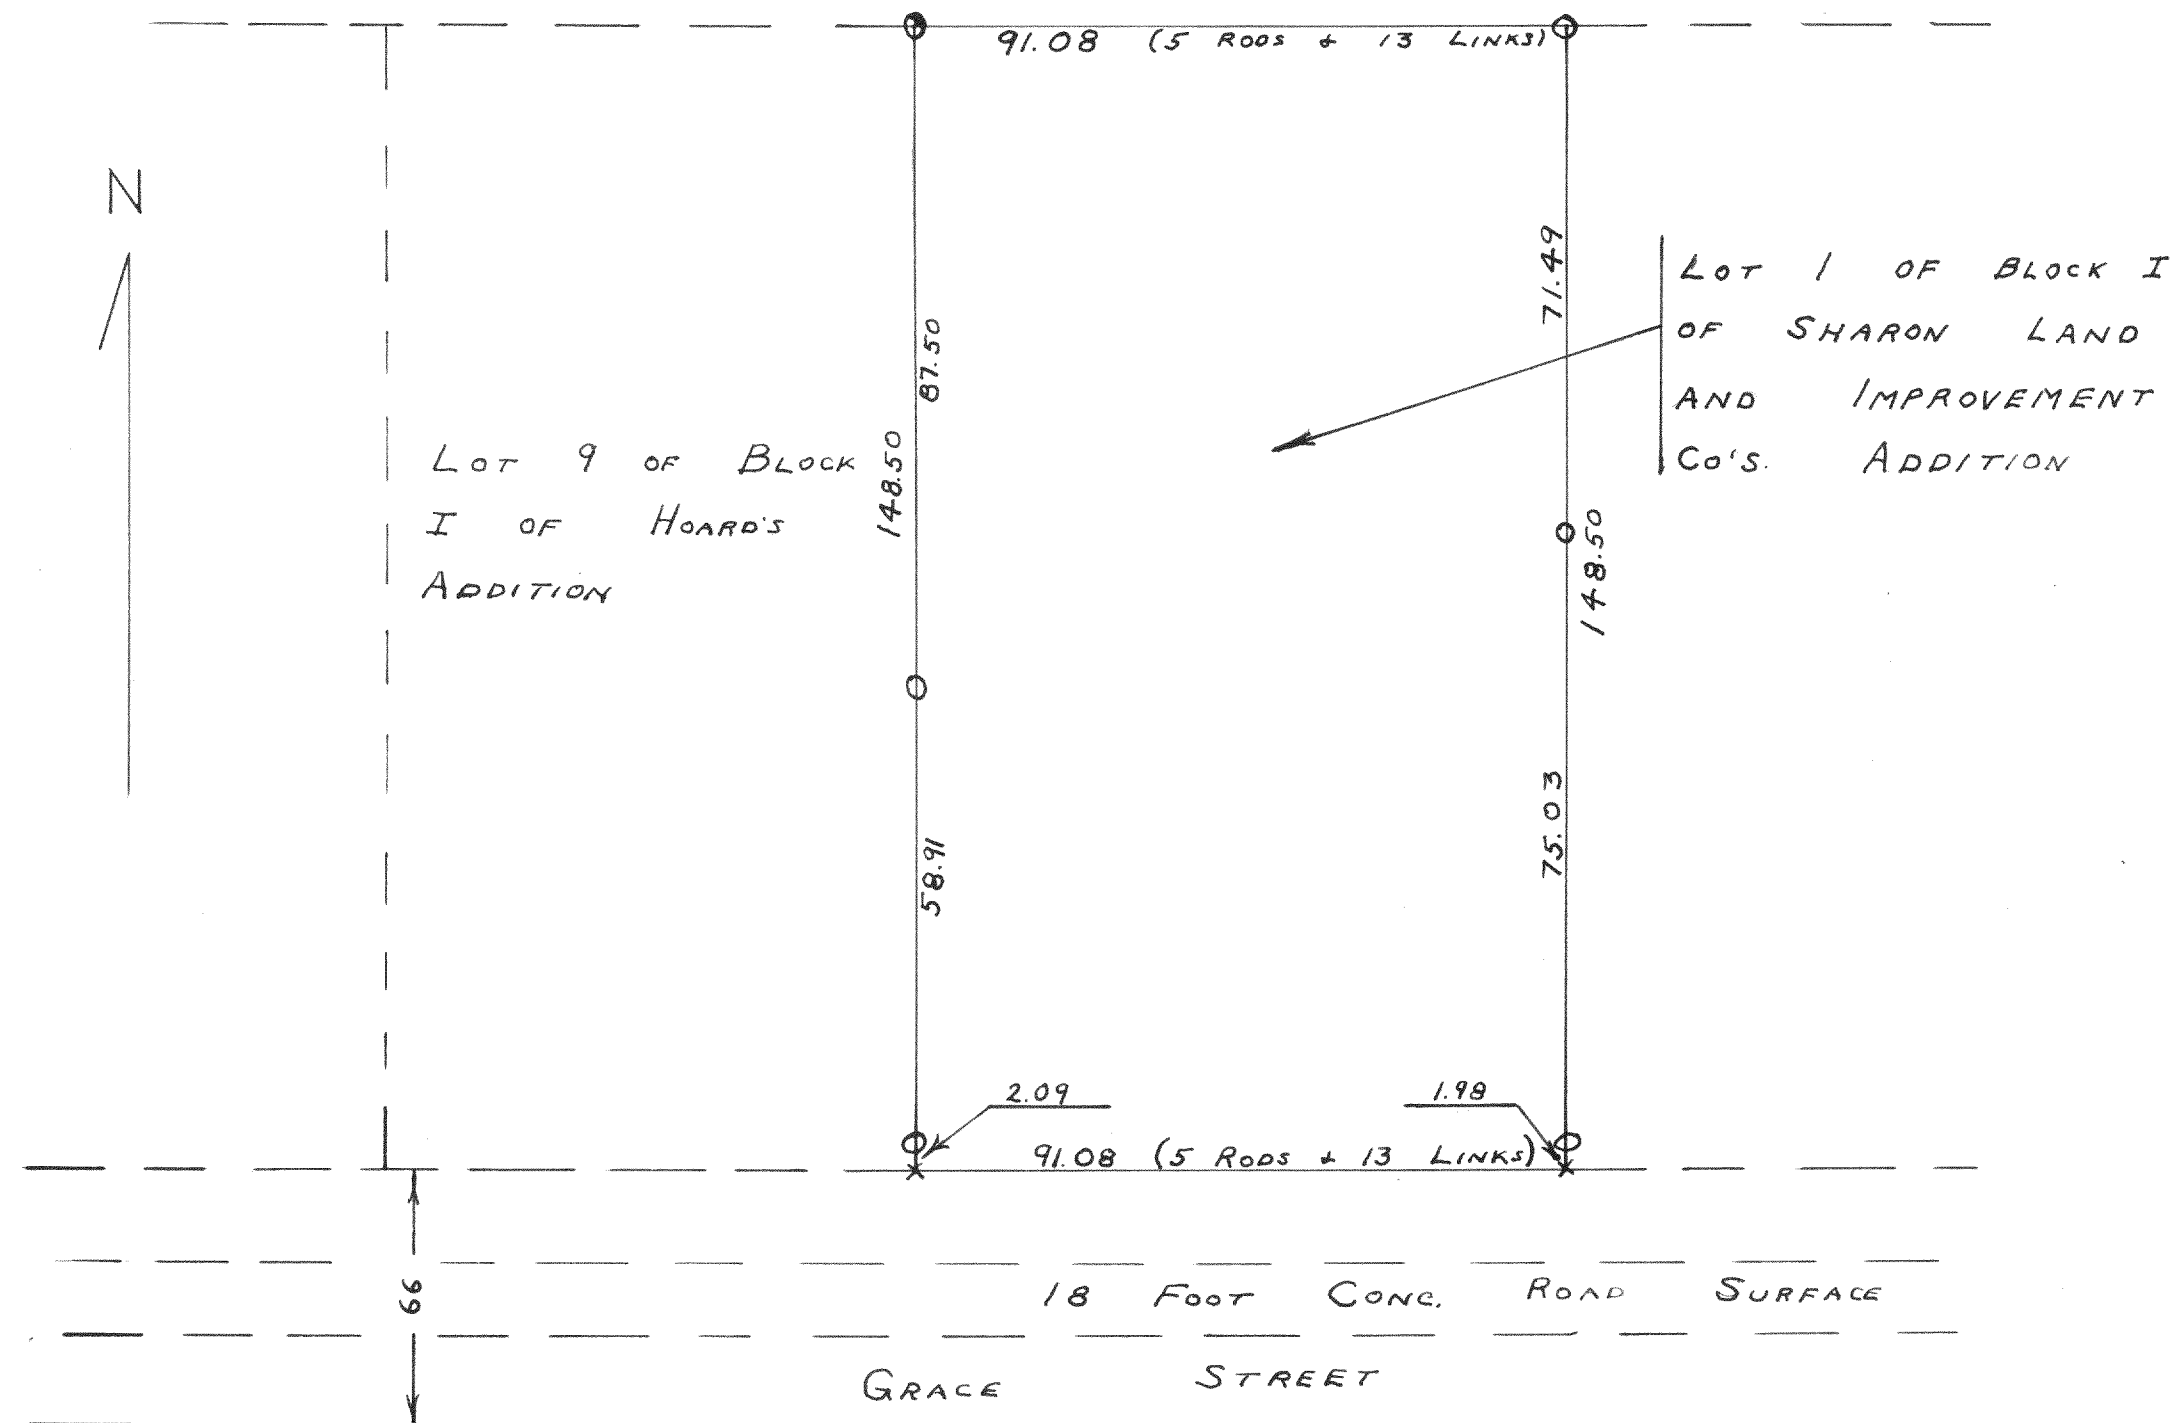


PLAT OF SURVEY OF LOT 1 OF BLOCK I
OF SHARON LAND AND IMPROVEMENT COMPANY'S
ADDITION TO THE VILLAGE OF SHARON,
WALWORTH COUNTY, WISCONSIN.

JULY 1952

Lloyd L. Jensen SA
COUNTY SURVEYOR

2584

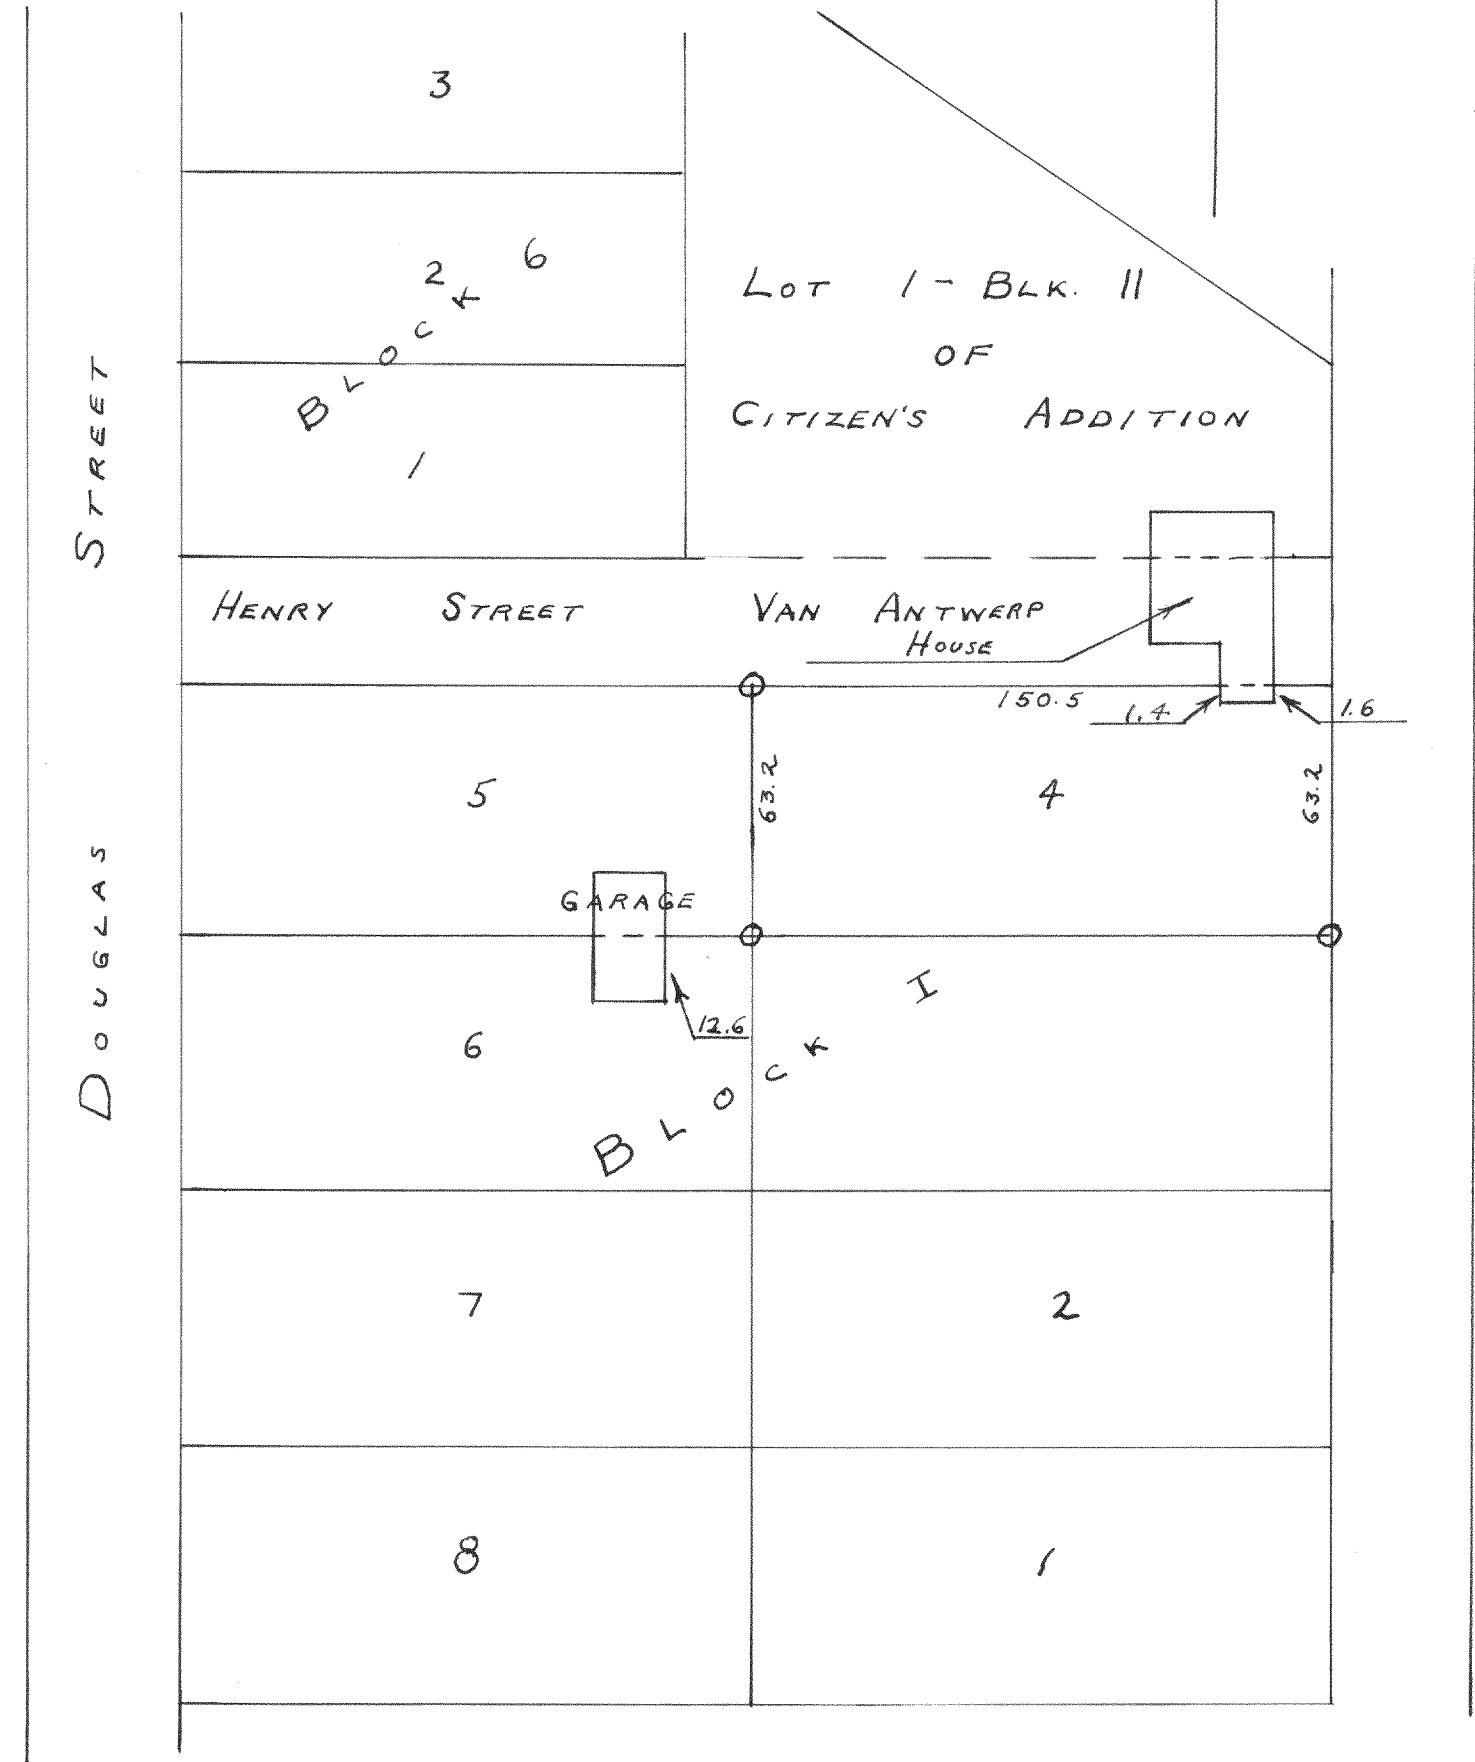

PLAT OF SURVEY OF LOT 4 OF BLOCK I
OF BRIGHAM'S ADDITION AND A DRAWING OF
THE REMAINDER OF BLOCK I AND PART OF
BLOCK 6 OF BRIGHAM'S ADDITION AND A
DRAWING OF LOT 1 OF BLOCK 11 OF
CITIZEN'S ADDITION TO THE VILLAGE OF SHARON

JULY 1951

Lloyd L. Jensen SA
COUNTY SURVEYOR