


644

2589

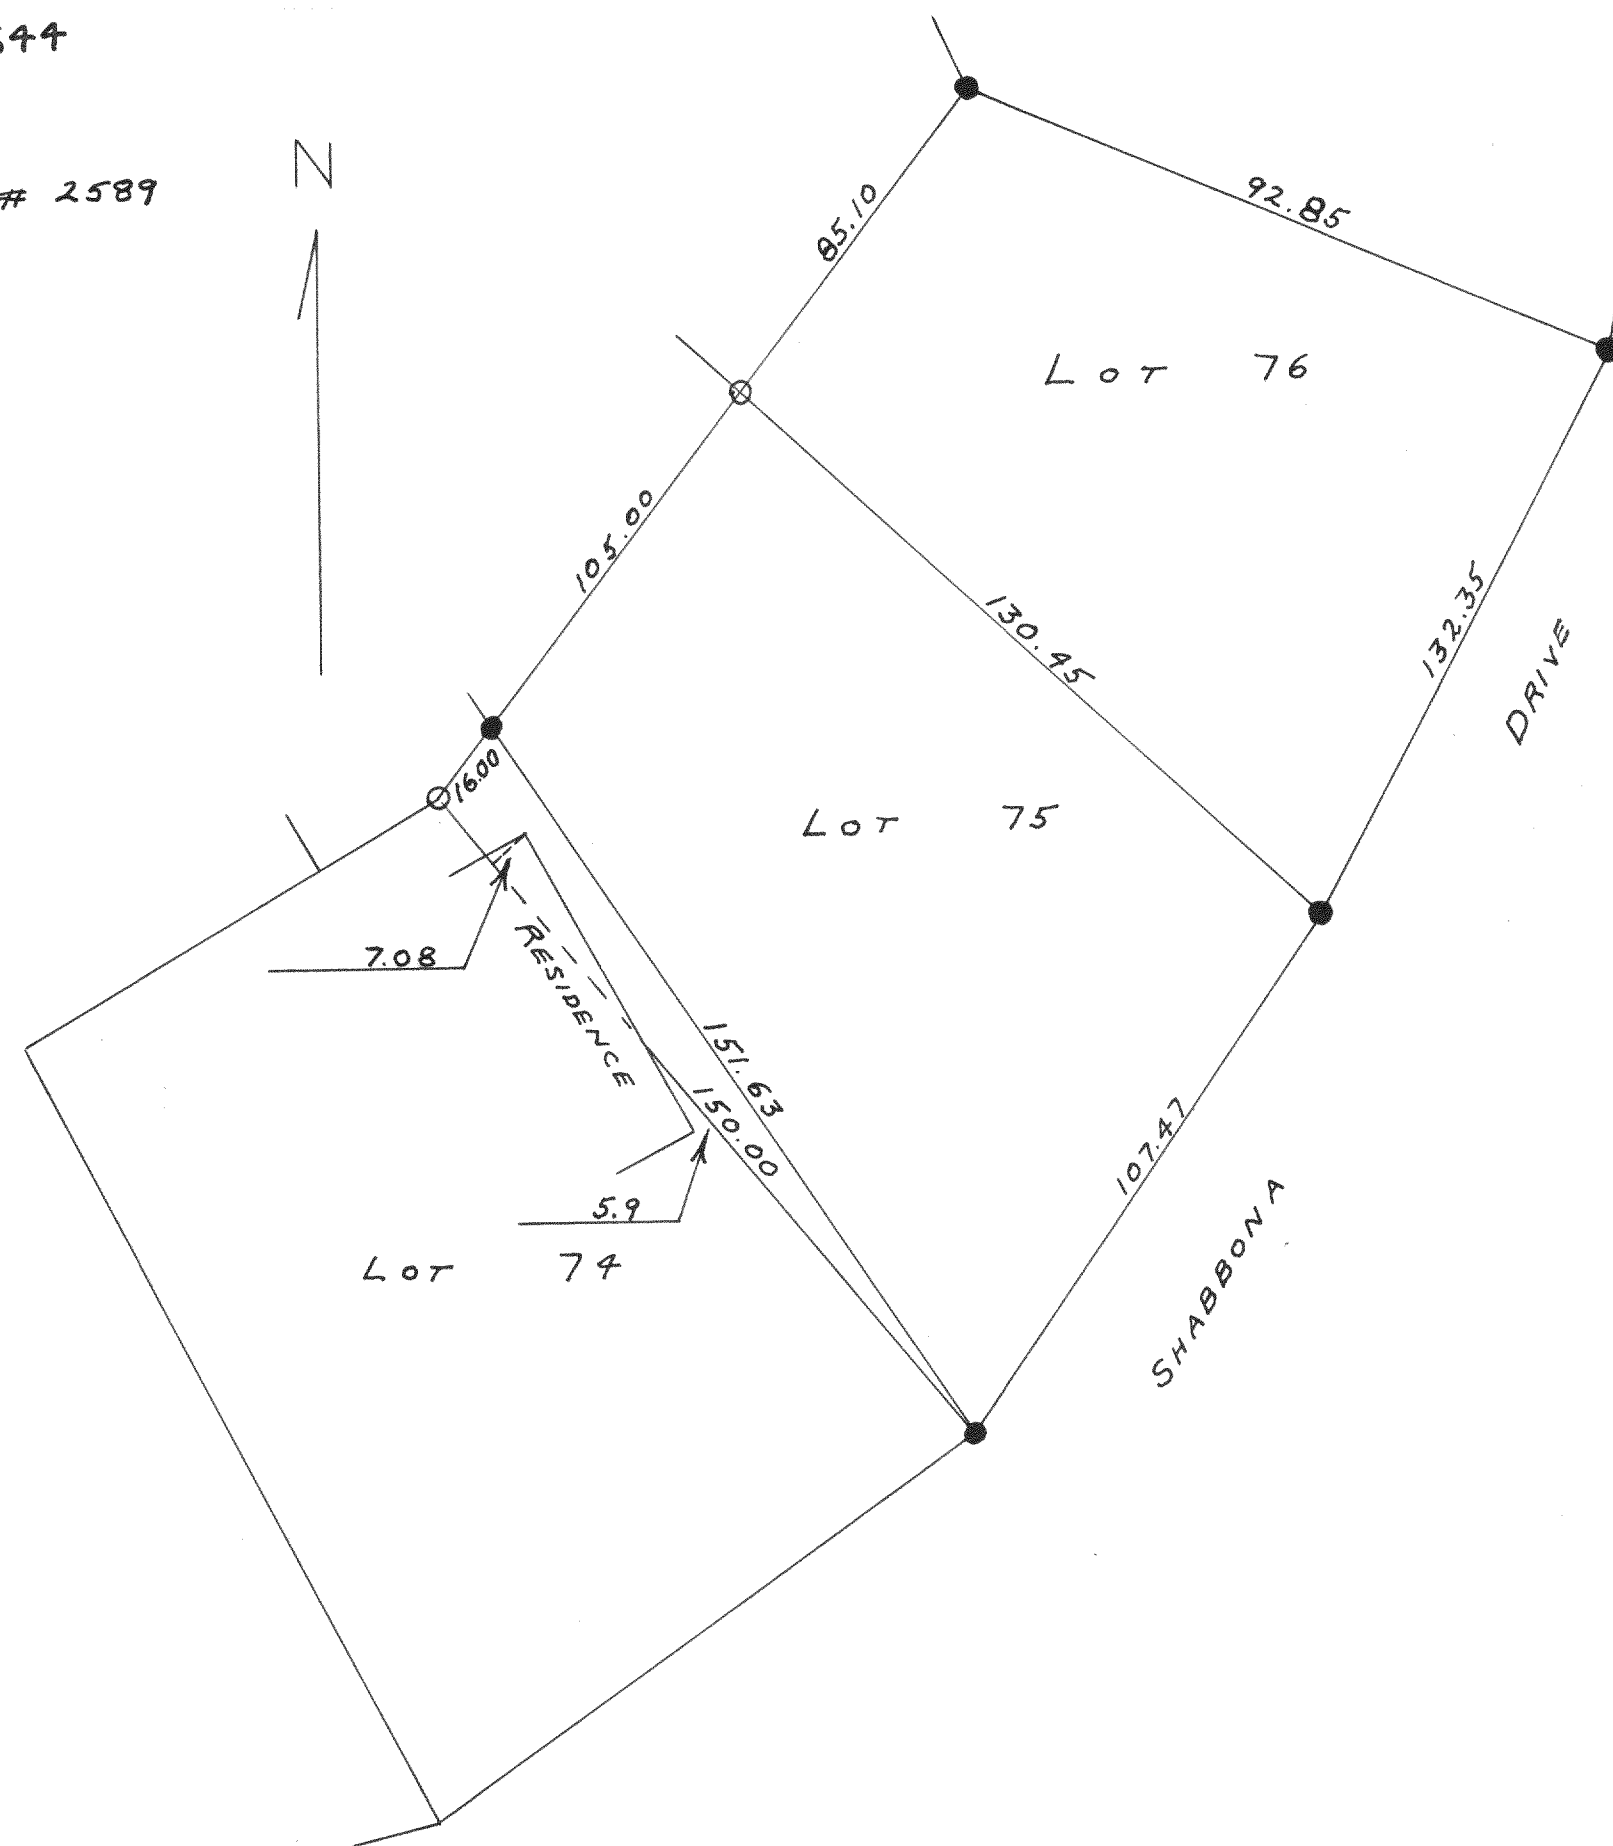


PLAT OF SURVEY OF LOTS 75 AND 76
OF UNIT 2 OF COUNTRY CLUB ESTATES,
LOCATED IN THE VILLAGE OF FONTANA ON
GENEVA LAKE, WALWORTH COUNTY, WISCONSIN.

JUNE 1952

Lloyd L. Jensen SA
COUNTY SURVEYOR

2590

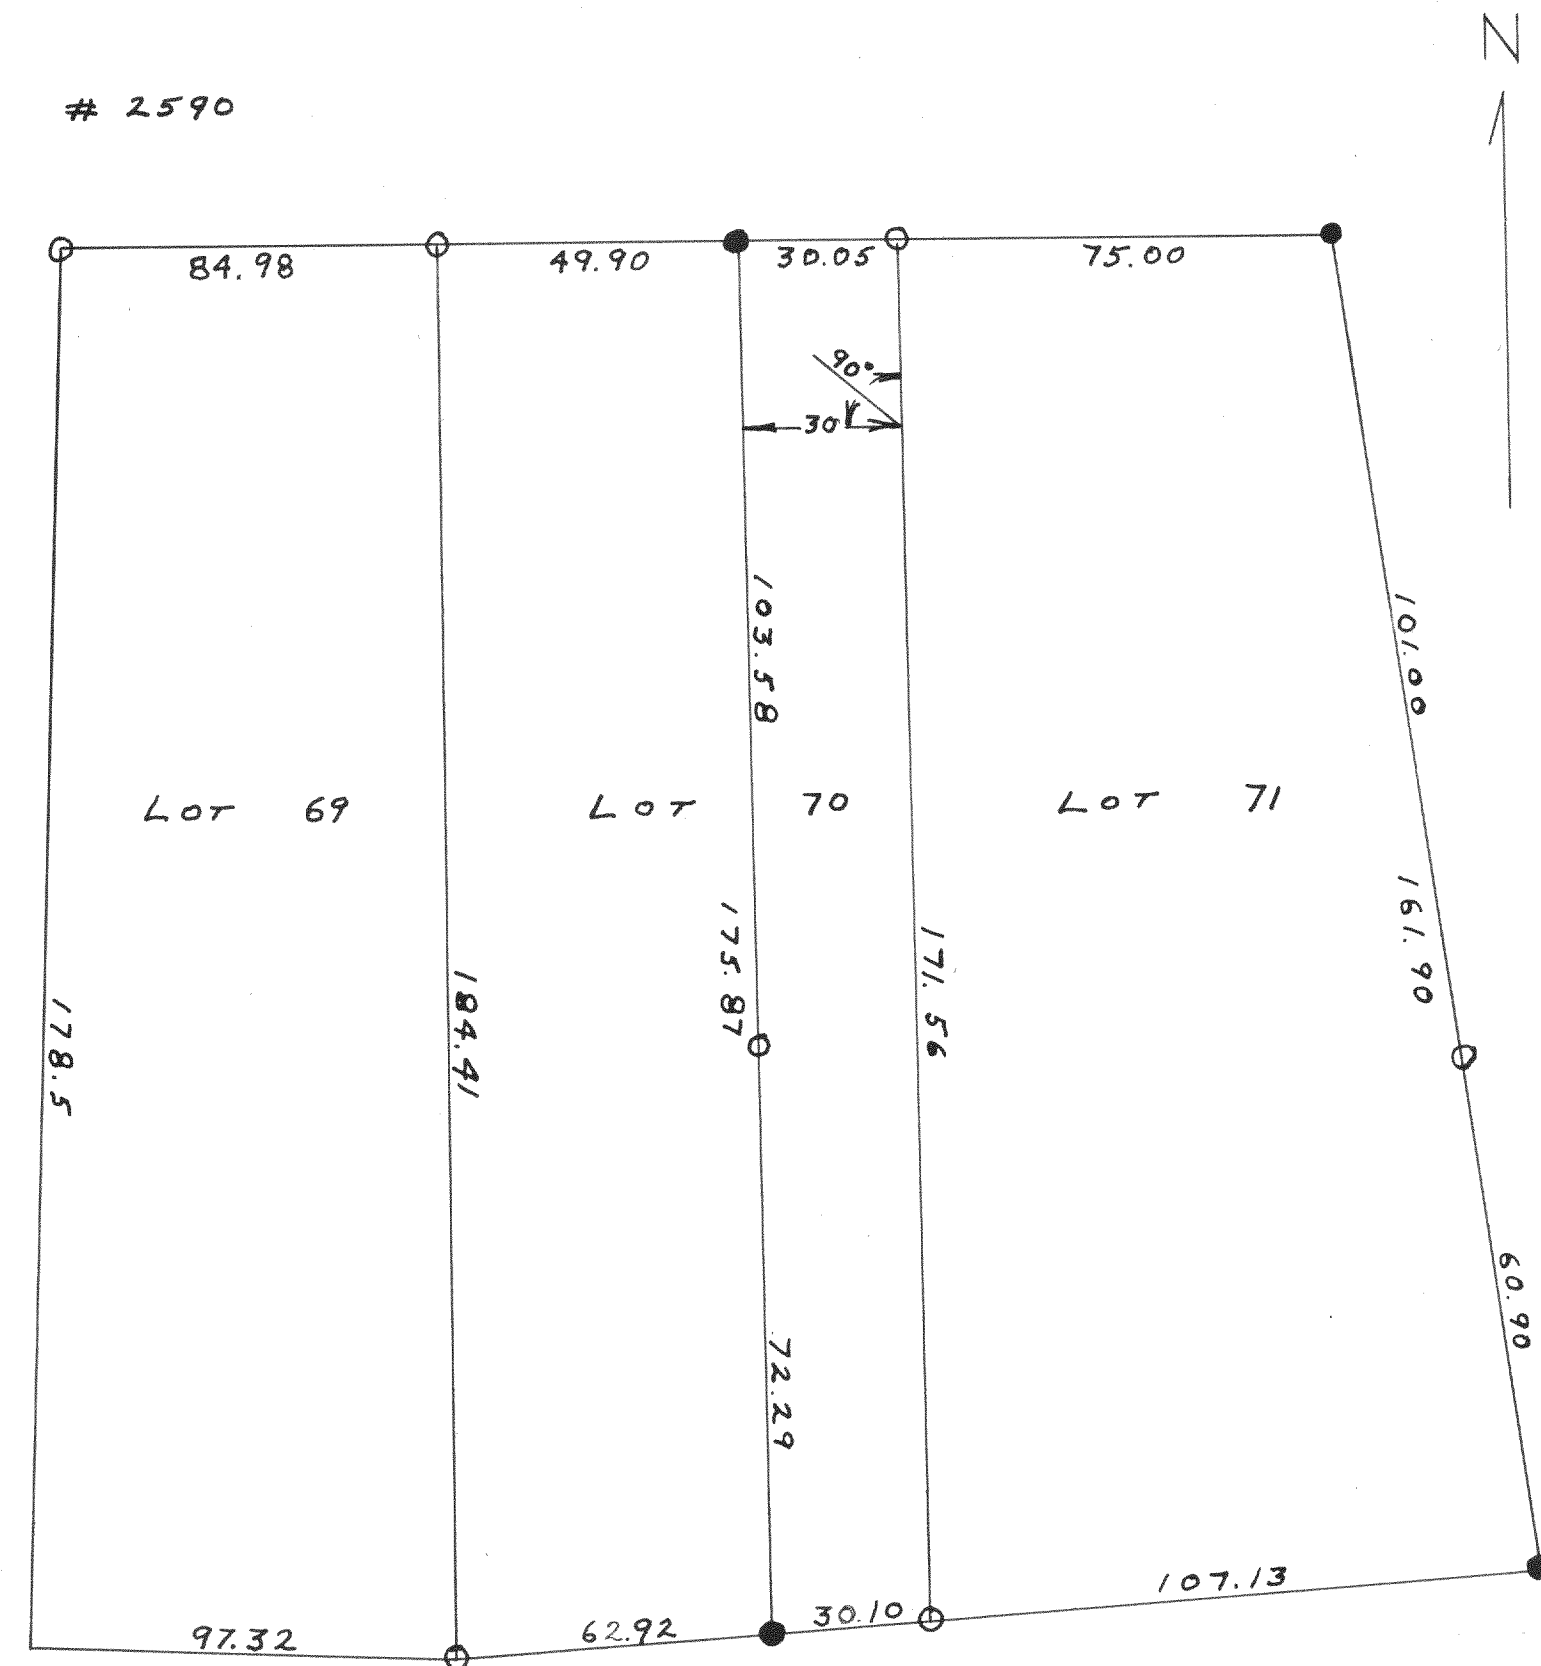

PLAT OF SURVEY OF LOTS 69 THROUGH
71 INCLUSIVE OF UNIT 2 OF COUNTRY
CLUB ESTATES WALWORTH COUNTY, WISCONSIN.

NOVEMBER 6, 1951

Lloyd L. Jensen SA
COUNTY SURVEYOR