



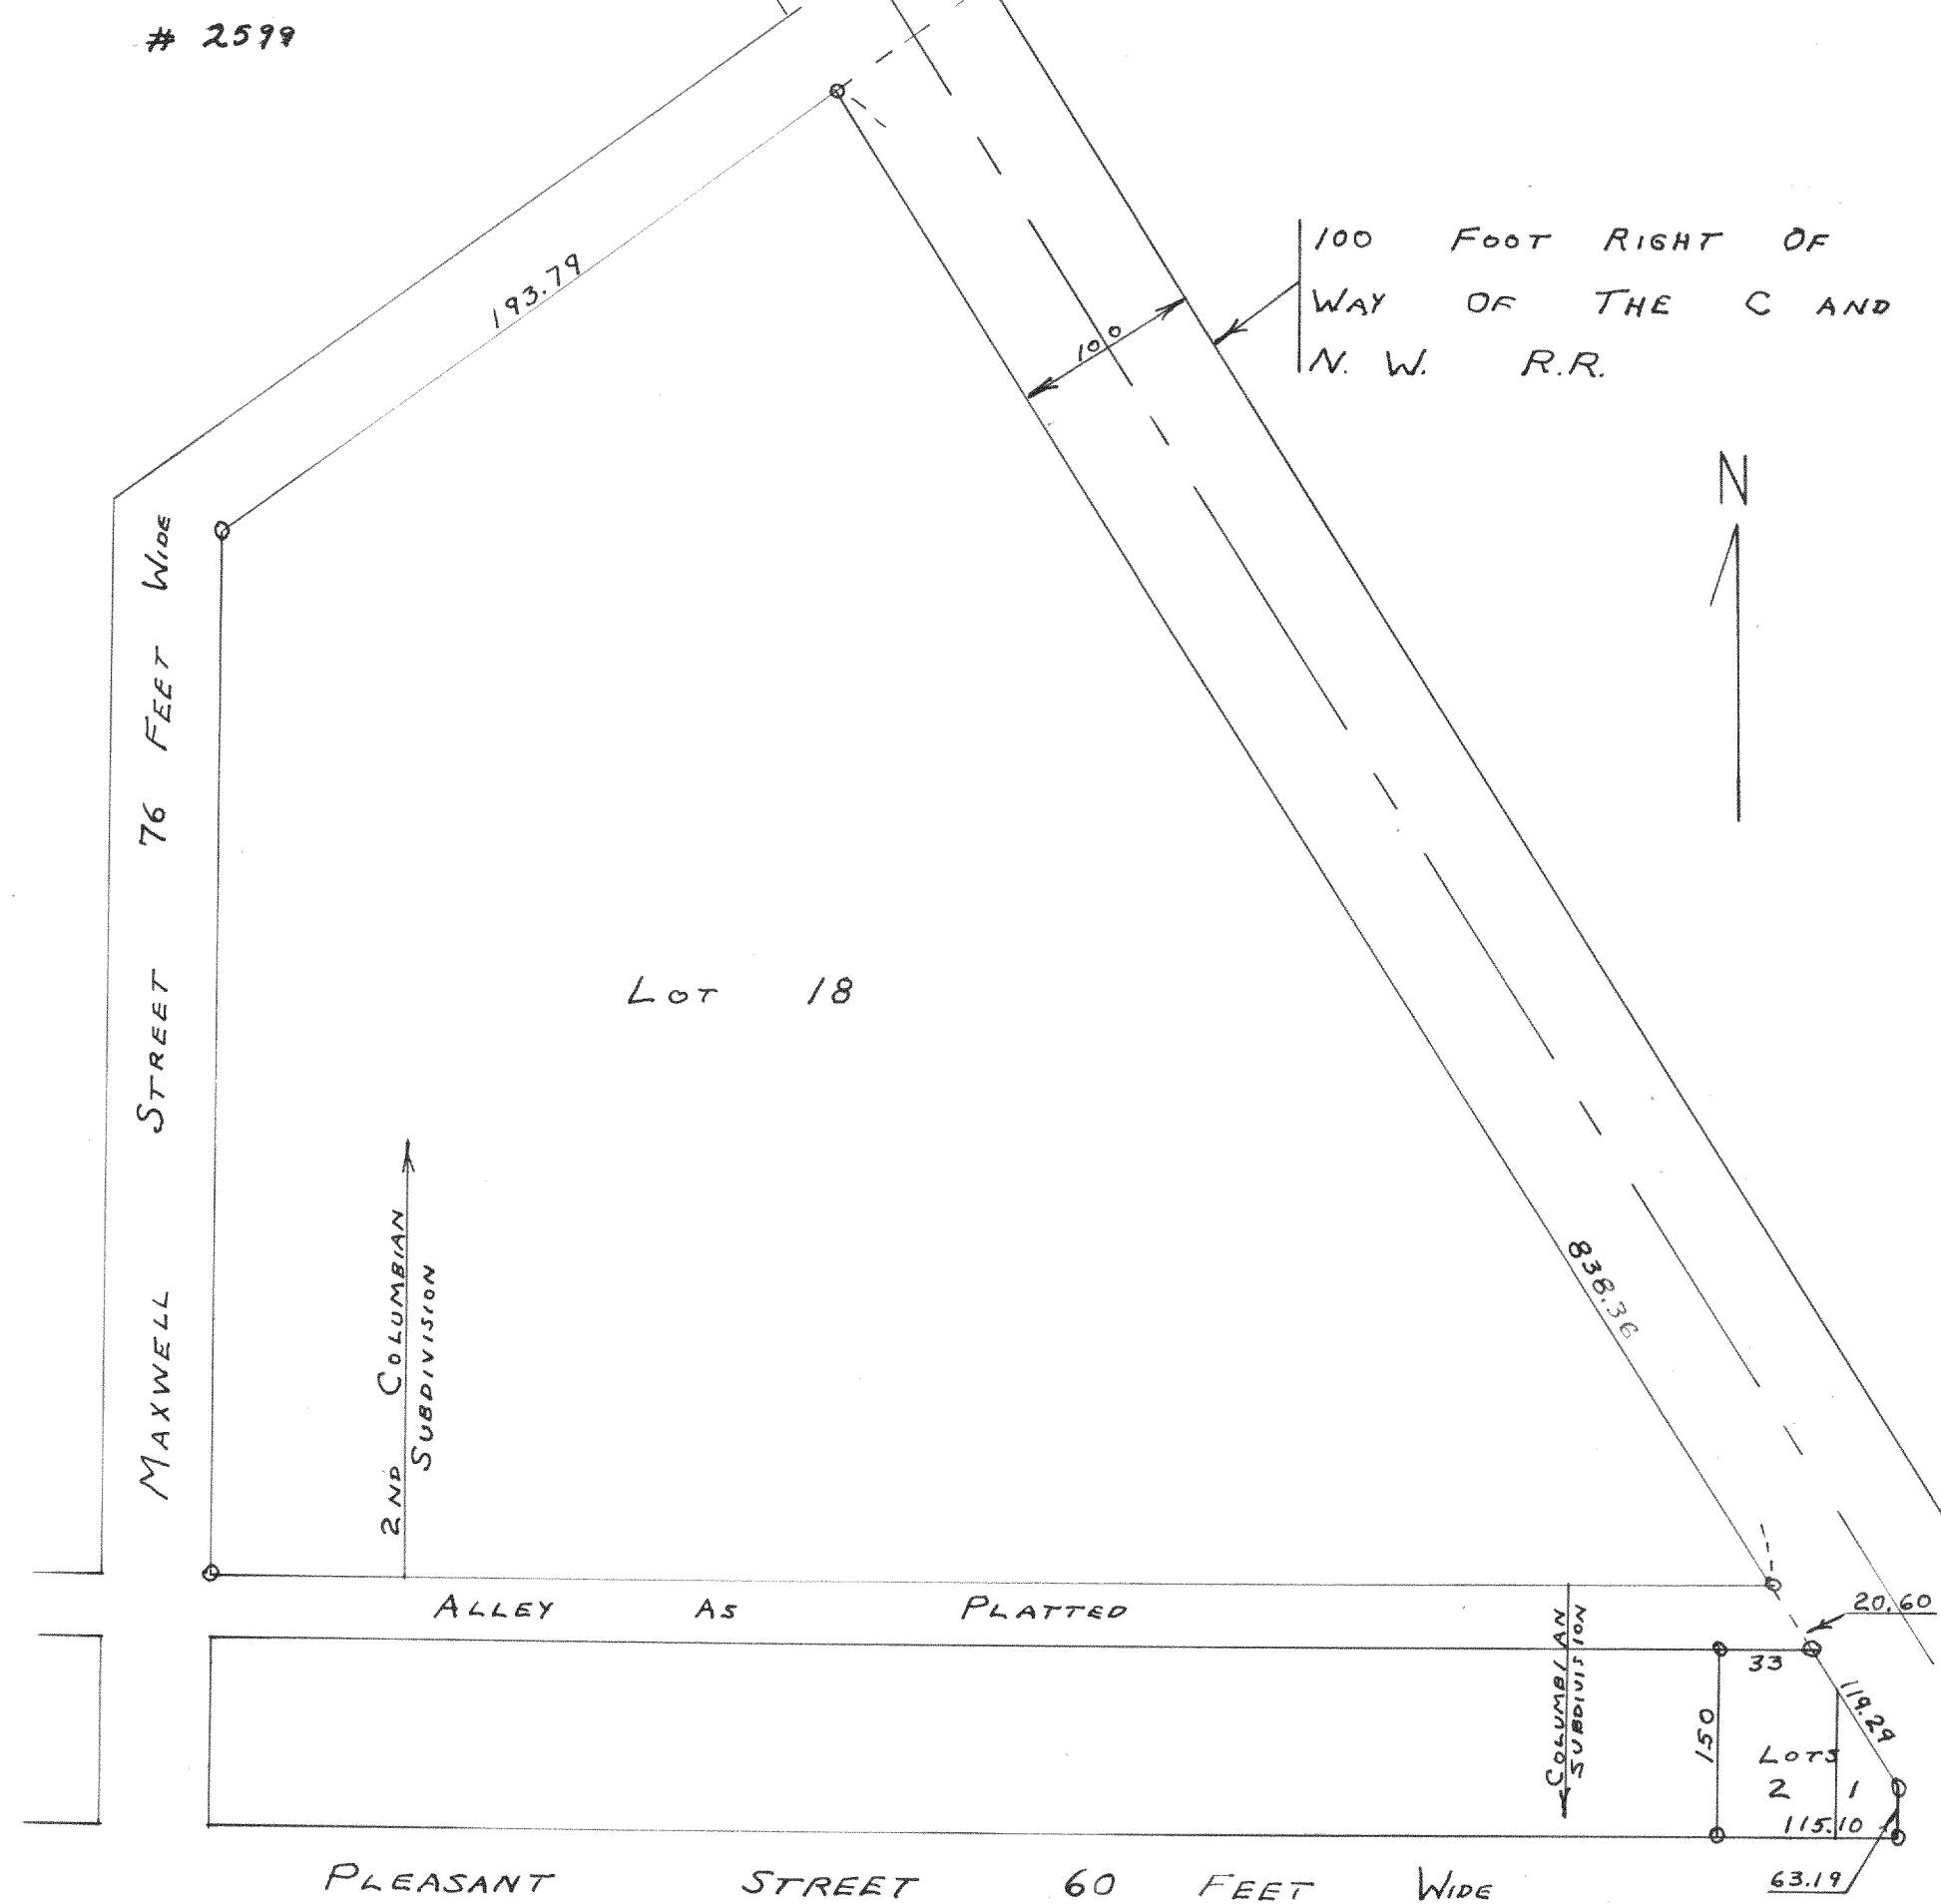

I HEREBY CERTIFY: THAT I HAVE SURVEYED THE LAND SHOWN ON THIS PLAT ACCORDING TO THE OFFICIAL RECORDS, THE DESCRIPTION OF SAID LAND IS AS FOLLOWS: LOT 18 OF 2ND. COLUMBIAN SUBDIVISION AND LOTS 1 AND 2 OF COLUMBIAN SUBDIVISION OF THE CITY OF LAKE GENEVA, WALWORTH COUNTY, WISCONSIN; THAT I HAVE LOCATED ALL BUILDINGS, FENCES AND OTHER IMPROVEMENTS THAT ARE ON THE PROPERTY; THAT THE PLAT SHOWN HEREON IS A CORRECT REPRESENTATION OF THE LOT LINES AND THE PRINCIPAL LINES OF ALL BUILDINGS AND OTHER IMPROVEMENTS THEREON.

JUNE 1952

Lloyd L. Jensen SA
COUNTY SURVEYOR

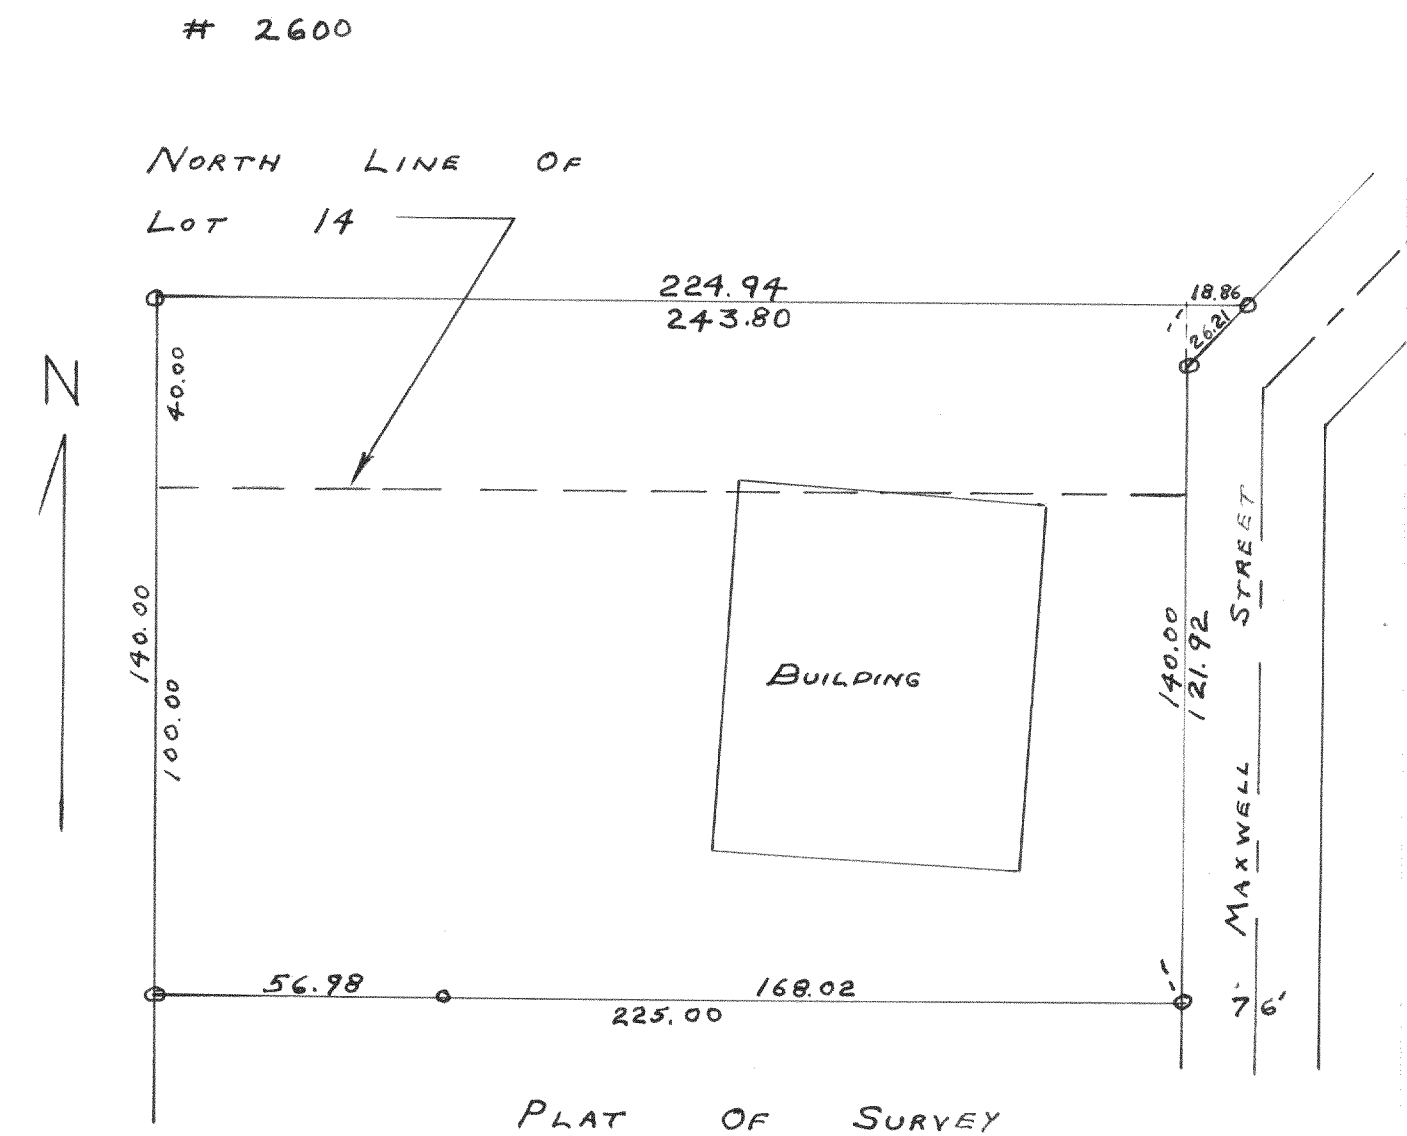

DESCRIPTION:

THE NORTH 100 FEET OF THE EAST $\frac{1}{2}$ OF LOTS 13 AND 14 OF 2ND. COLUMBIAN SUBDIVISION.

THE SOUTH 40 FEET OF THE EAST $\frac{1}{2}$ OF LOT 15 AND SO MUCH OF LOT 17 AS IS SOUTH OF THE NORTHERLY LINE OF SAID SOUTH 40 FEET OF THE EAST $\frac{1}{2}$ OF LOT 15 WHEN SAID LINE IS CONTINUED EASTERLY TO MAXWELL STREET, IN 2ND COLUMBIAN SUBDIVISION, LOCATED IN THE CITY OF LAKE GENEVA, WALWORTH COUNTY, WISCONSIN.

I, LLOYD L. JENSEN HEREBY CERTIFY THAT I SURVEYED THE ABOVE DESCRIBED PROPERTY ON AUGUST 27, 1952 ACCORDING TO THE OFFICIAL RECORDS AND THAT THE ABOVE PLAT IS A TRUE REPRESENTATION OF THE BOUNDARY LINES THEREOF, AND THE PRINCIPAL LINES OF PRESENT BUILDINGS THEREON.

Lloyd L. Jensen SA
COUNTY SURVEYOR