


658

2616

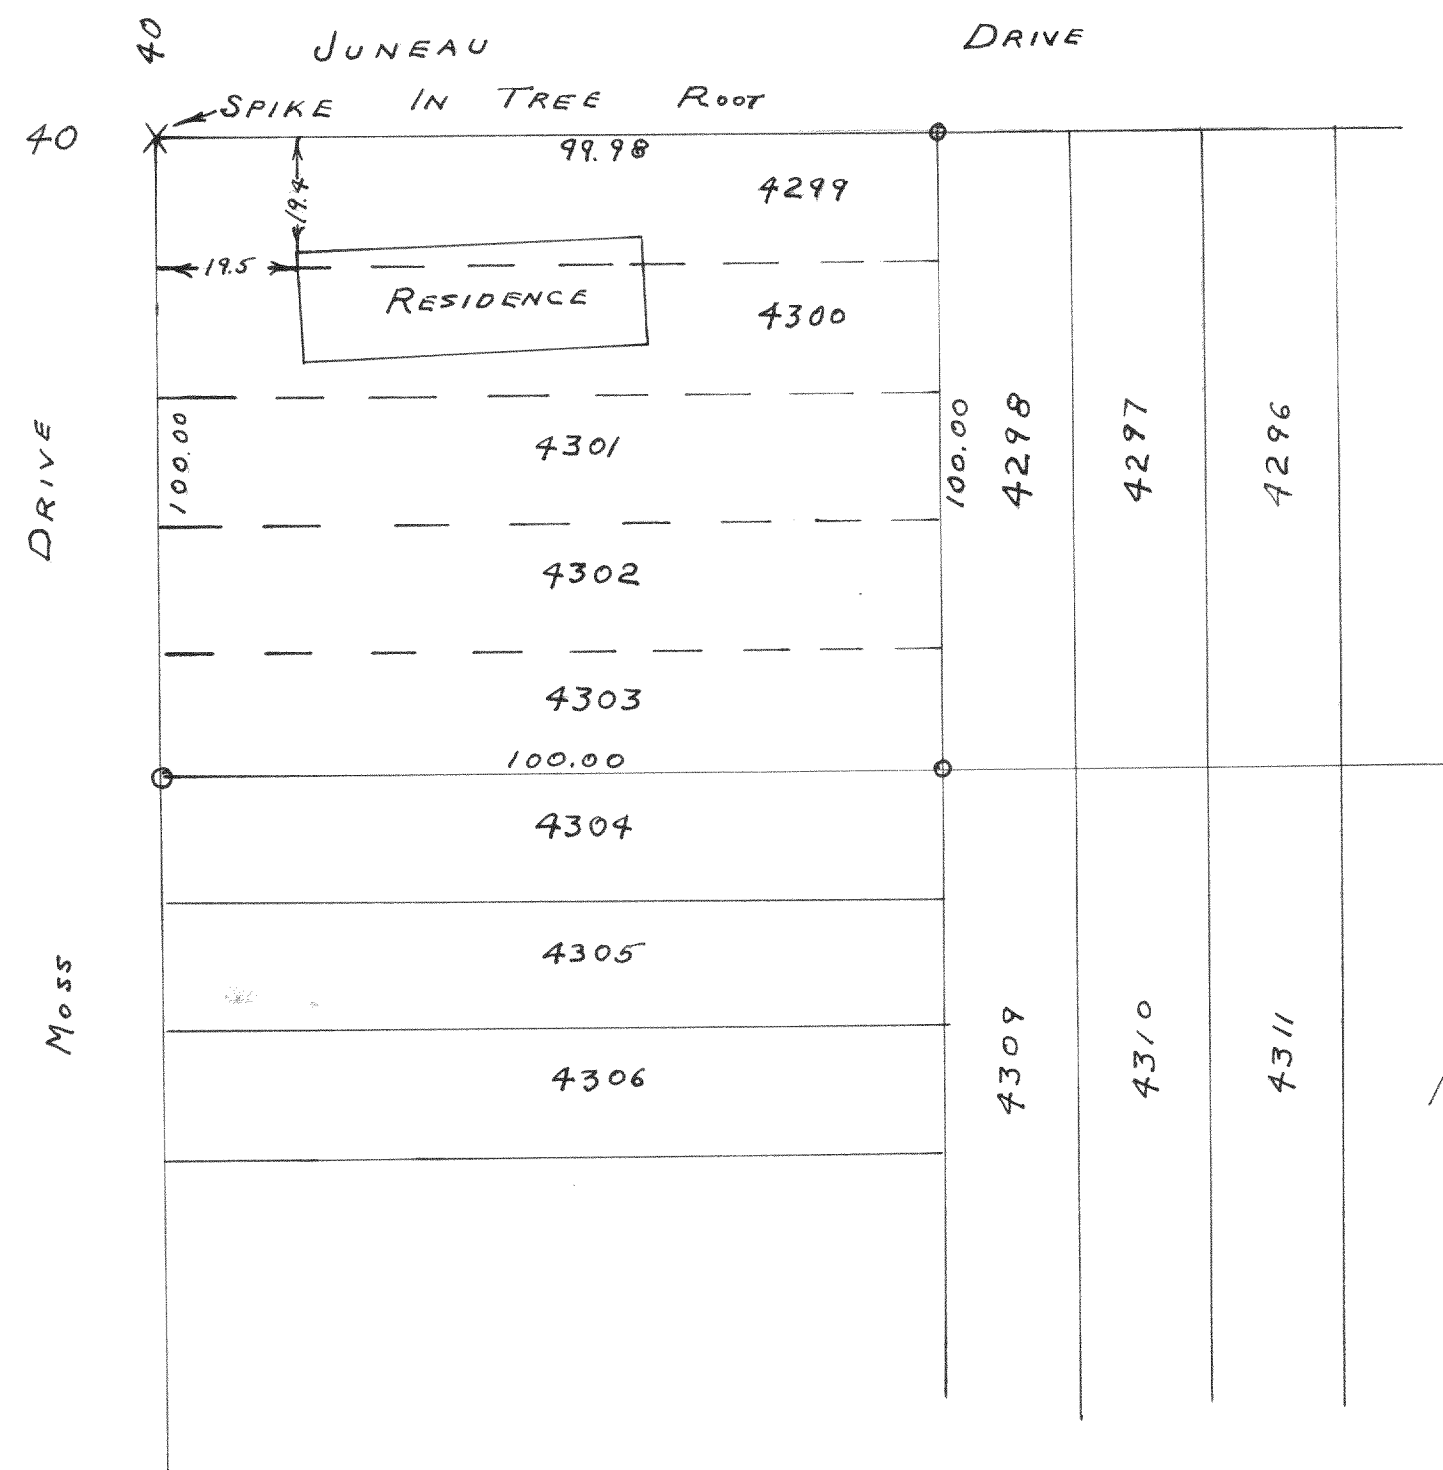


PLAT OF SURVEY OF LOTS 4299 TO
4306 INCLUSIVE BLOCK 85 PELL
LAKE SUBDIVISION, WALWORTH COUNTY,
WISCONSIN.

JULY 1952

Lloyd L. Jensen SA
COUNTY SURVEYOR

2617

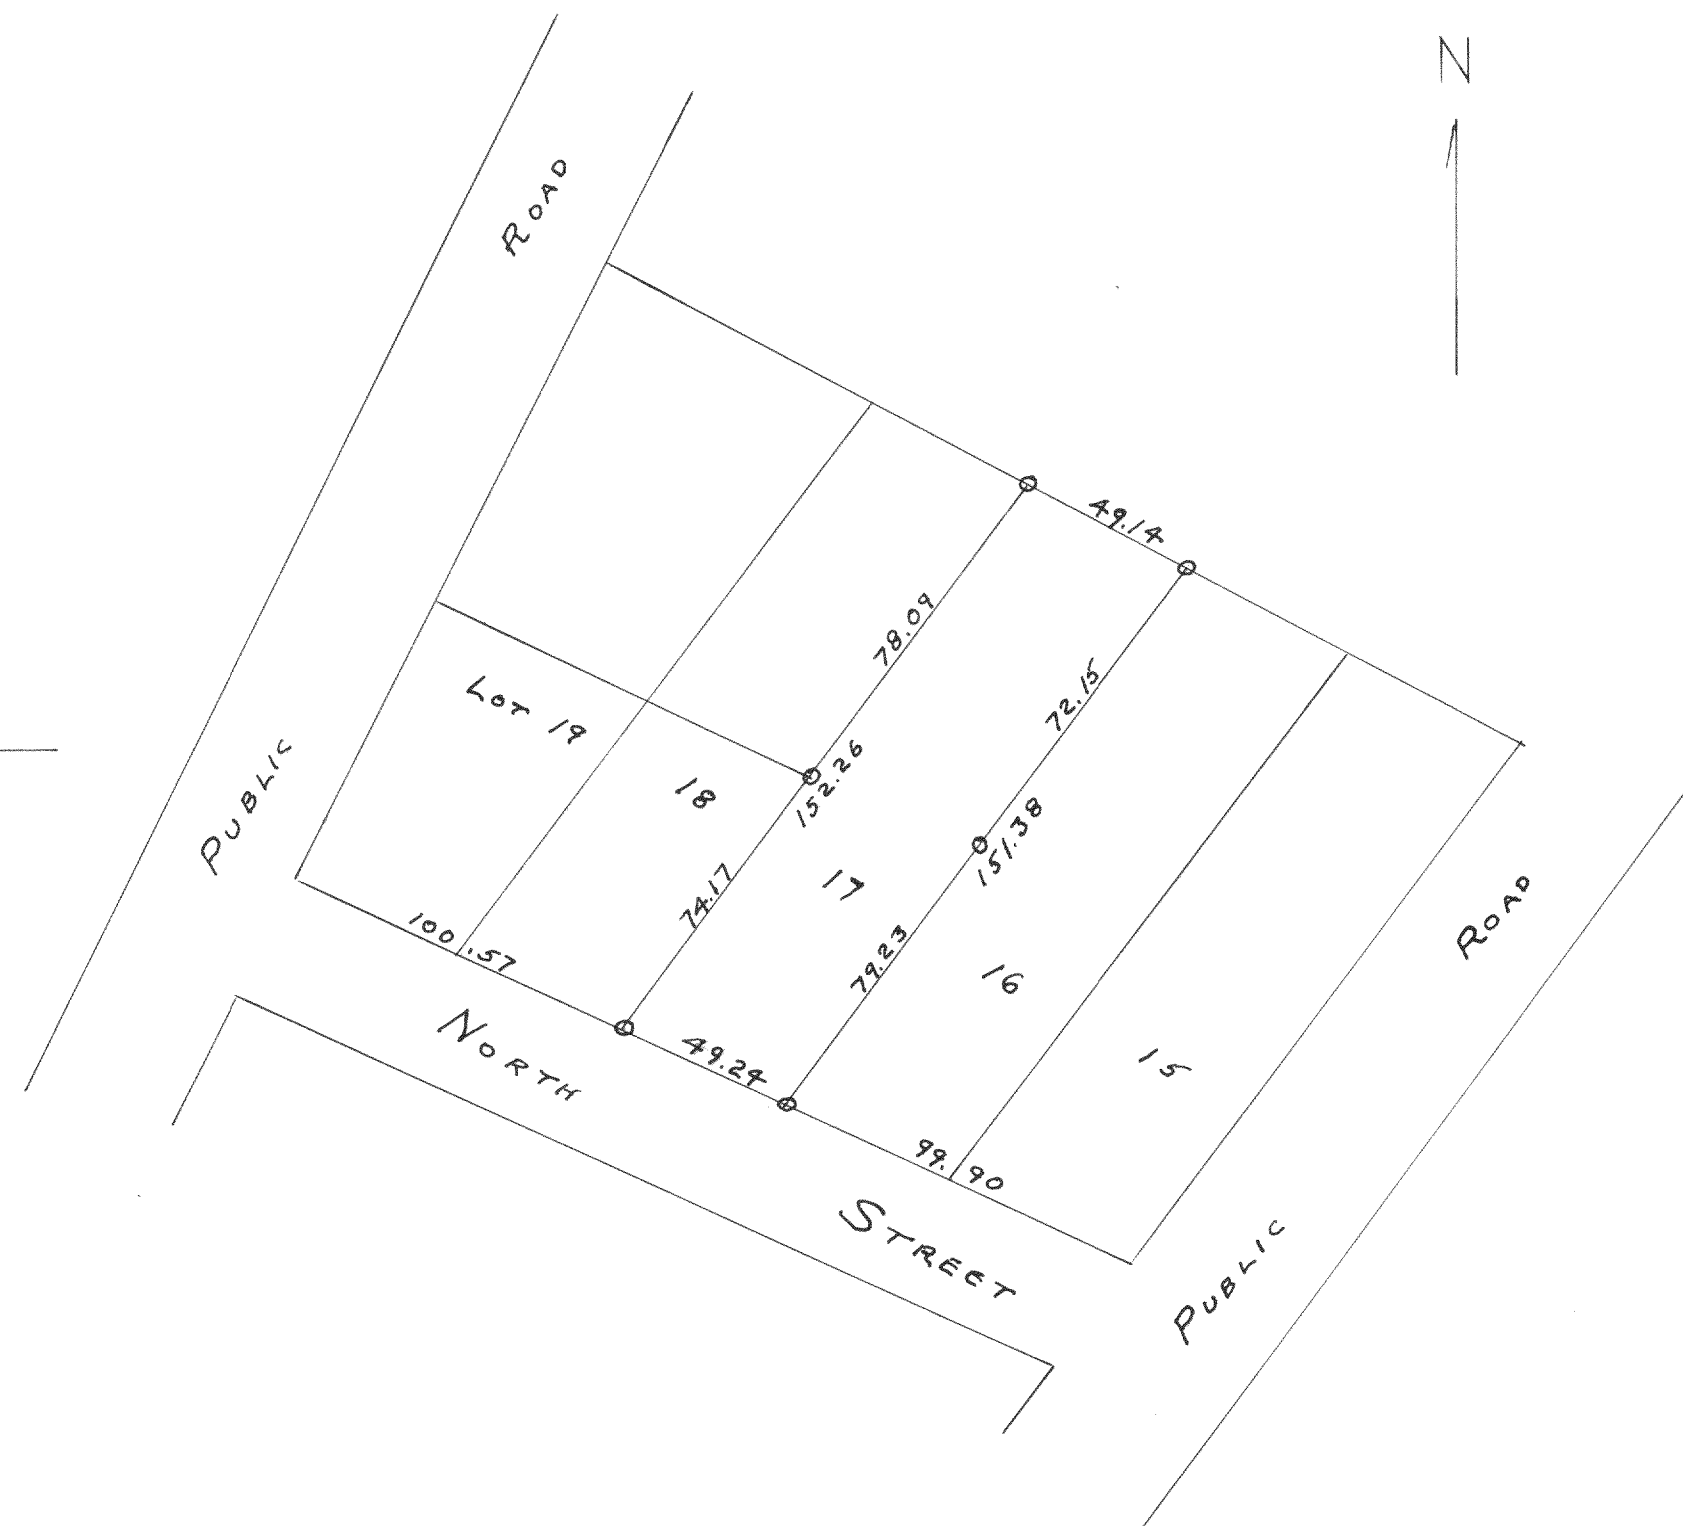

PLAT OF A SURVEY OF LOT 17 OF
WILLIAM ELLIOTT'S POWERS LAKE SUBDIVISION
LOCATED IN THE NORTHEAST $\frac{1}{4}$ OF SECTION
13, T1N, R18E OF WALWORTH COUNTY, WISCONSIN.

JULY 1952

Lloyd L. Jensen SA
COUNTY SURVEYOR