


#1301

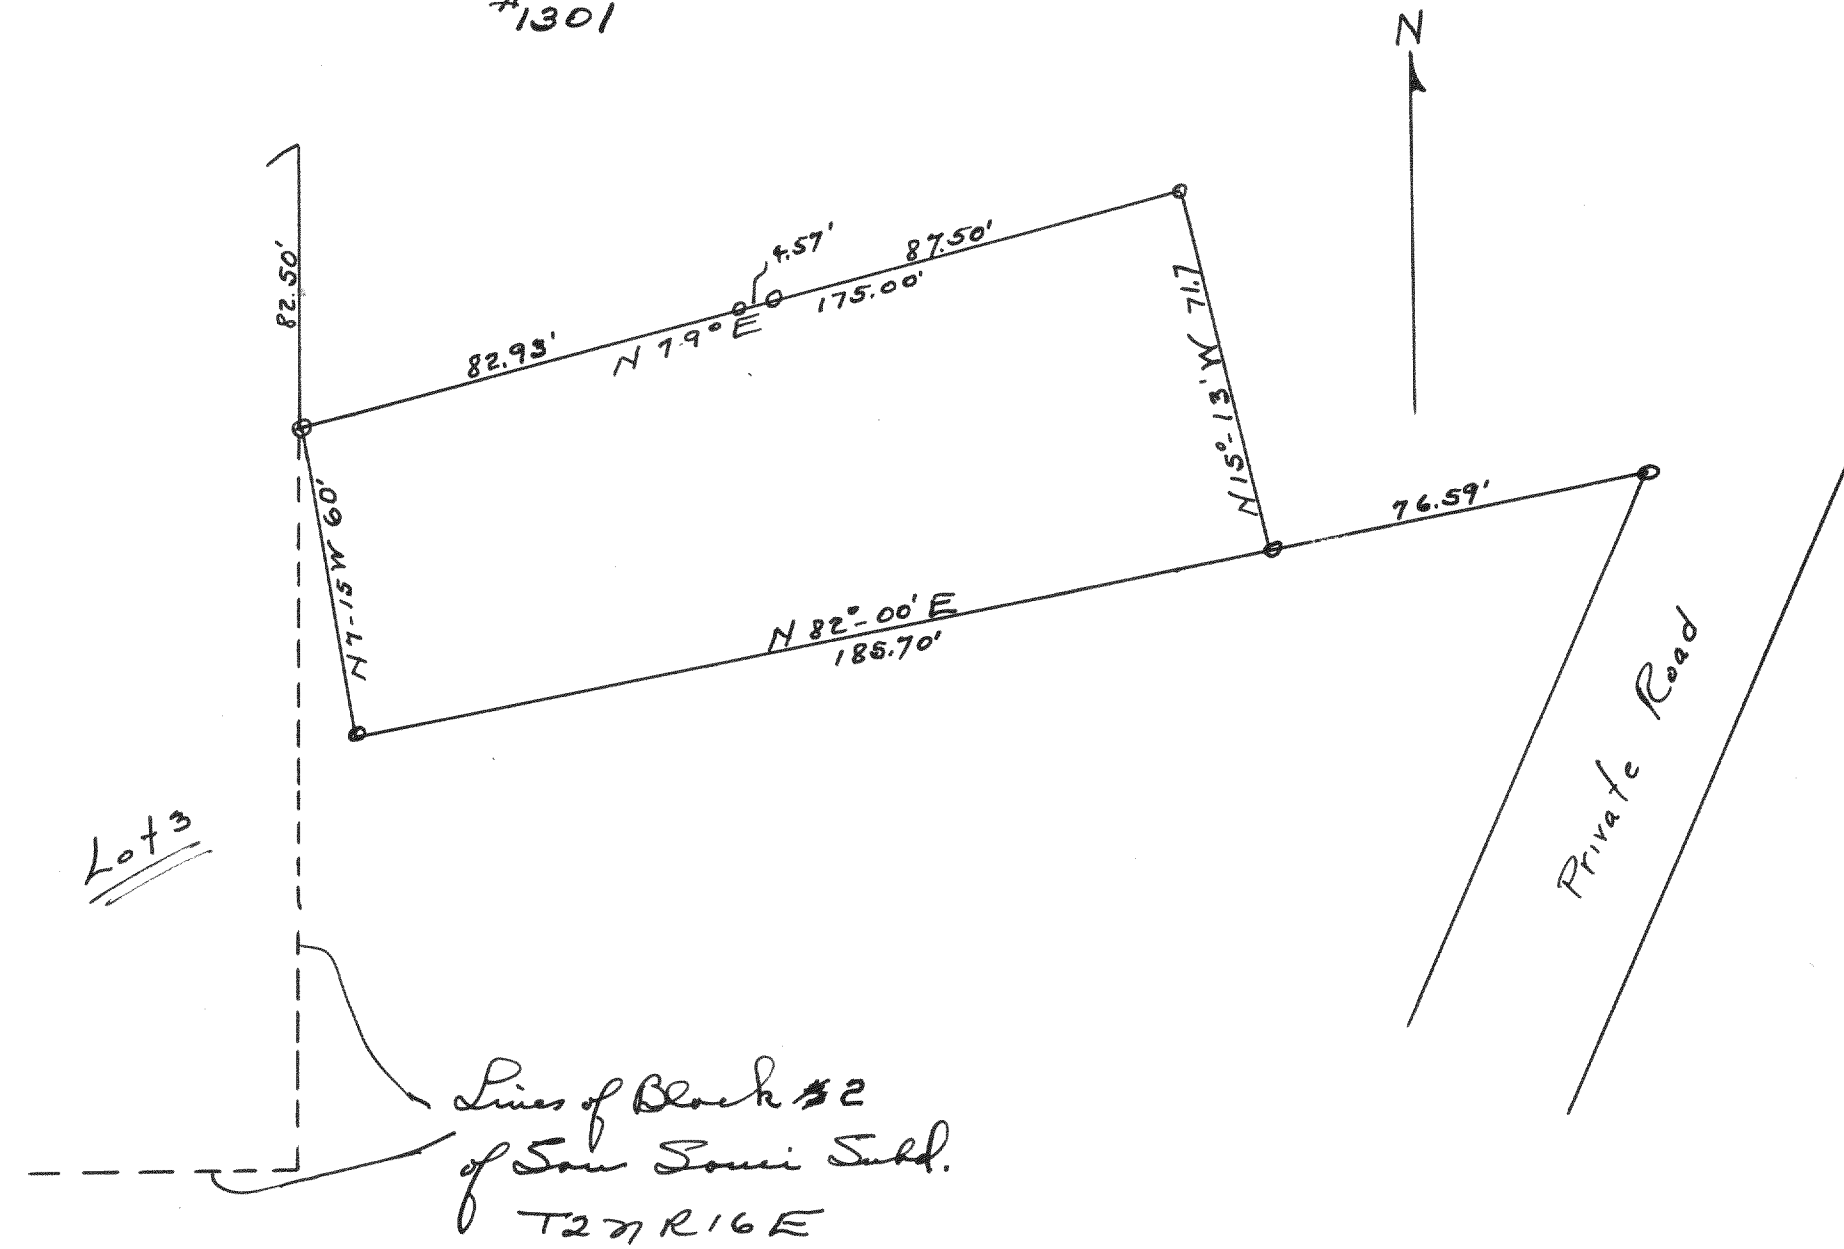


Plot of survey of land purchased
by Mrs. Lillian Anderson in 1942.

Aug. 1942

Lloyd L. Fusan
County Surveyor

#1302

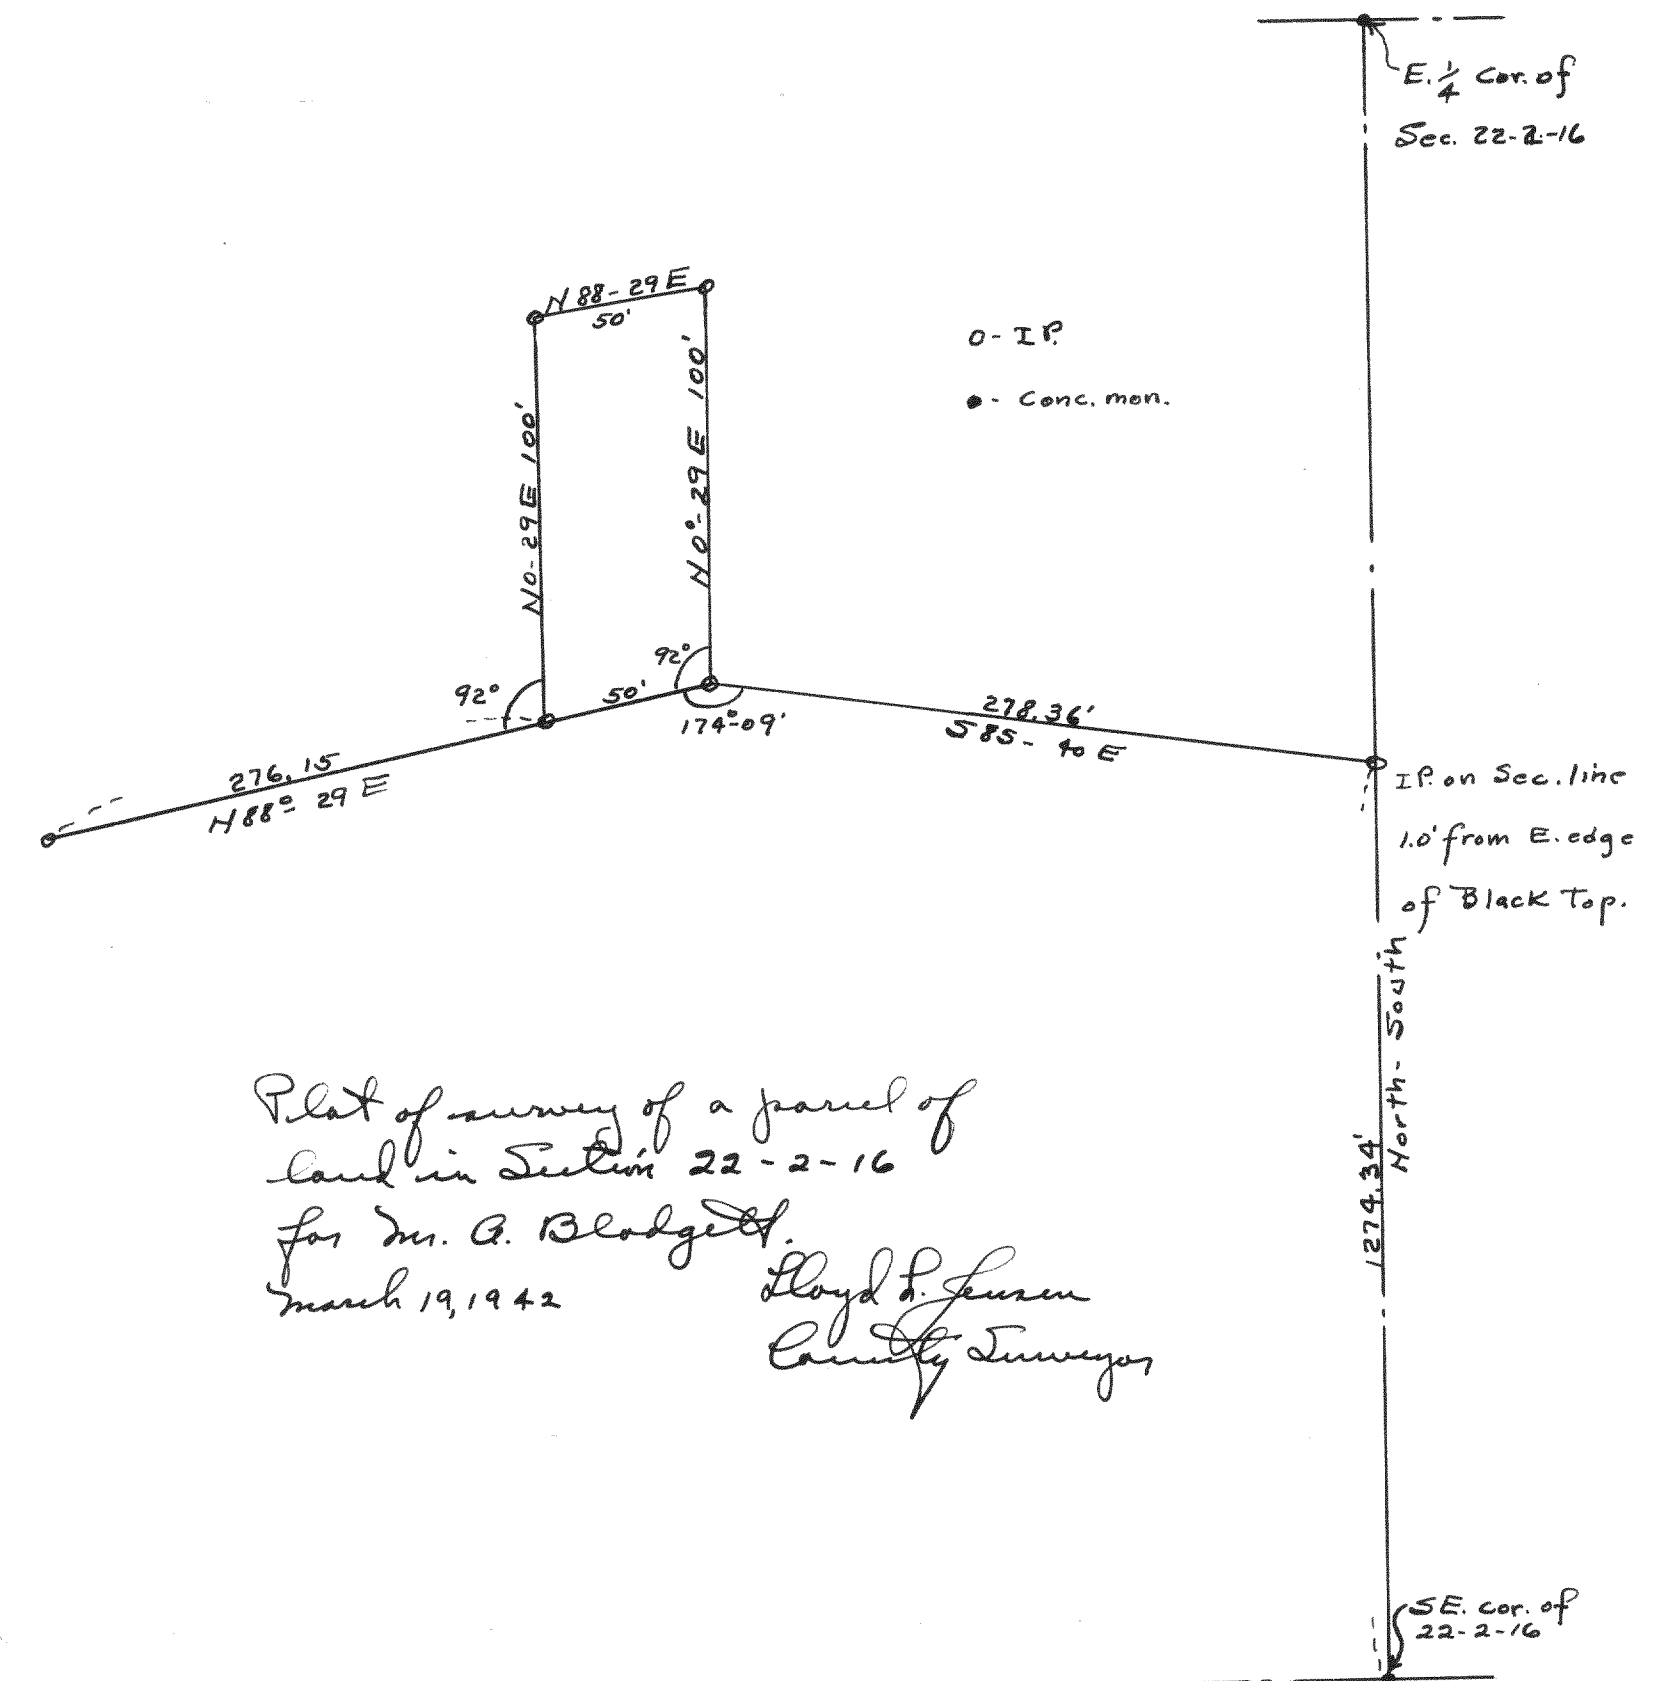

Plot of survey of a parcel of
land in Section 22-2-16
for Mrs. A. Blodgett.

March 19, 1942

Lloyd S. Jensen
County Surveyor