


#1306

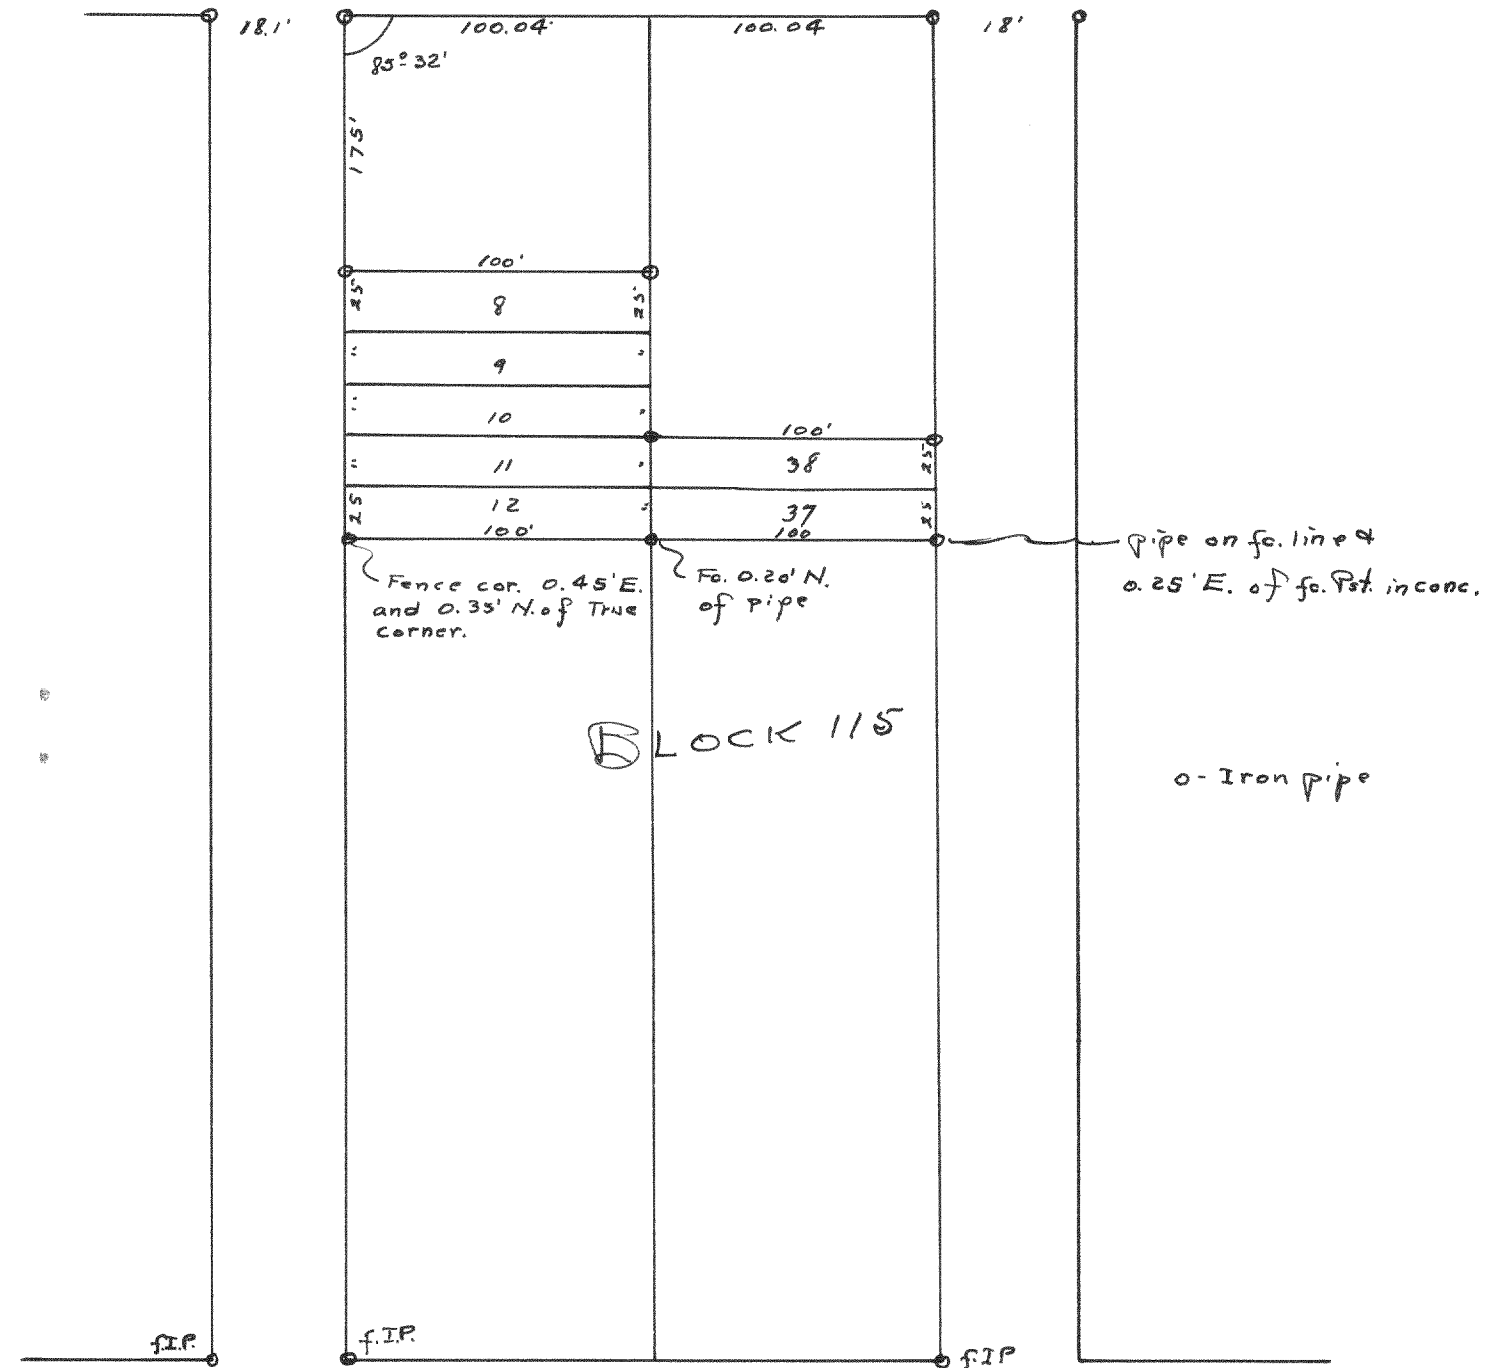


Plot of survey of Lots 8, 9, 10, 11, 12, 37 & 38 of Block 115 of Lake Wandauega Subdivision.

July 6, 1942

Lloyd L. Jensen
County Surveyor

#1307

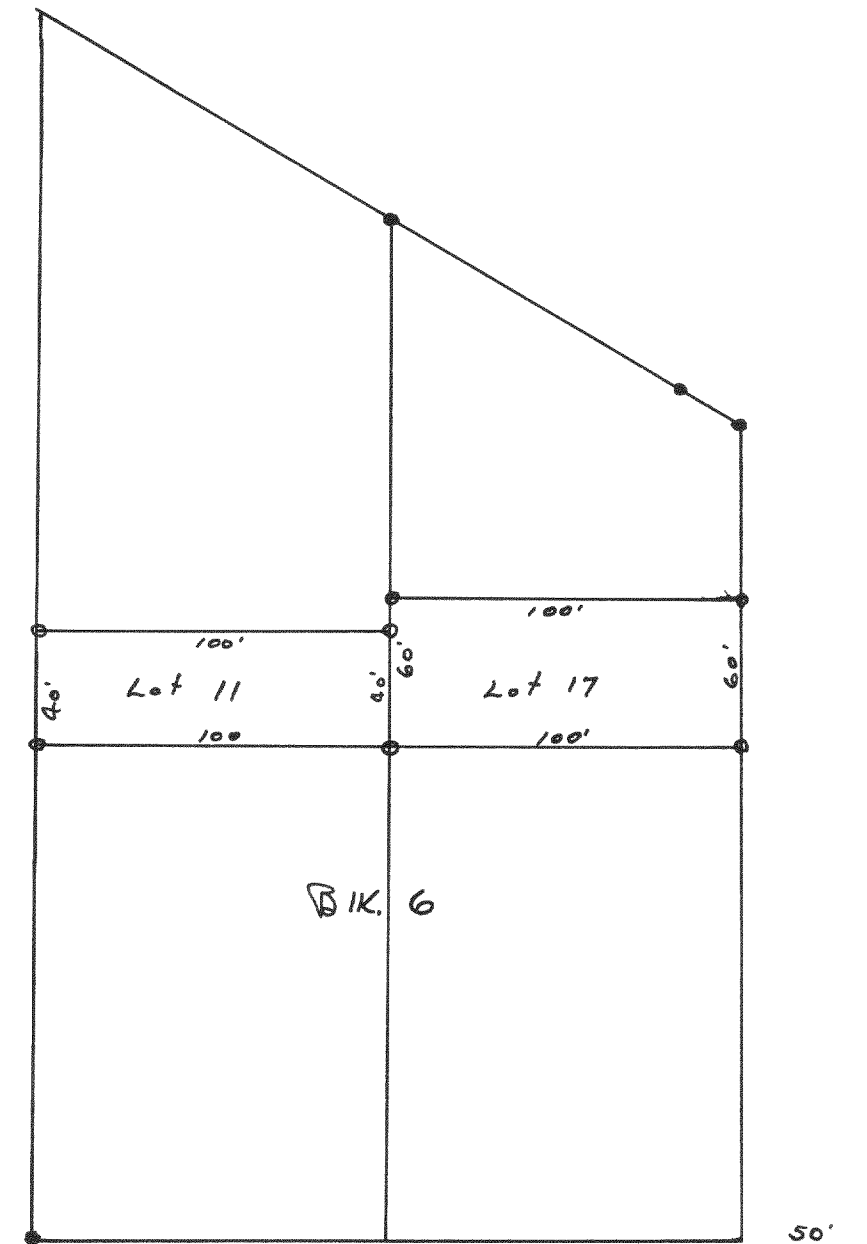

Plot of survey of Lots 11 & 17 of Block 6 of Dutelsken Subd. Section I.

June 1942

Lloyd L. Jensen