

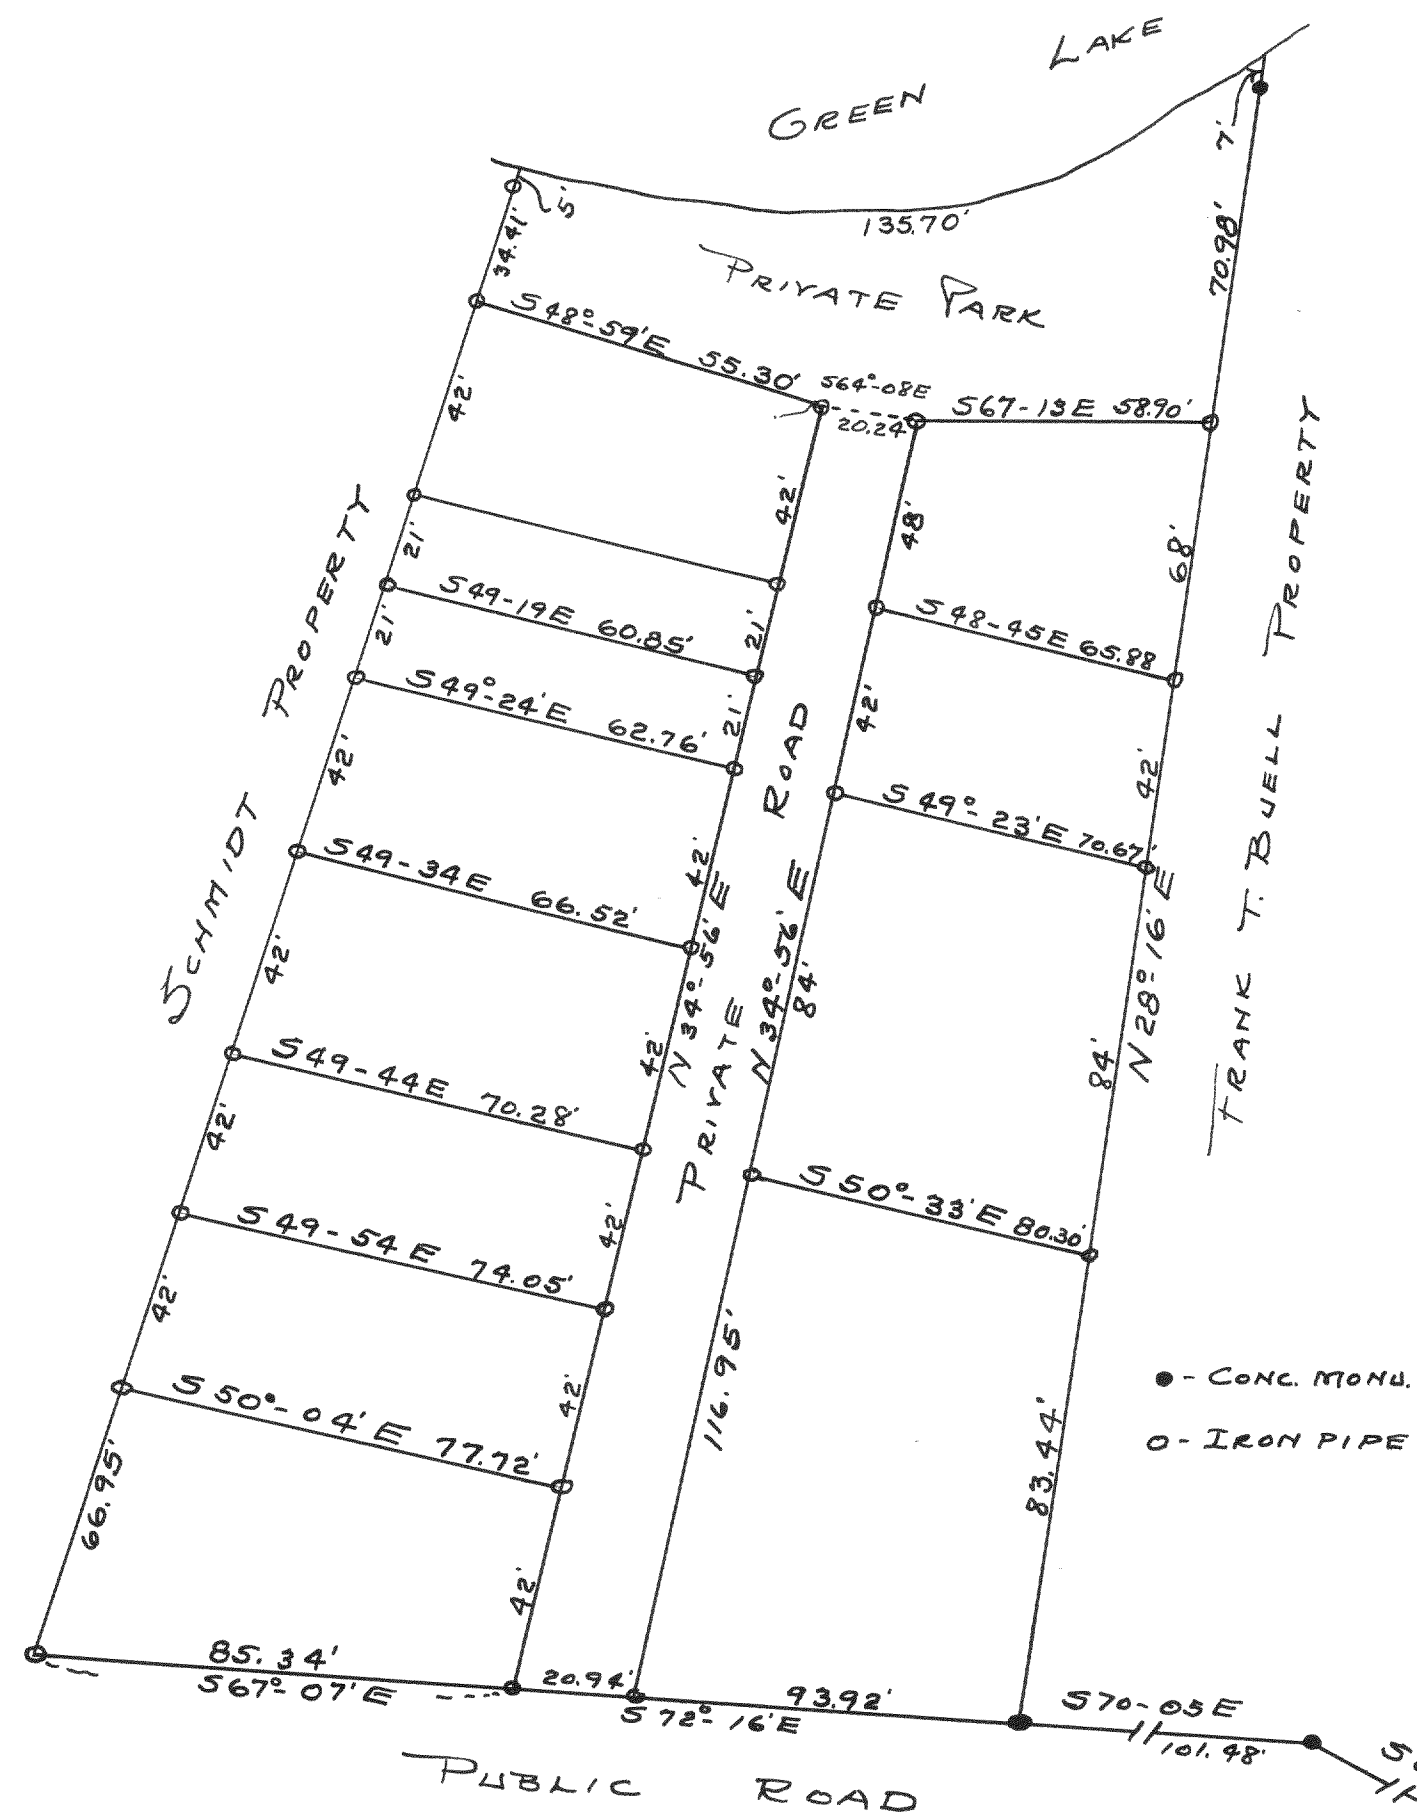


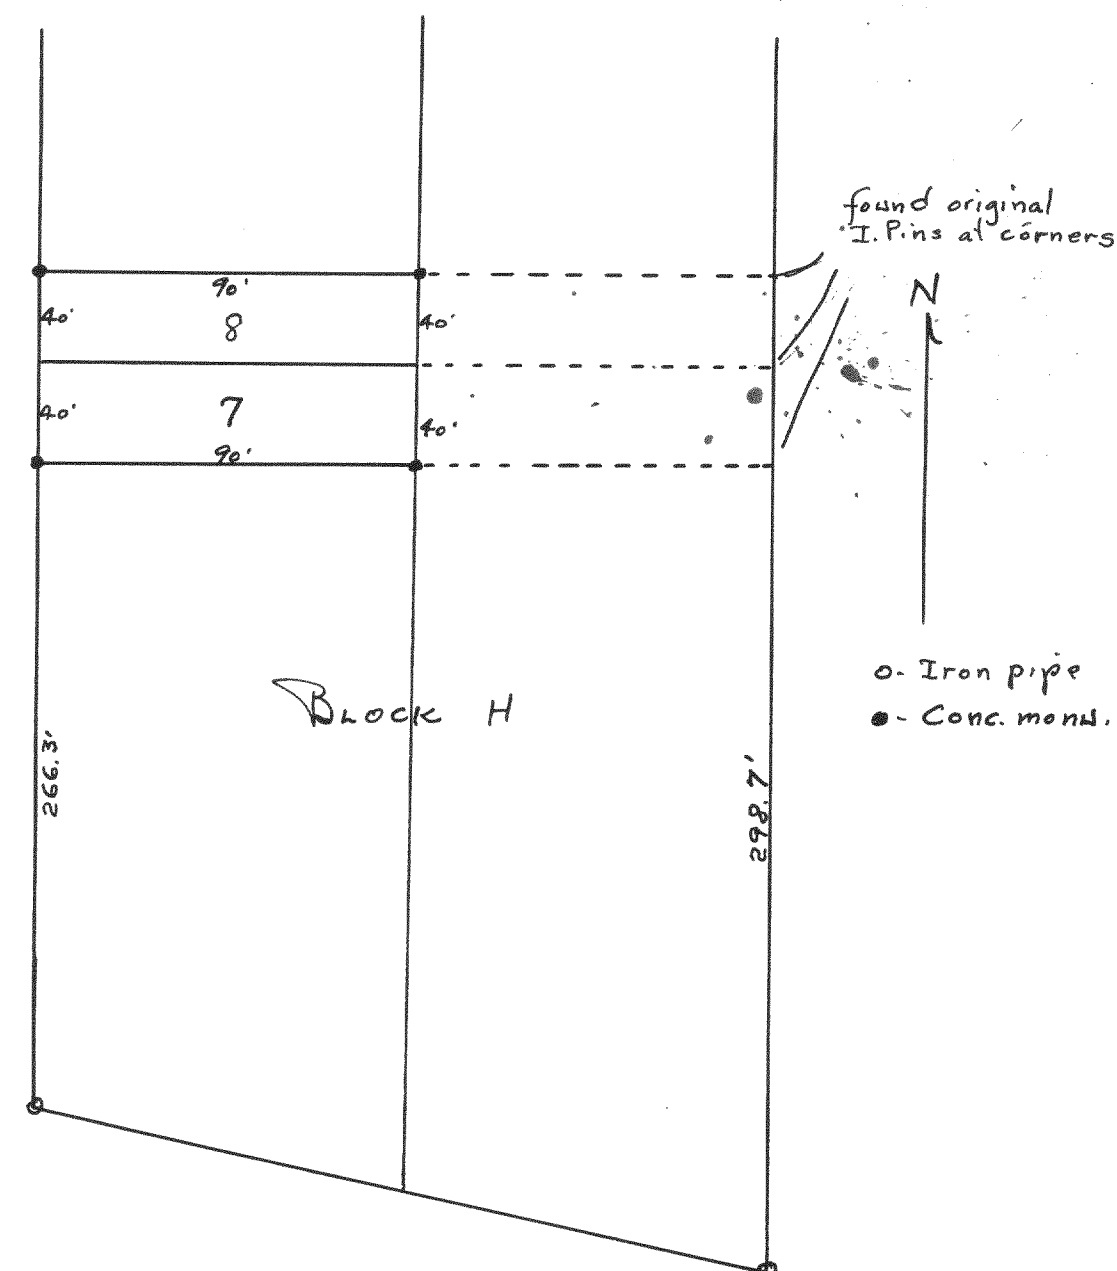

Plot of survey of land formerly owned
by Harry W. Loomer which has been divided
into lots, located in the Southwest $\frac{1}{4}$ of
The SW $\frac{1}{4}$ of Fractional Section 26, T4N
R16E.

Nov. 1942

Lloyd L. Jensen
County Surveyor

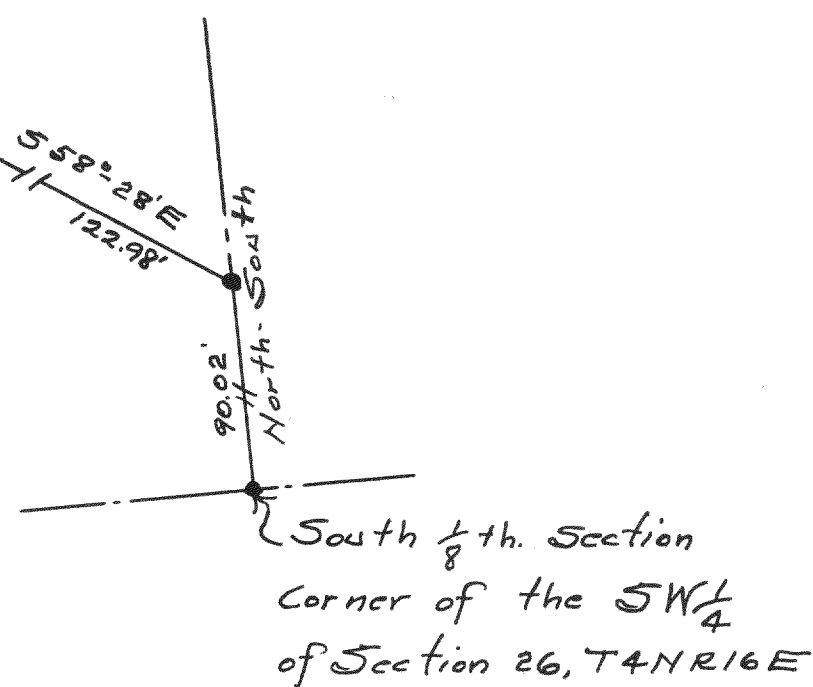

Plot of survey of lots 748 of Block H
of Cisco Beach Subd., located in
Section 5, T14N R17E of Walworth
County Wisconsin.

Dec. 1942

Lloyd L. Jensen
County Surveyor