


#1332

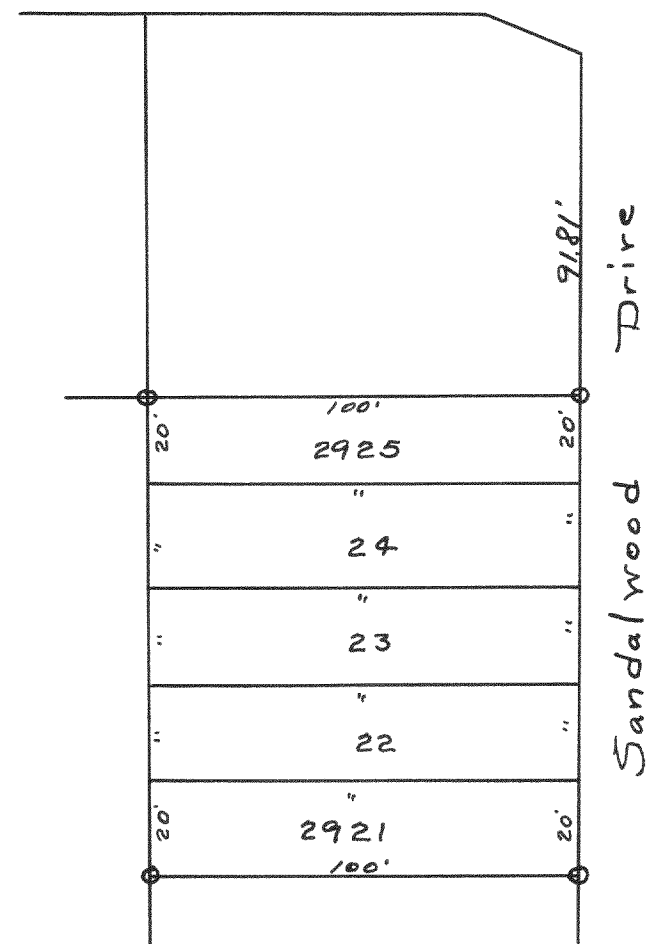


Plot of survey of lots in
Reel Lake Subd.

Sept. 5, 1941

Lloyd F. Jensen
County Surveyor

#1333

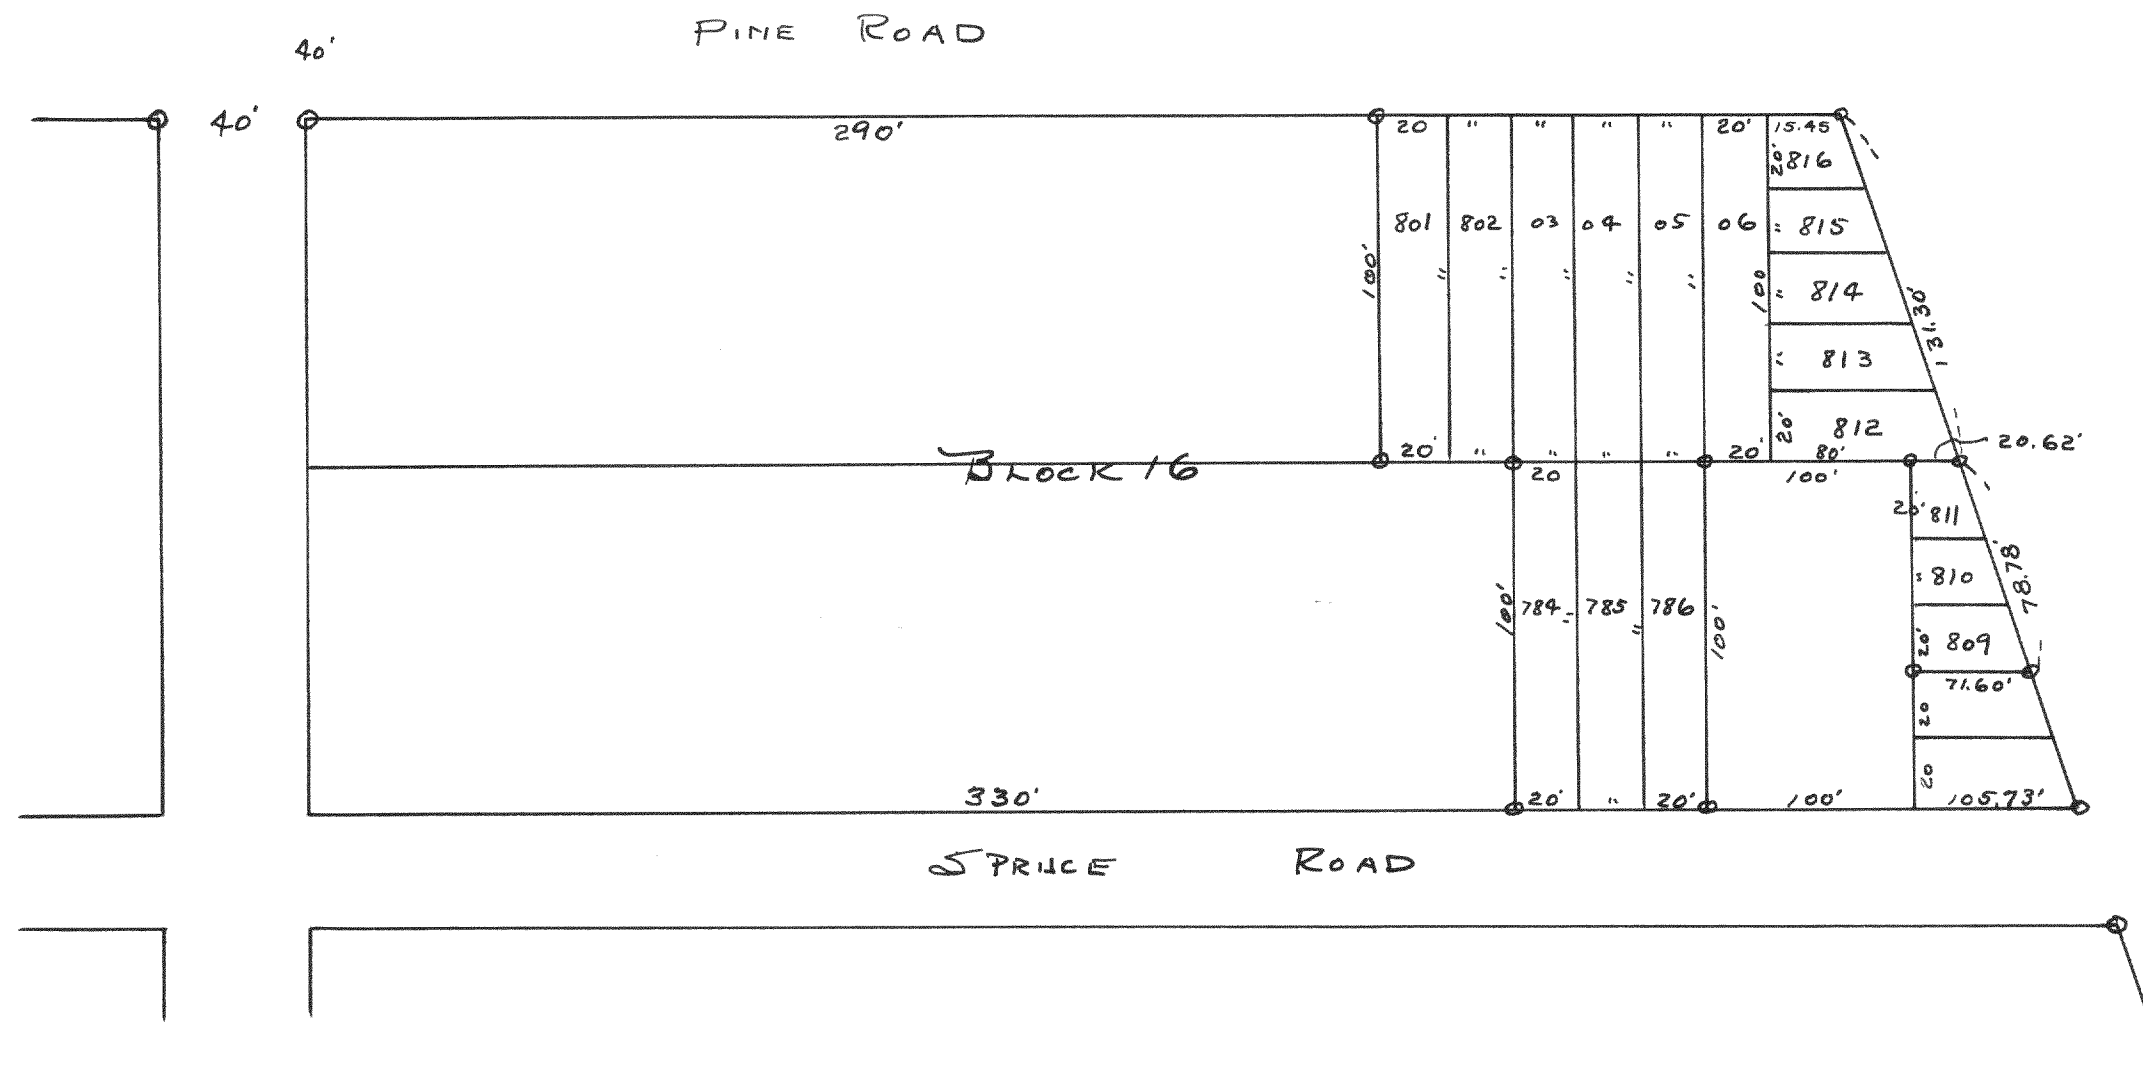

Plot of survey of lots in Blk. 16 of
Section 1 of Reel Lake Subd.

Sept. 7, 1942

Lloyd F. Jensen
County Surveyor