



SURVEY NO. 1201

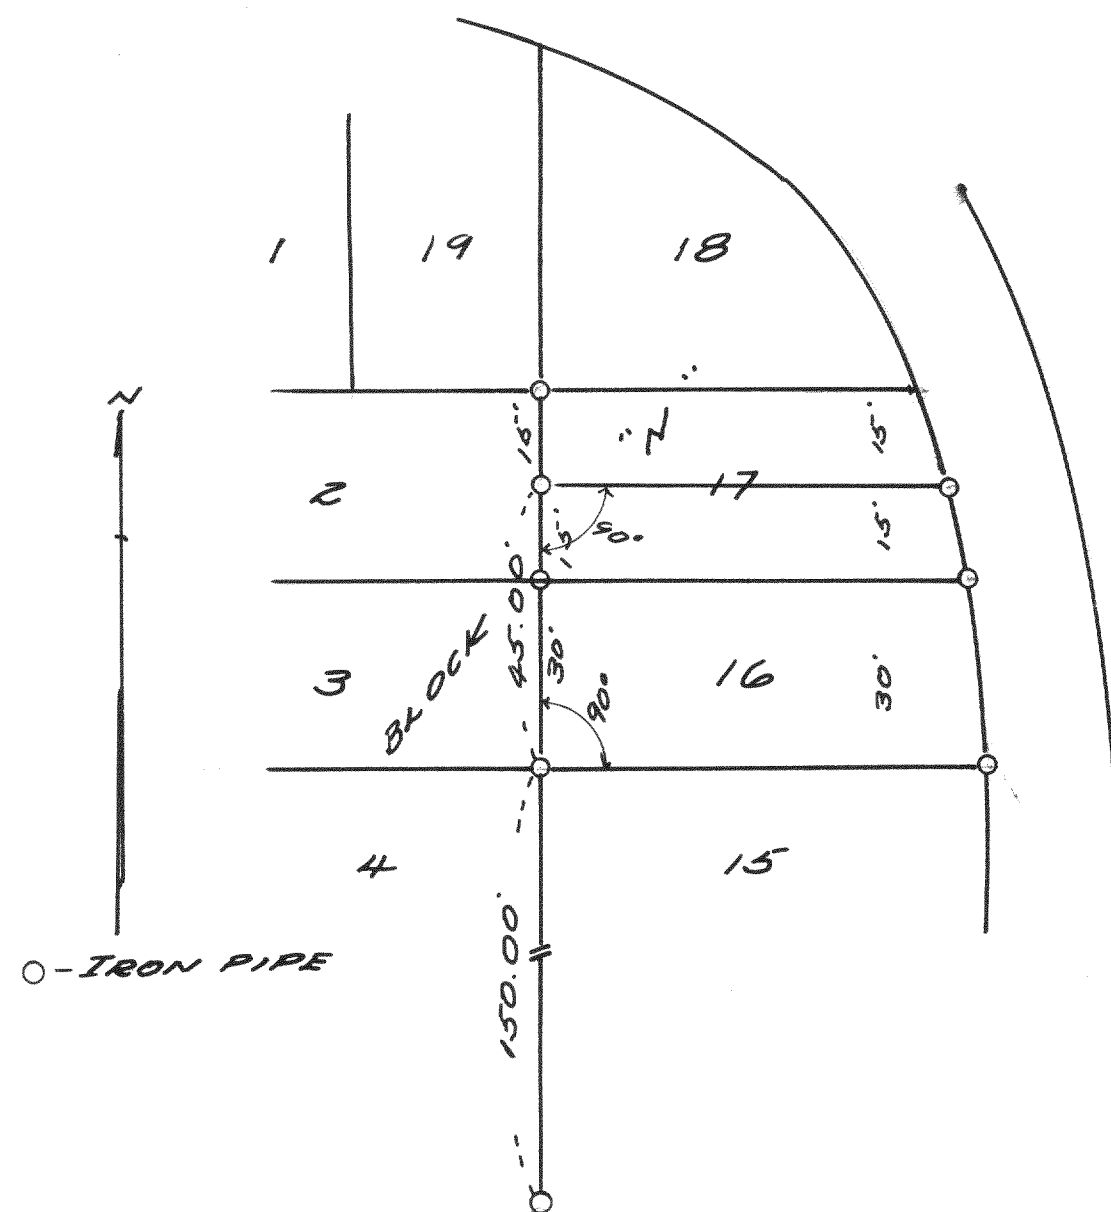

PLAT OF SURVEY OF LOT 16 & THE SOUTH
 1/2 OF LOT 17 OF BLOCK "N" OF DELAMAN
 LAKE ASSEMBLY PARK, WAL. CO., WISC.
 JUNE 26, 1941 Lloyd L. Jensen
 R.E.J.

SURVEY NO. 1202

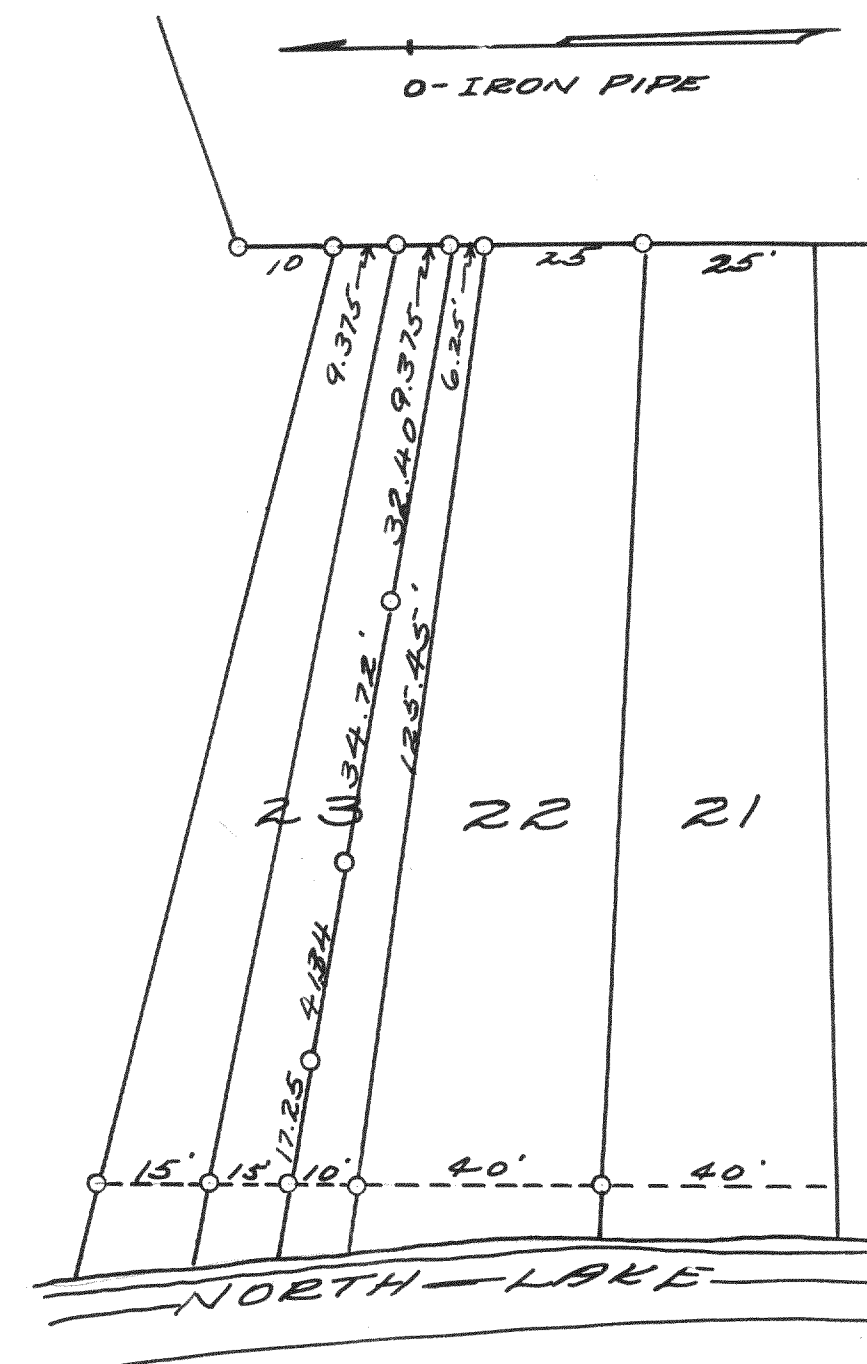

PLAT OF SURVEY OF PART OF LOT 23,
 BLOCK 1, OF NORTH LAKE BEACH, SHORE
 WOODS, SECTION 5 T3N R16E, WALWORTH
 COUNTY, WISCONSIN.
 JUNE, 1941 Lloyd L. Jensen
 R.E.J.