



#1337

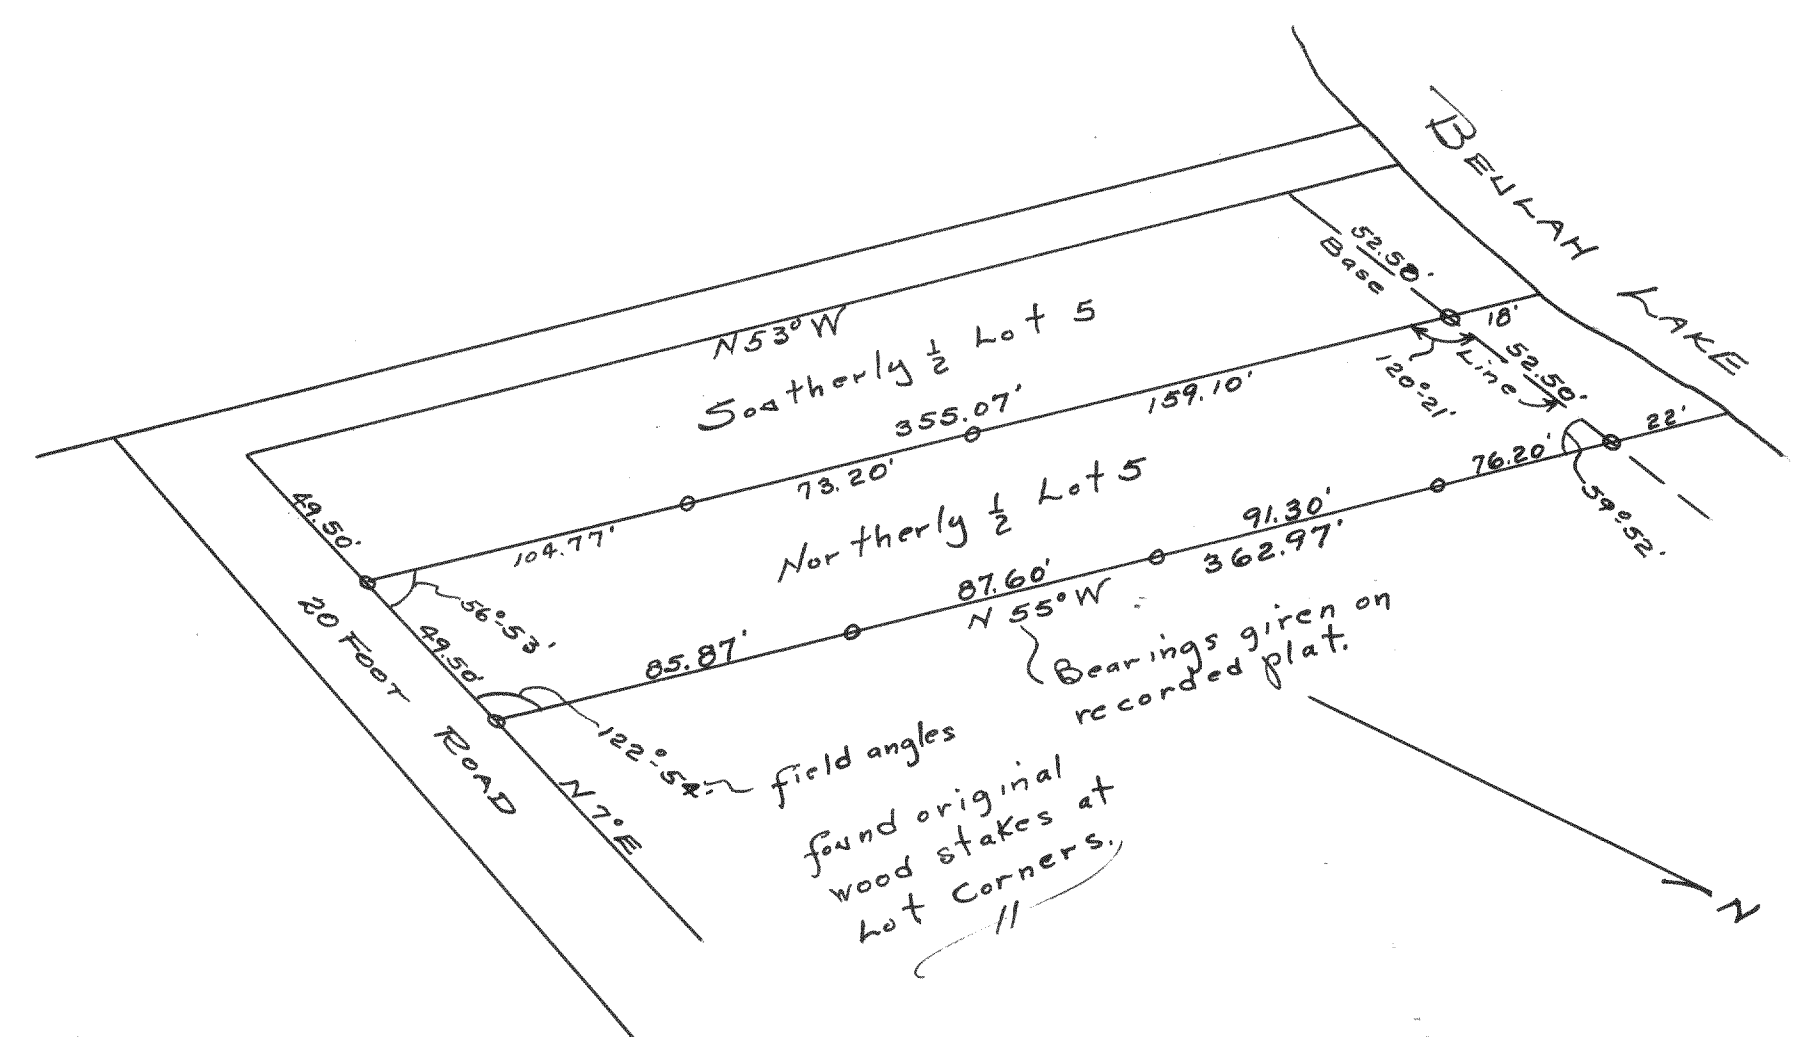

Plat of survey of the Northerly  $\frac{1}{2}$  of Lot 5 of Kings Park Subdivision, located in fractional Section 17, T4N R18E.

July 1942 Lloyd S. Jensen  
County Surveyor

#1338

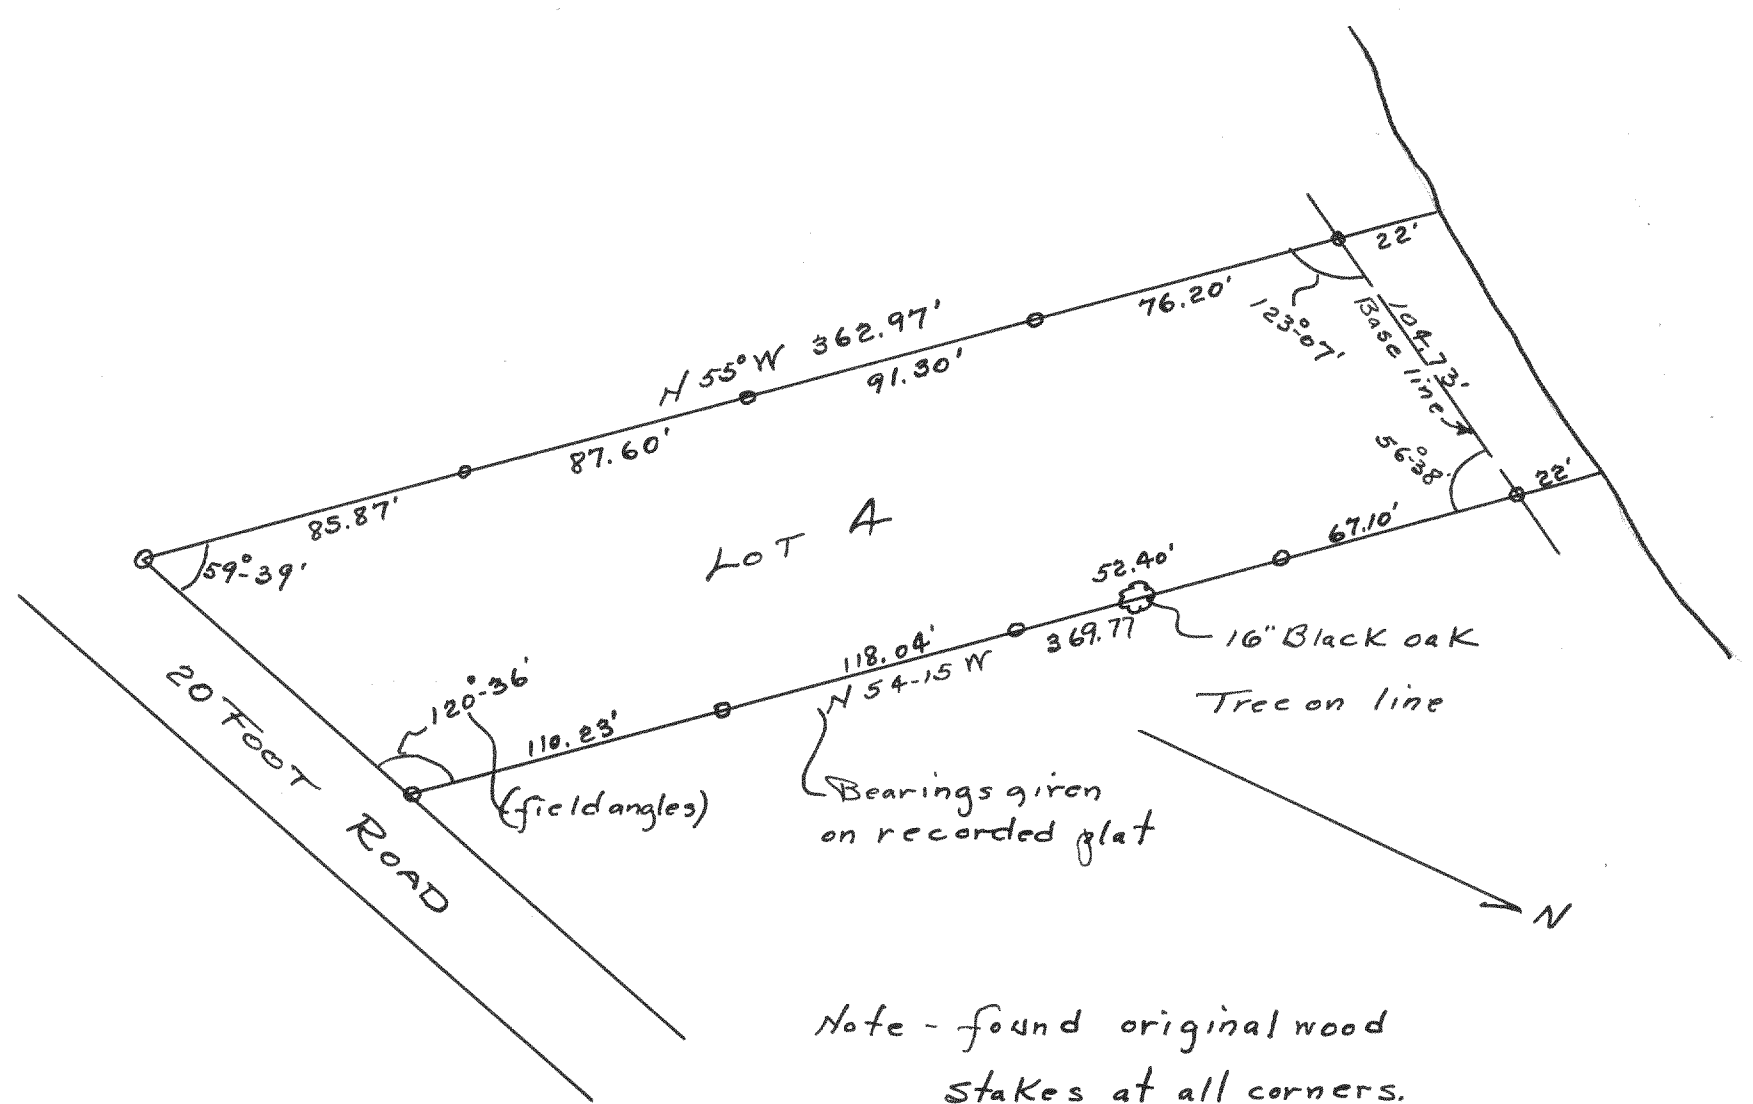

Plat of survey of Lot 4 of Kings Park Subdivision, located in fractional Section 17, T4N R17E.

Dec. 1942 Lloyd S. Jensen  
County Surveyor