


#1339

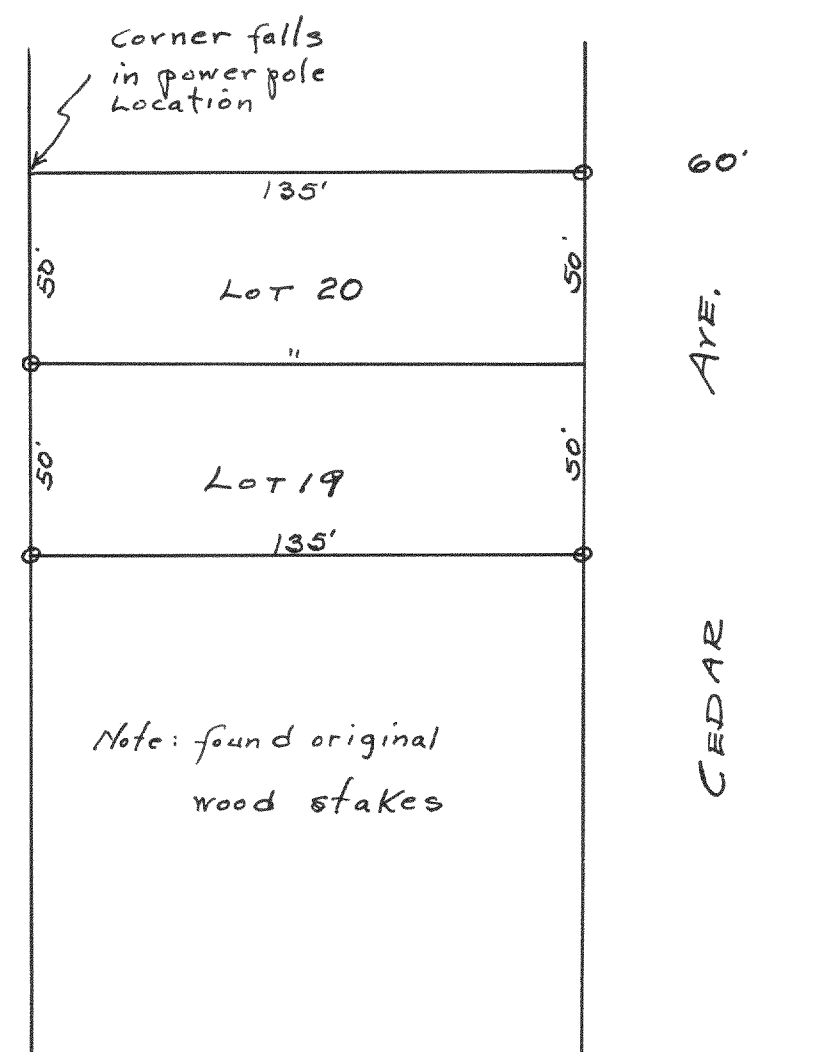


Plot of survey of Lots 19 and 20 of
Block 13 of Miramar Subdivision,
located in Sections 10 and 11,
T47R18E.

Aug. 1942

Lloyd F. Jensen
County Surveyor

#1340

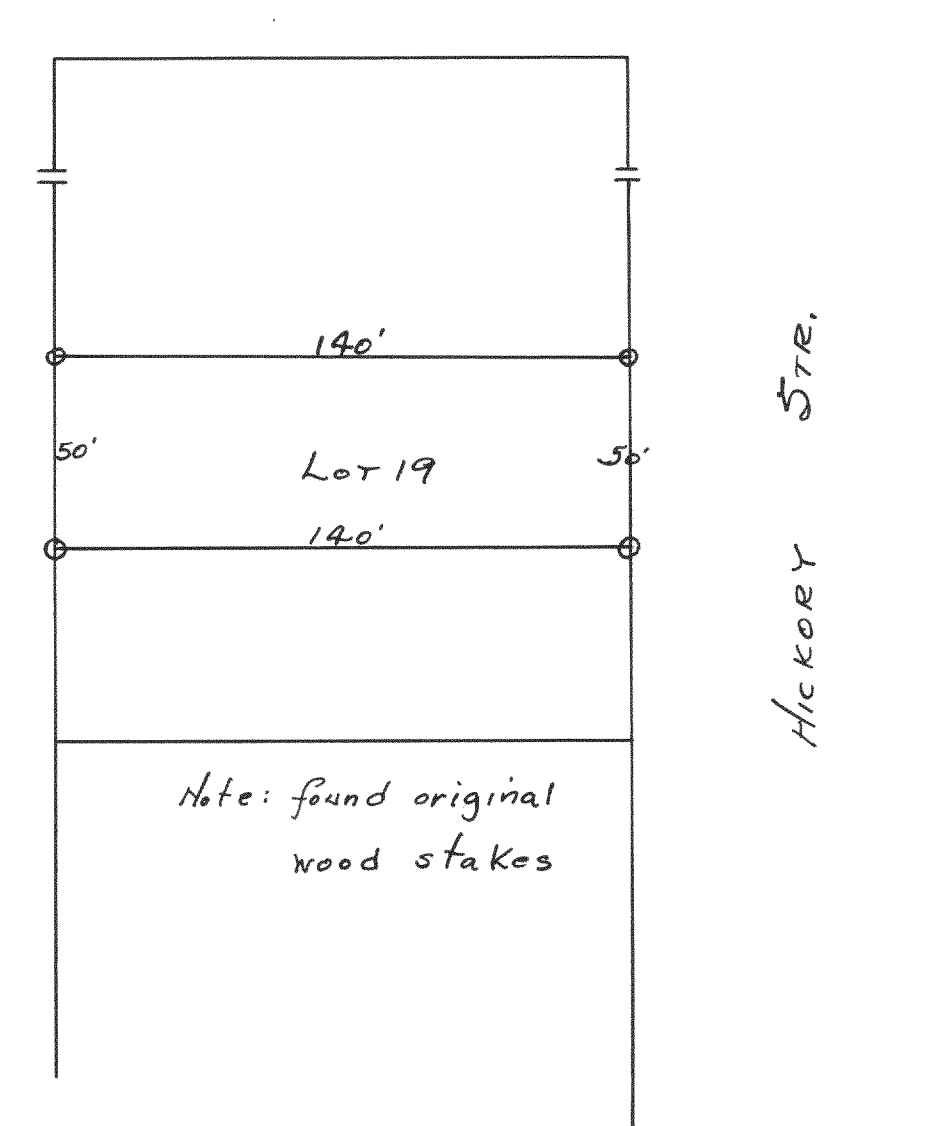

Plot of survey of Lots 19 of
Block 12 of Miramar Subd.,
located in Sections 10 and 11,
T47R18E.

Aug. 1942

Lloyd F. Jensen
County Surveyor