



#1349

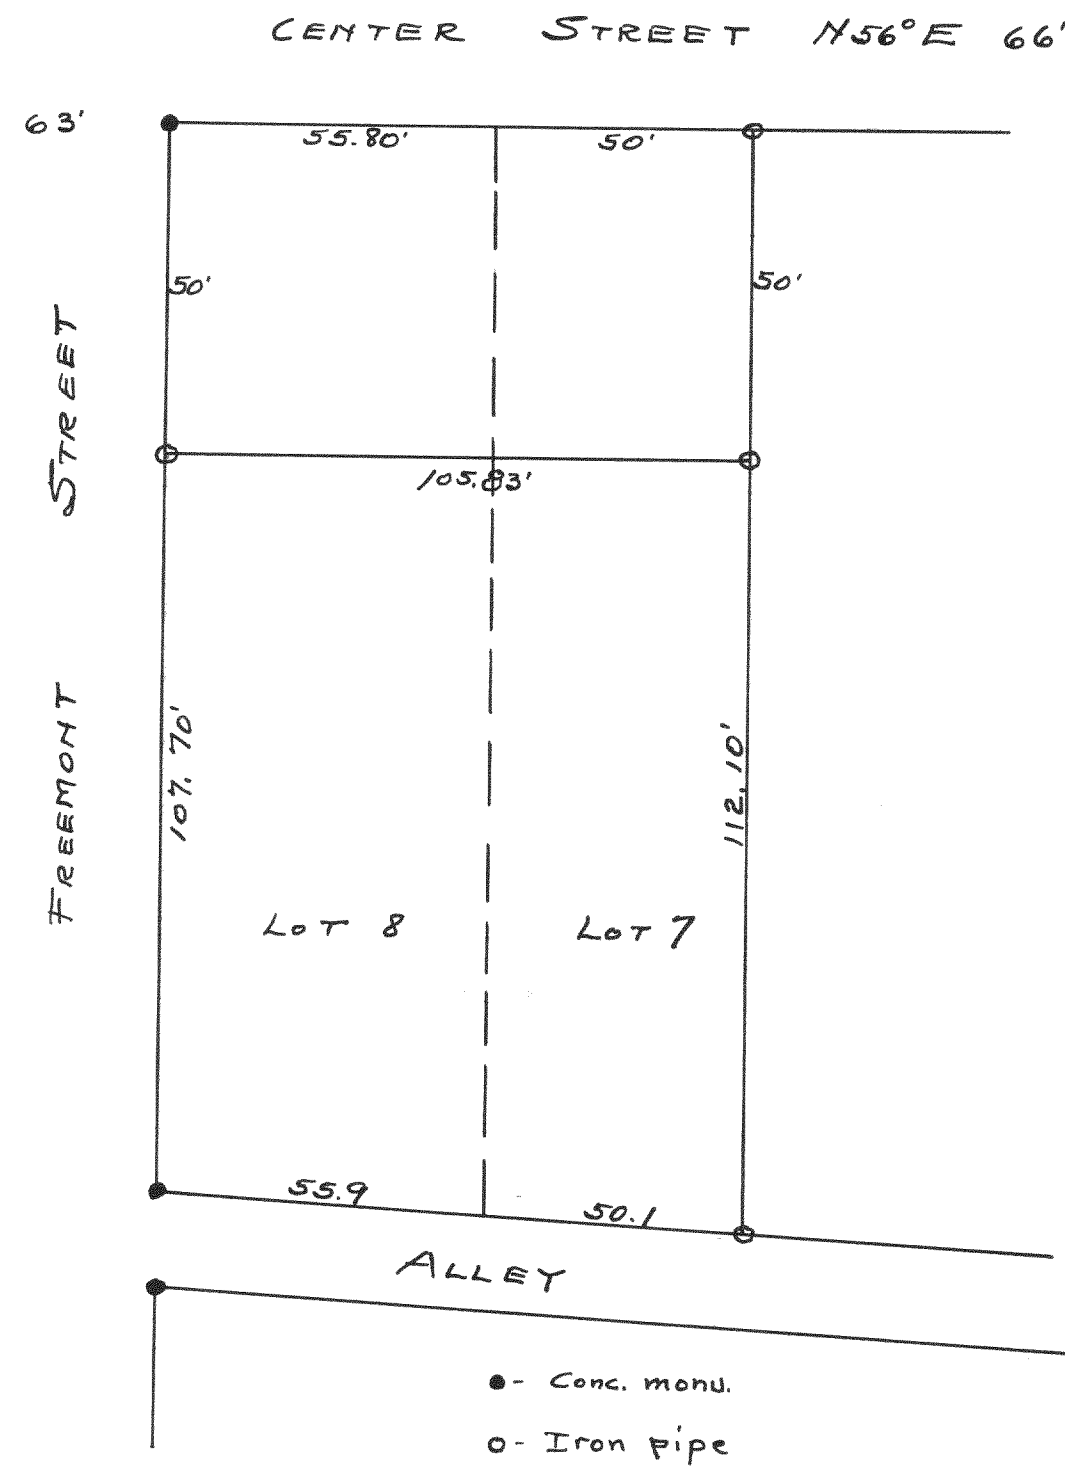

Plot of survey of the north 50 feet of Lots 8 and 7 of Block 4 of Converse's Subdivision, City of Delavan Wisconsin

Jan. 1943 Lloyd L. Jensen
County Surveyor

#1350

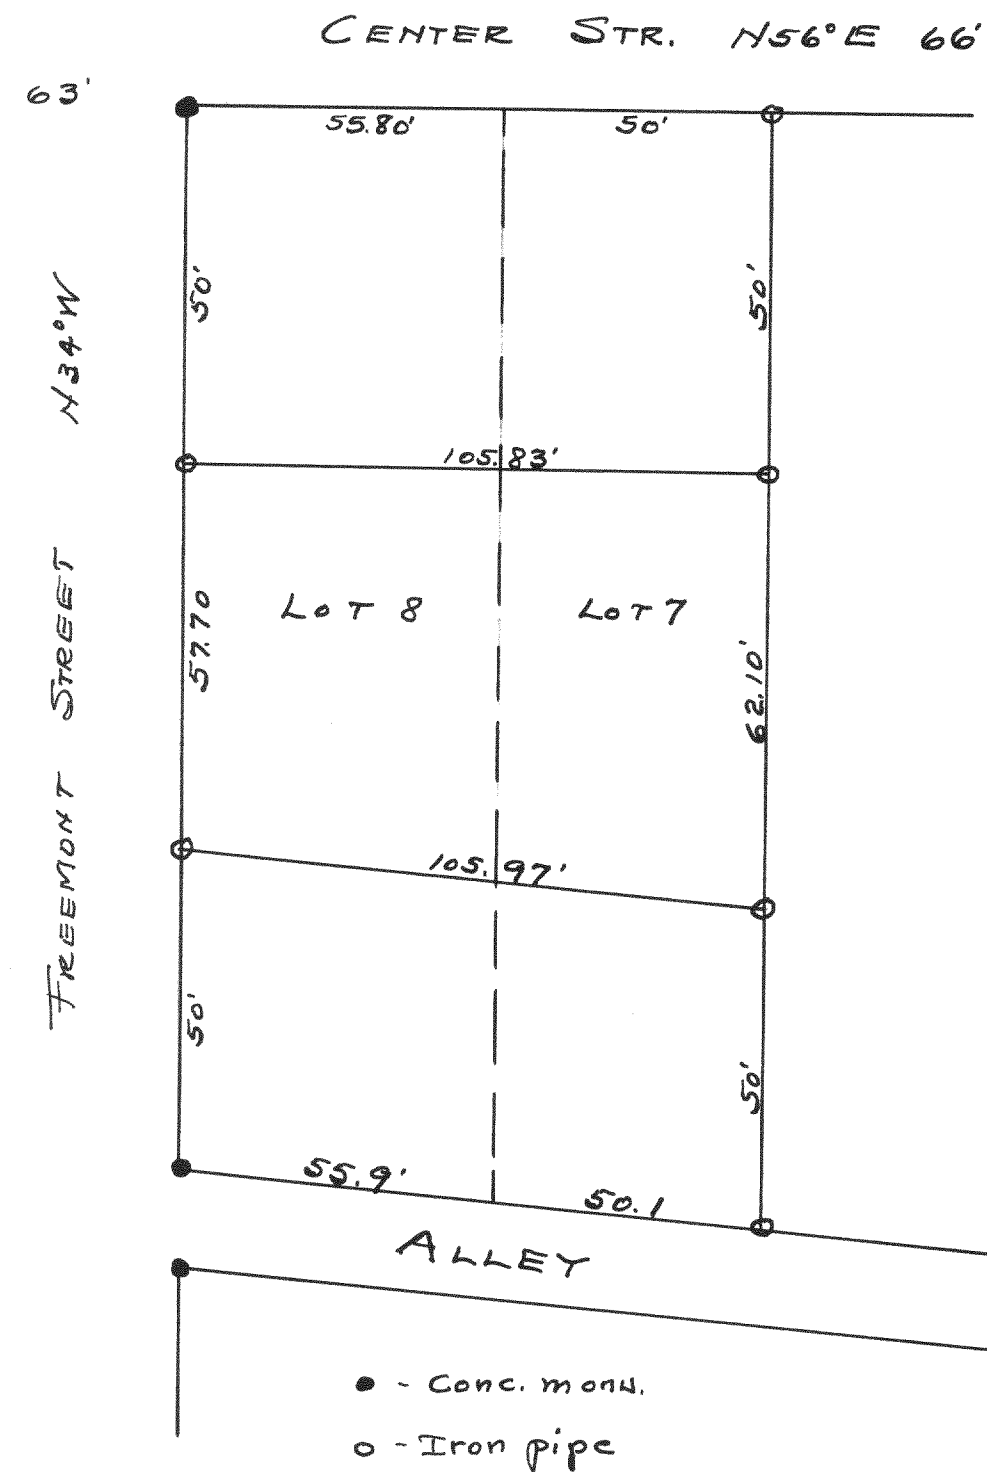

Plot of survey of the middle portion of Lots 7 and 8 of Block 4 of Converse's Subd., City of Delavan, Wisconsin.

Jan. 1943 Lloyd L. Jensen
County Surveyor