

#1351

CENTER STR. N56°E 66'




Plat of survey of the South
50 feet of Lots 7 and 8 of Block
4 of Converse's Subdivision,
City of Delavan, Wisconsin.

Jan. 1943

Lloyd S. Jensen
County Surveyor

#1352

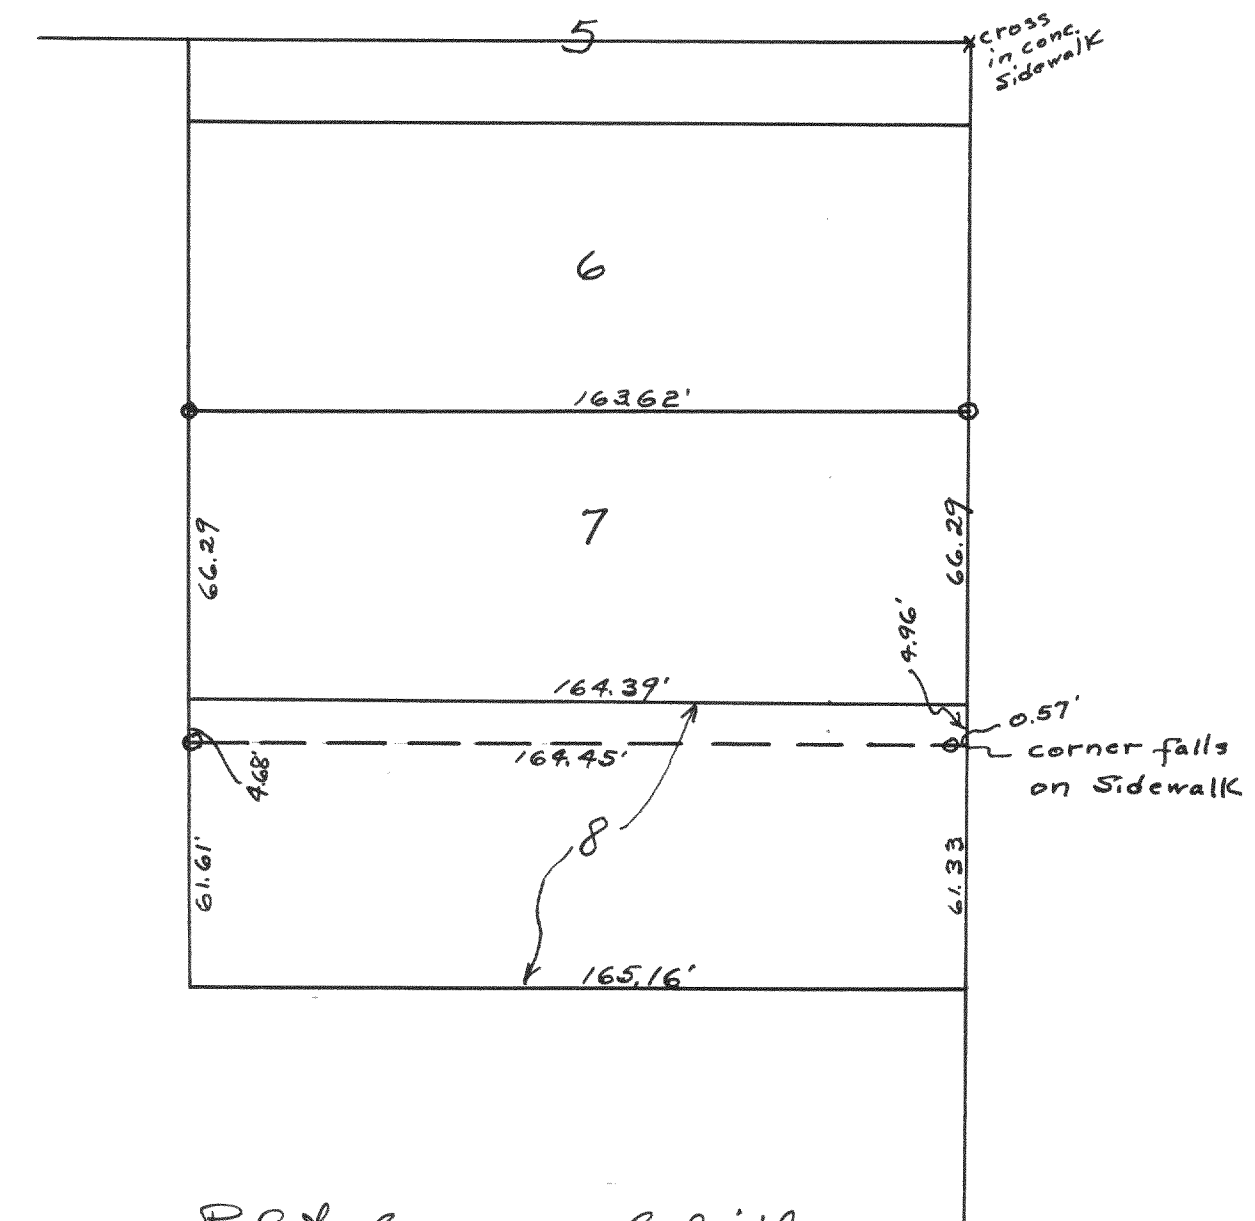

Plat of survey of dividing
line in Lot 8 of Block 2
of J. B. Reverdy's Add. to
the City of Delavan.

June 6, 1942 Lloyd S. Jensen
County Surveyor