



PLAT OF SURVEY OF LOT 7 BLOCK 19 ORIGINAL PLAT CITY OF LAKE GENEVA WALWORTH COUNTY WISCONSIN MARCH 1957 LLOYD L. JENSEN SURVEYOR

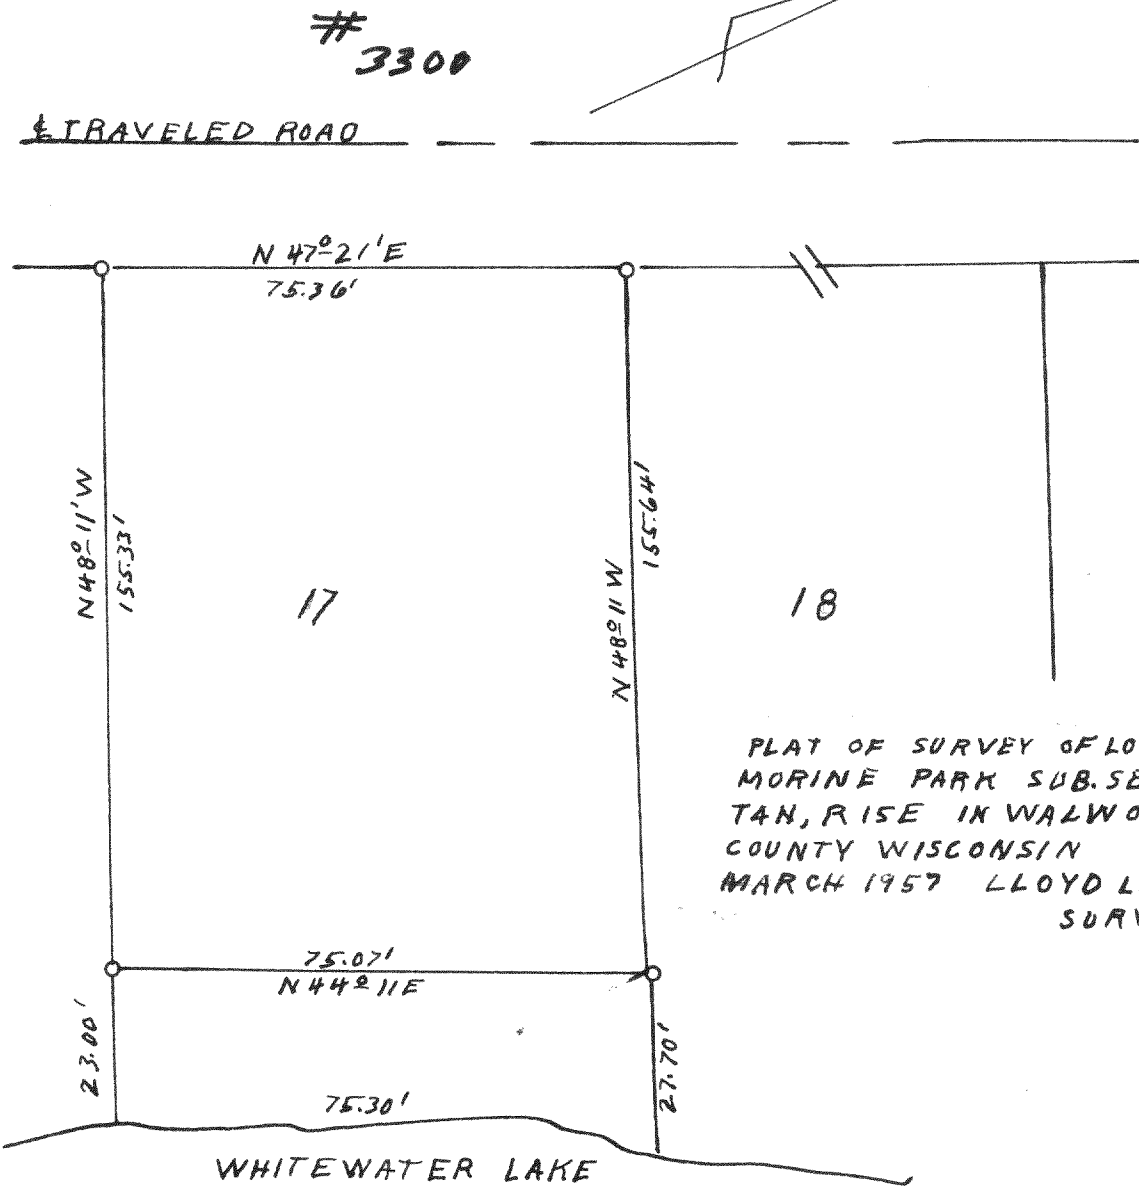


PLAT OF SURVEY OF LOT 17 IN MORINE PARK SUBSECTION 34 TAN, RISE IN WALWORTH COUNTY WISCONSIN MARCH 1957 LLOYD L. JENSEN SURVEYOR

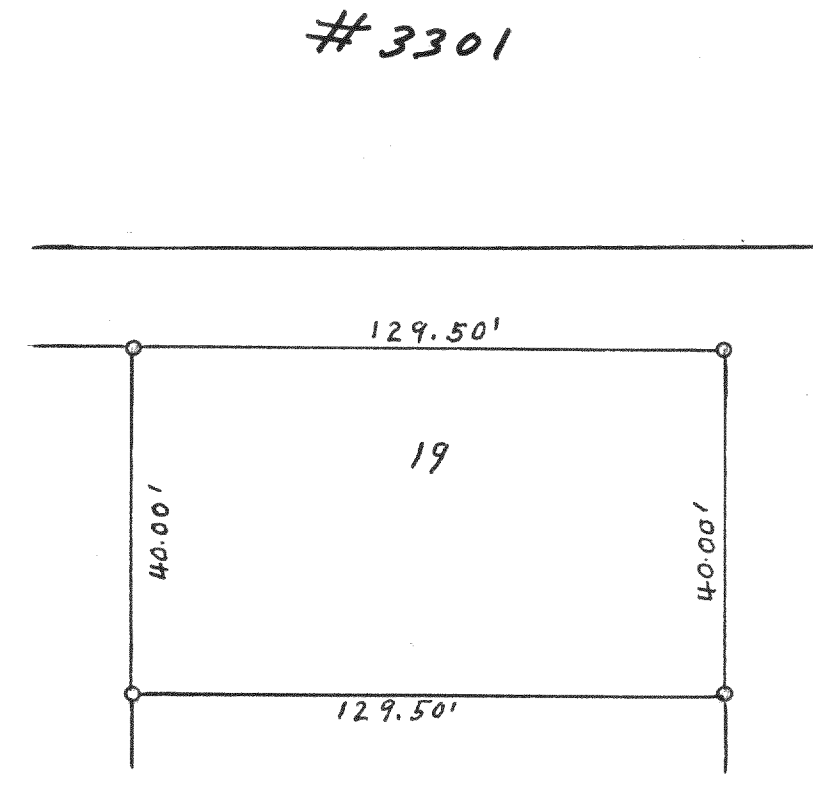


PLAT OF SURVEY OF LOT 19 CARLSONS ADD. VILLAGE OF WILLIAMS BAY WALWORTH COUNTY WISCONSIN JULY 1955 LLOYD L. JENSEN SURVEYOR

3302

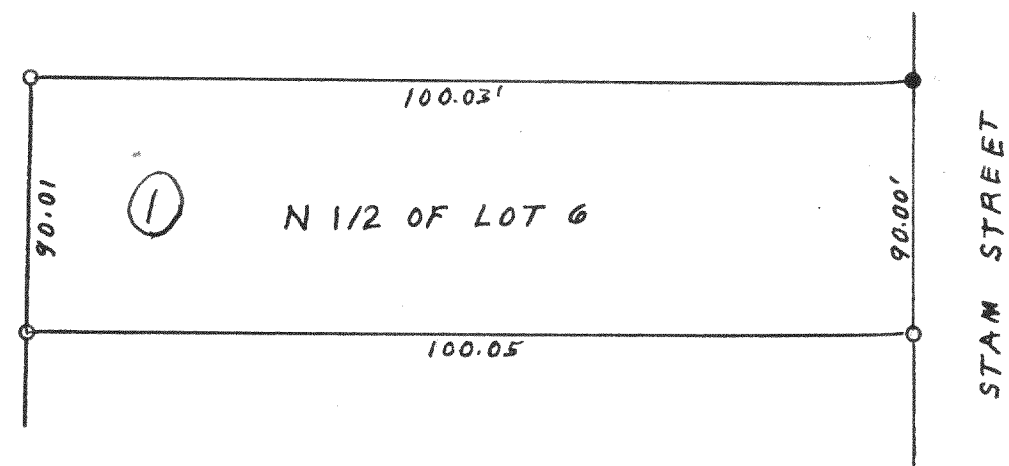


PLAT OF SURVEY OF PART OF LOT 6 OF BLOCK 1 OF UNIVERSITY HEIGHT VILLAGE OF WILLIAMS BAY WALWORTH COUNTY WISCONSIN MARCH 1955 LLOYD L. JENSEN SURVEYOR

3303

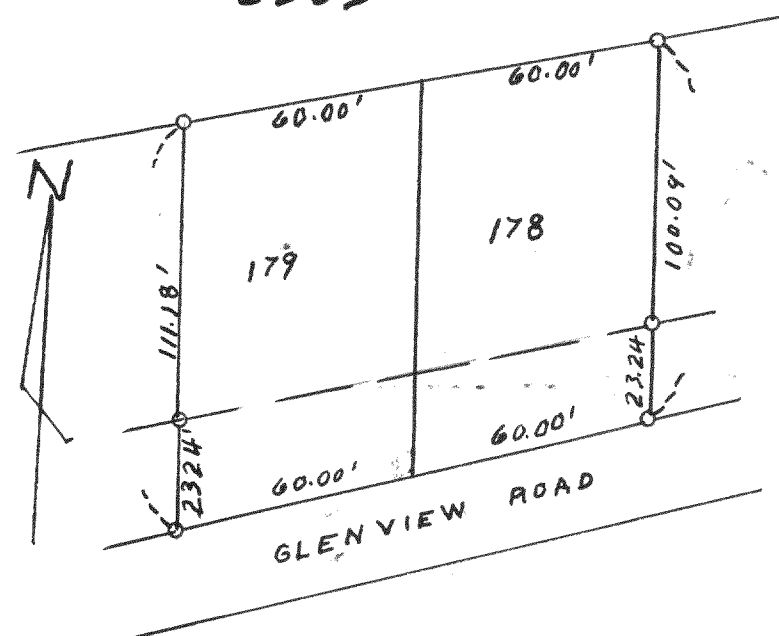

PLAT OF SURVEY OF LOT 178-179 OF CEDER POINT PARK 2ND ADDITION VILLAGE OF WILLIAMS BAY WALWORTH COUNTY WISCONSIN AUG 1955 LLOYD L. JENSEN SURVEYOR

3304

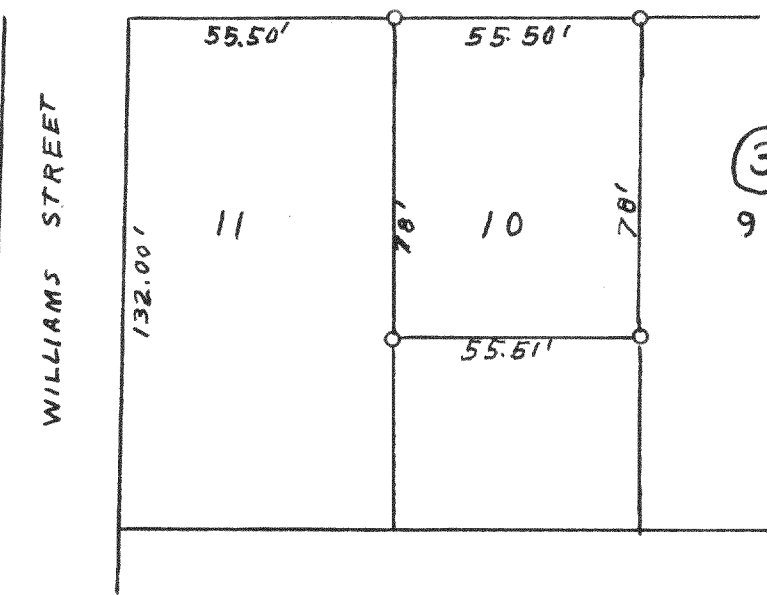

PLAT OF SURVEY OF PART OF LOT 10 BLOCK 3 OF ORIGINAL PLAT VILLAGE OF WILLIAMS BAY WALWORTH COUNTY WISCONSIN SEPT. 1955 LLOYD L. JENSEN SURVEYOR

*Paul To Love
Dec 1957*