



Plat of Survey of Land in SE 1/4 Sec. 19
TANRIBE Village of East Troy Block 3
August 1953
LLJ
CS

2790

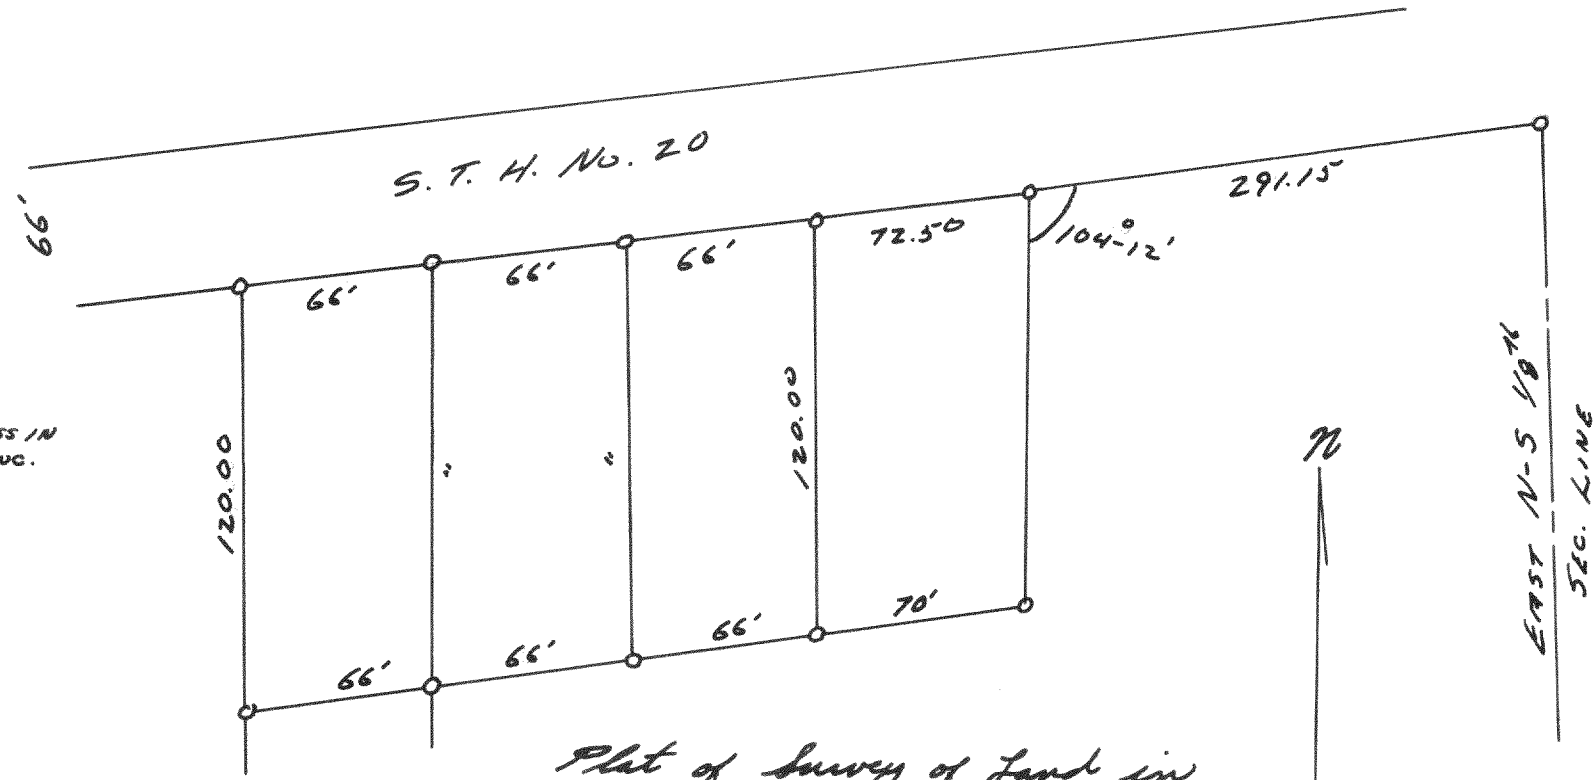


Plat of Survey of Land in
SE 1/4 Sec. 19 TANRIBE
Village of East Troy
May 1953
LLJ
CS

2791

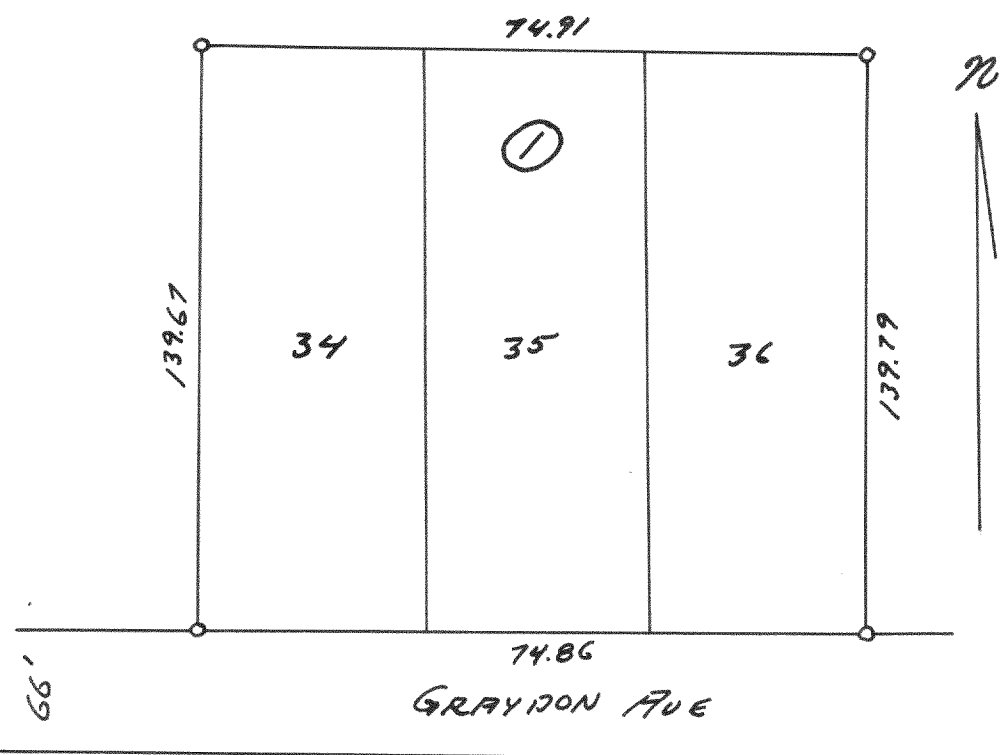


Plat of Survey of Lots 34-36 Block 1
Clarkson Add. Village of East Troy
Aug. 1953
LLJ
CS

2792

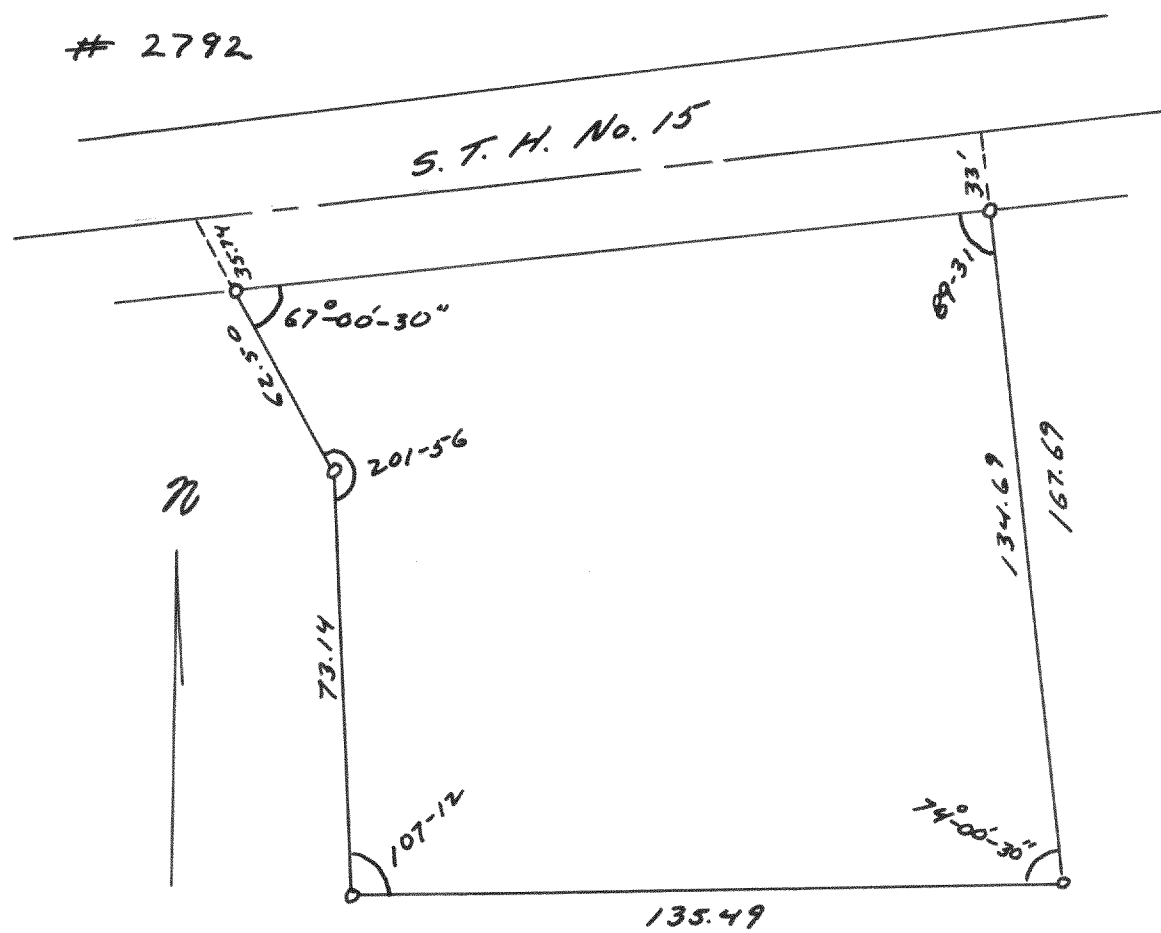

Plat of Survey of Land in SW 1/4 Sec. 20
TANRIBE Village of East Troy
March 1953
LLJ
CS

2793

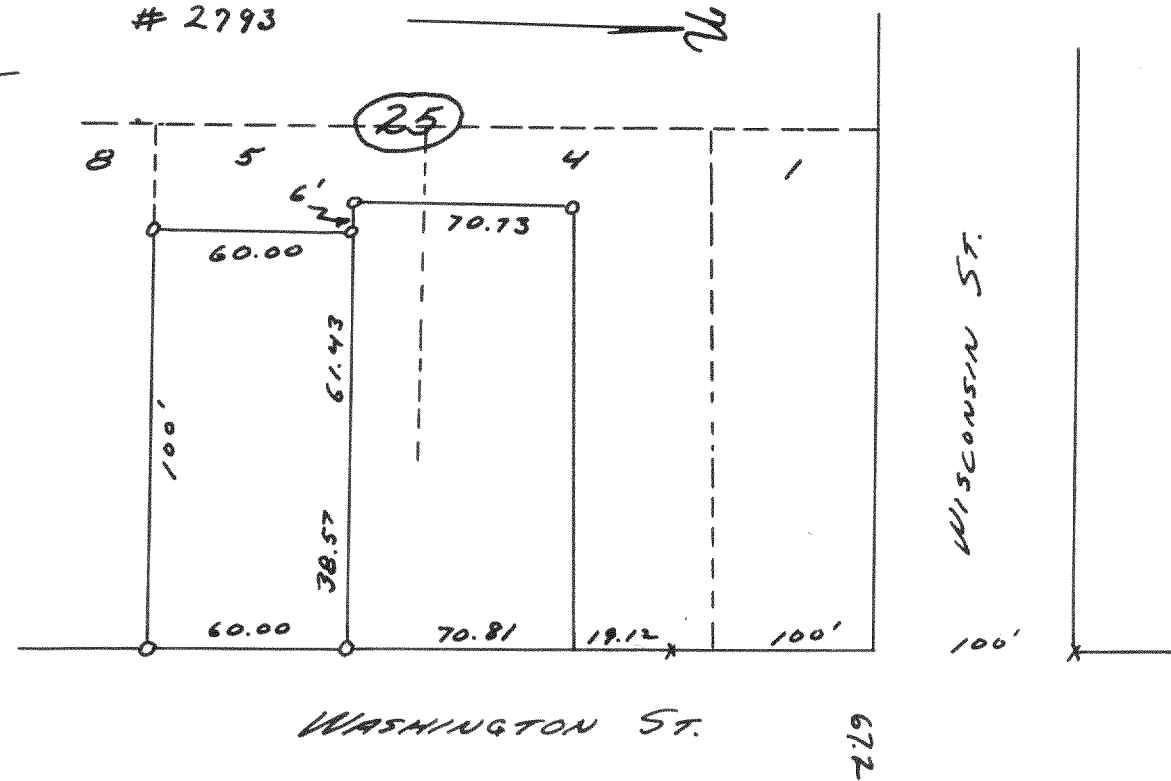

Plat of Survey of Lots
1-5 Block 25 City of
Oldham April 1953
LLJ
CS