



2649

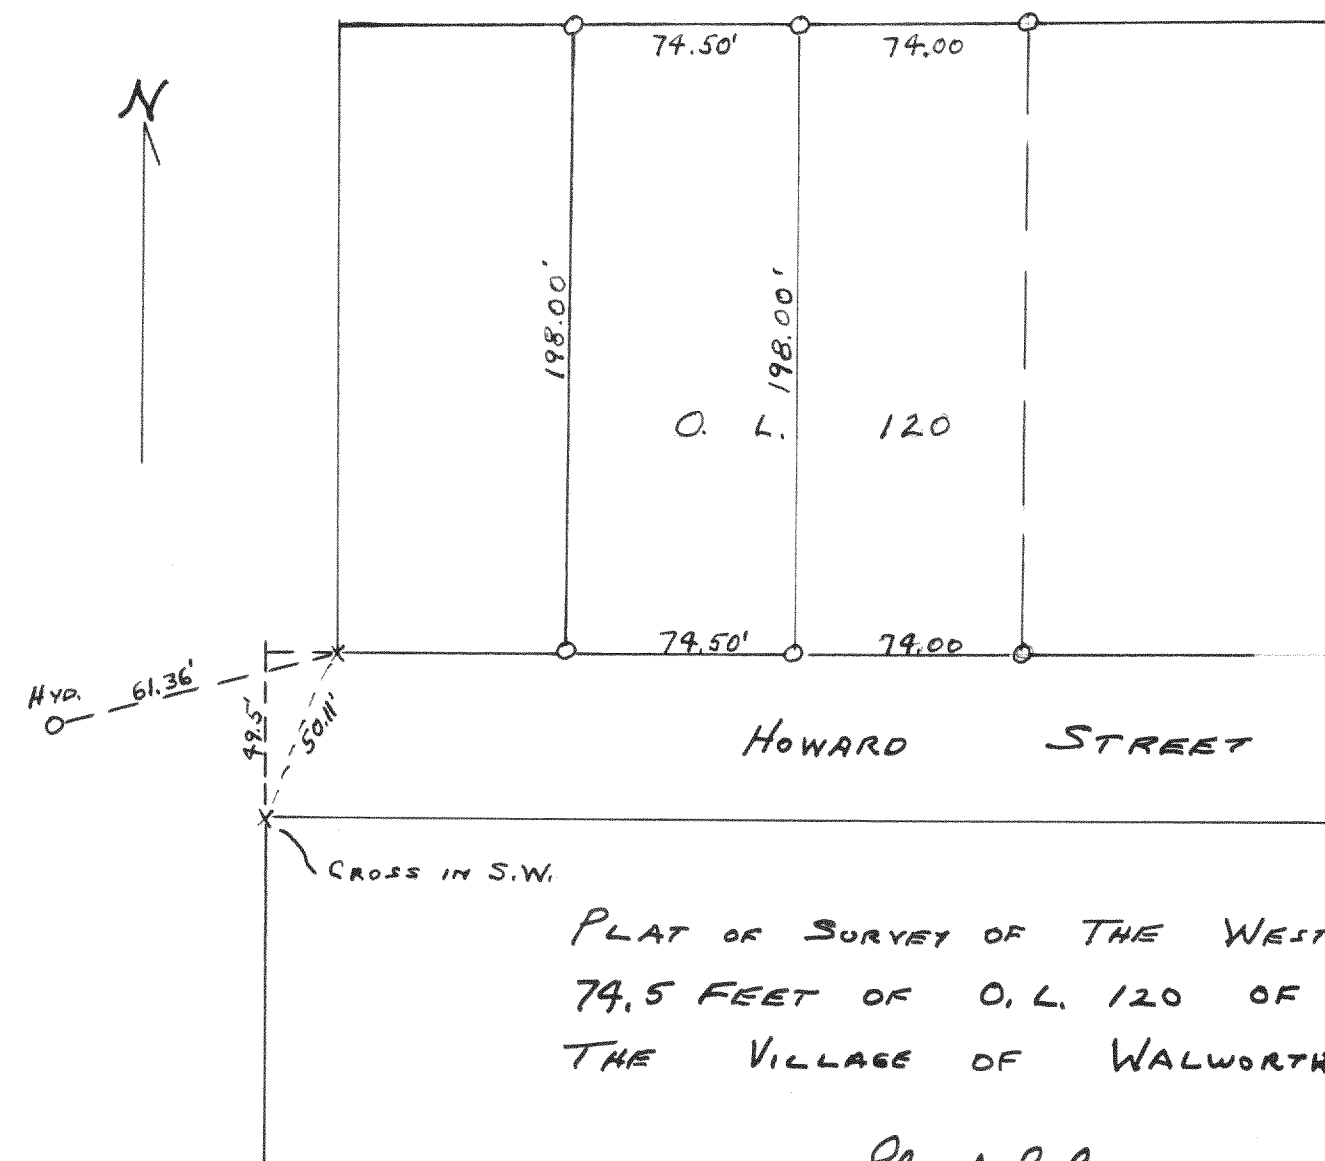

PLAT OF SURVEY OF THE WEST
74.5 FEET OF O. L. 120 OF
THE VILLAGE OF WALWORTH

1952 Lloyd L Jensen
COUNTY SURVEYOR


2651

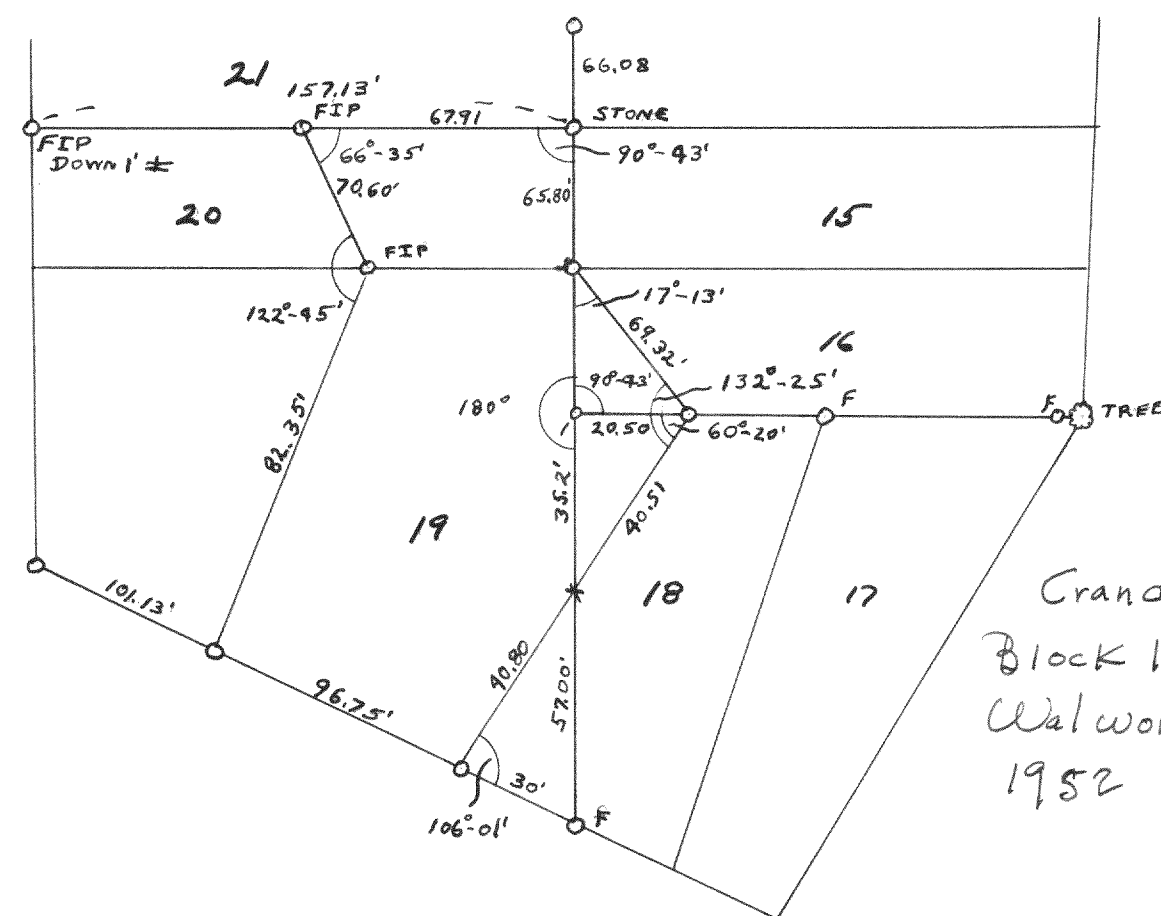

Grandall's & Swinney's
Block 1 of Village of
Walworth.

1952 Lloyd Jensen
County Surveyor

2650

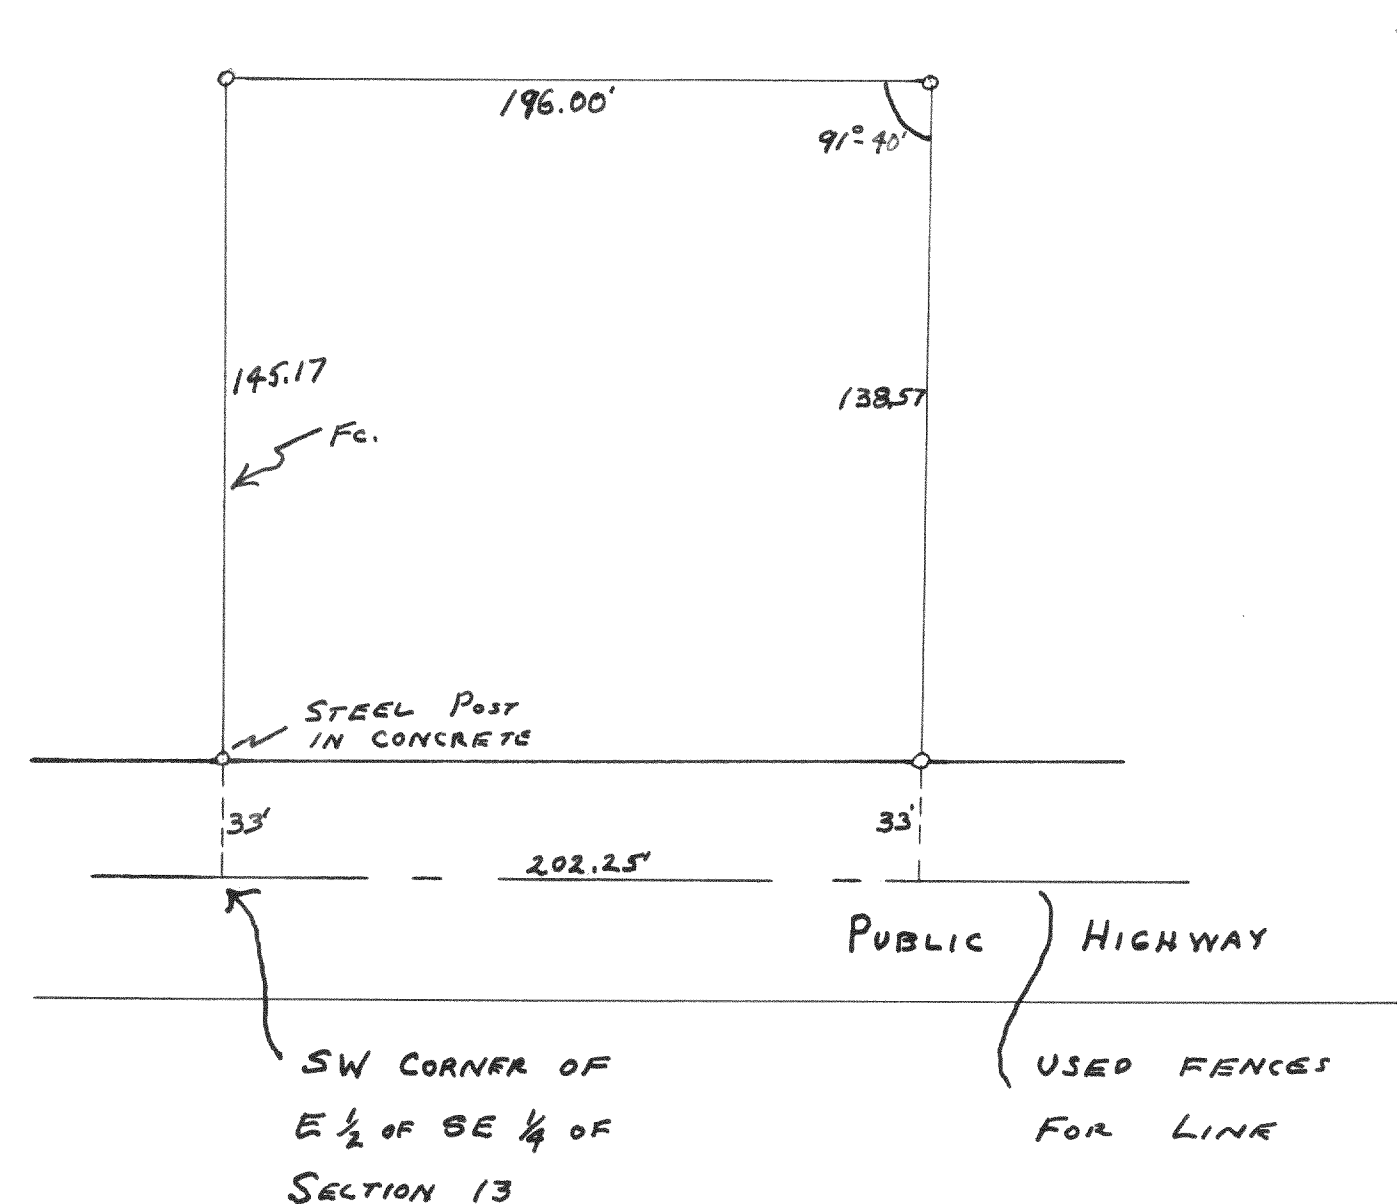

PLAT OF SURVEY OF A PARCEL OF LAND
LOCATED IN THE E $\frac{1}{2}$ OF THE SOUTHEAST $\frac{1}{4}$
OF SECTION 13, T4N, R16E.

Nov. 7, 1952