

2652

Subdivision of Addition B to Country Club Estates in the Village of Fontana is recorded on Page 63 of Volume 12 of Walworth County Plats.

Oct 1952

Lloyd L Jensen (reg)
County Surveyor


2652 1/2

Subdivision of Addition C to Country Club Estates in the Village of Fontana is recorded on Page 69 of Volume 12 of Walworth County Plats

Feb. 1953

Lloyd L Jensen (reg)
County Surveyor

2654

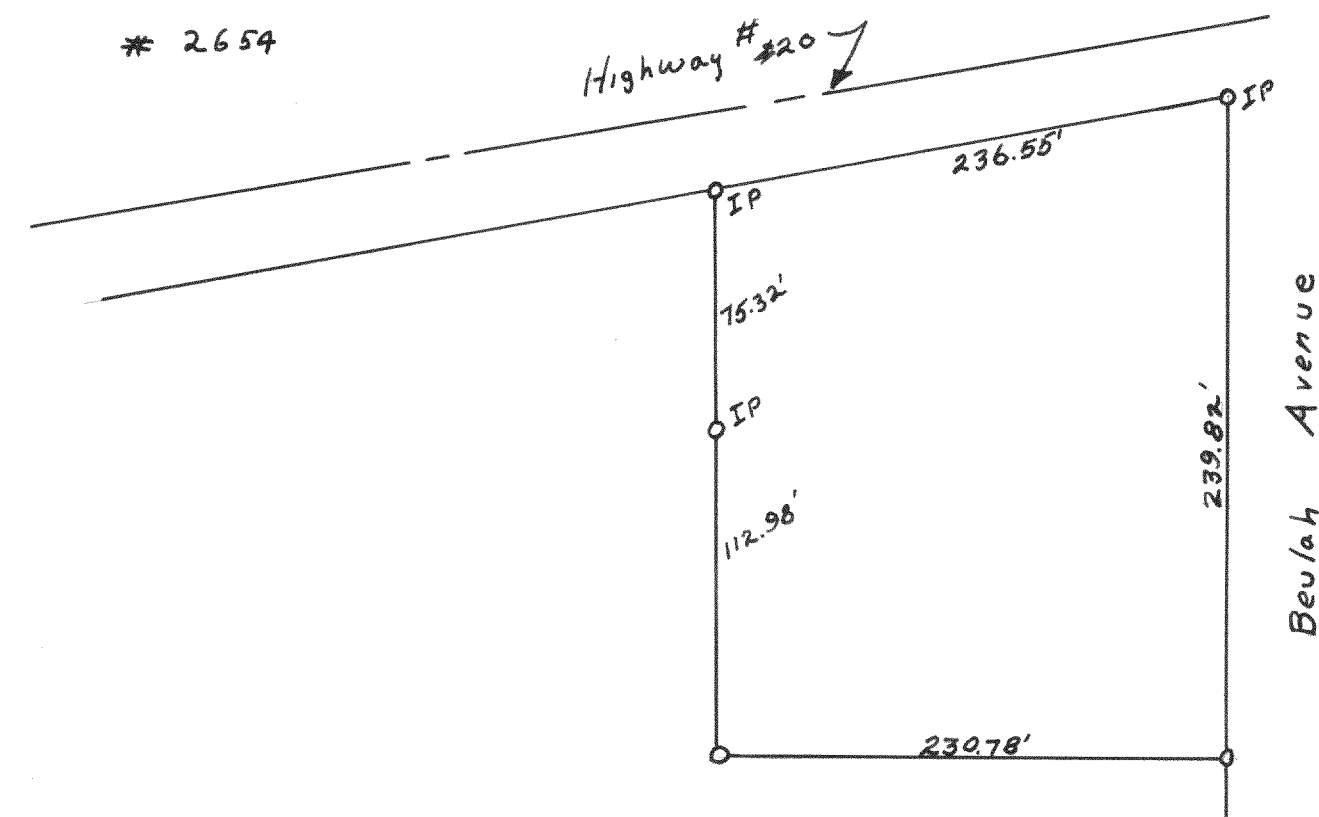


Plat of survey of a parcel of land located in the Southeast 1/4 of Section 19, T4N R18E, Village of East Troy

Aug. 1952

Lloyd L Jensen (reg)
County Surveyor


2653

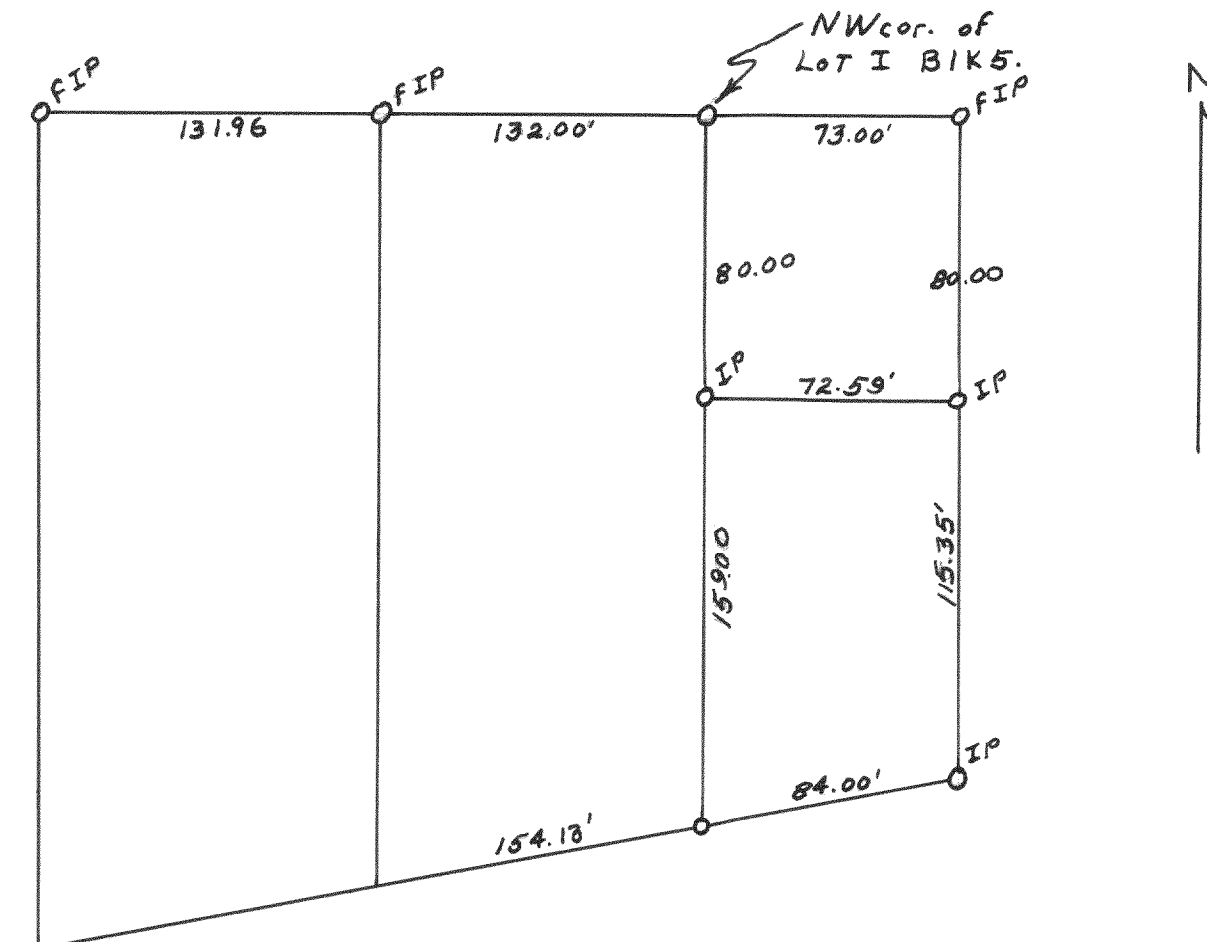

Plat of survey of part of Lot 1 of Block 5 of the Original plat of the Village of East Troy
April 23, 1952

Lloyd L Jensen (reg)
County Surveyor

2655

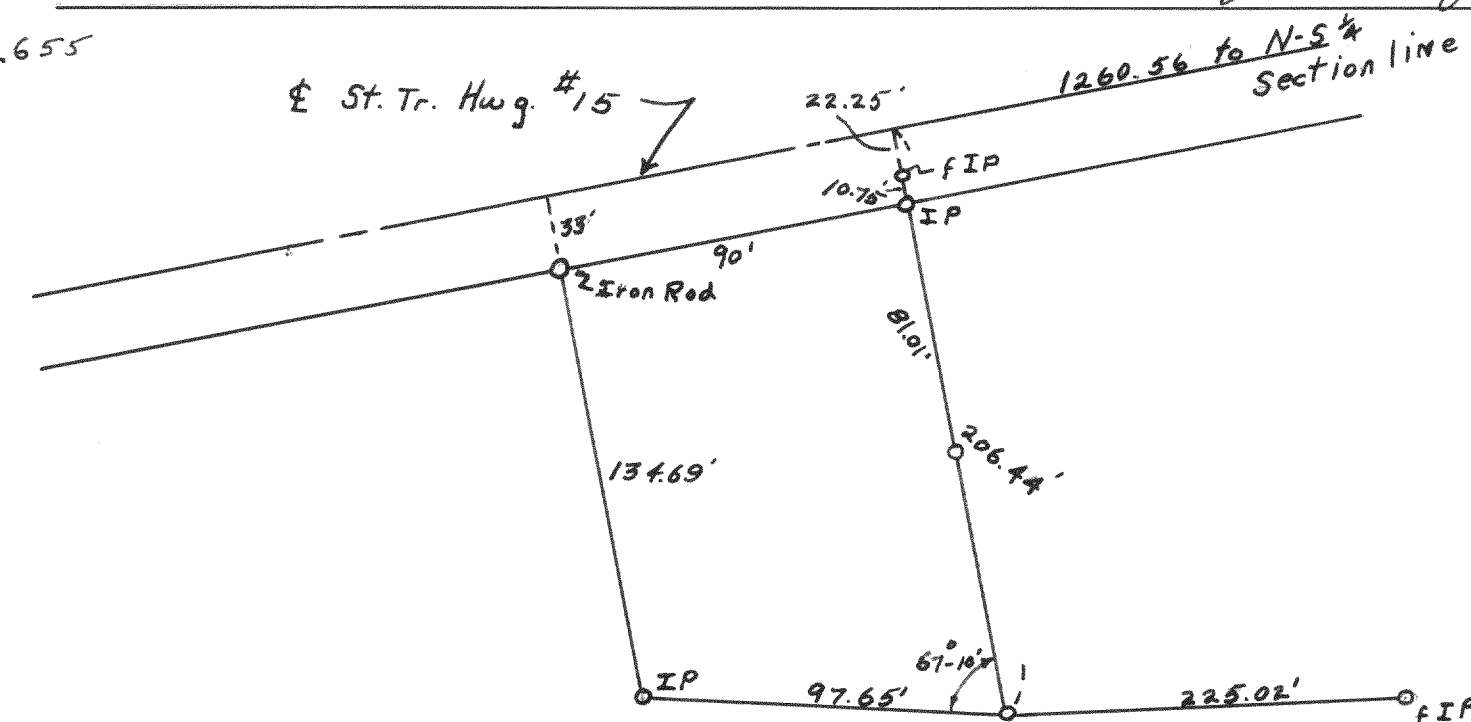

Plat of survey of parcel of land to be sold by Robran located in the Southwest 1/4 of Section 20, T4N R18E.

1952

Lloyd L Jensen (reg)
County Surveyor