



LOT 13 & 14 OF FREUCK'S SUBDIVISION
 LOCATED IN T4NR18E, WALWORTH COUNTY,
 WISCONSIN.

LLOYD L. JENSEN
 COUNTY SURVEYOR
 JAN. 1956

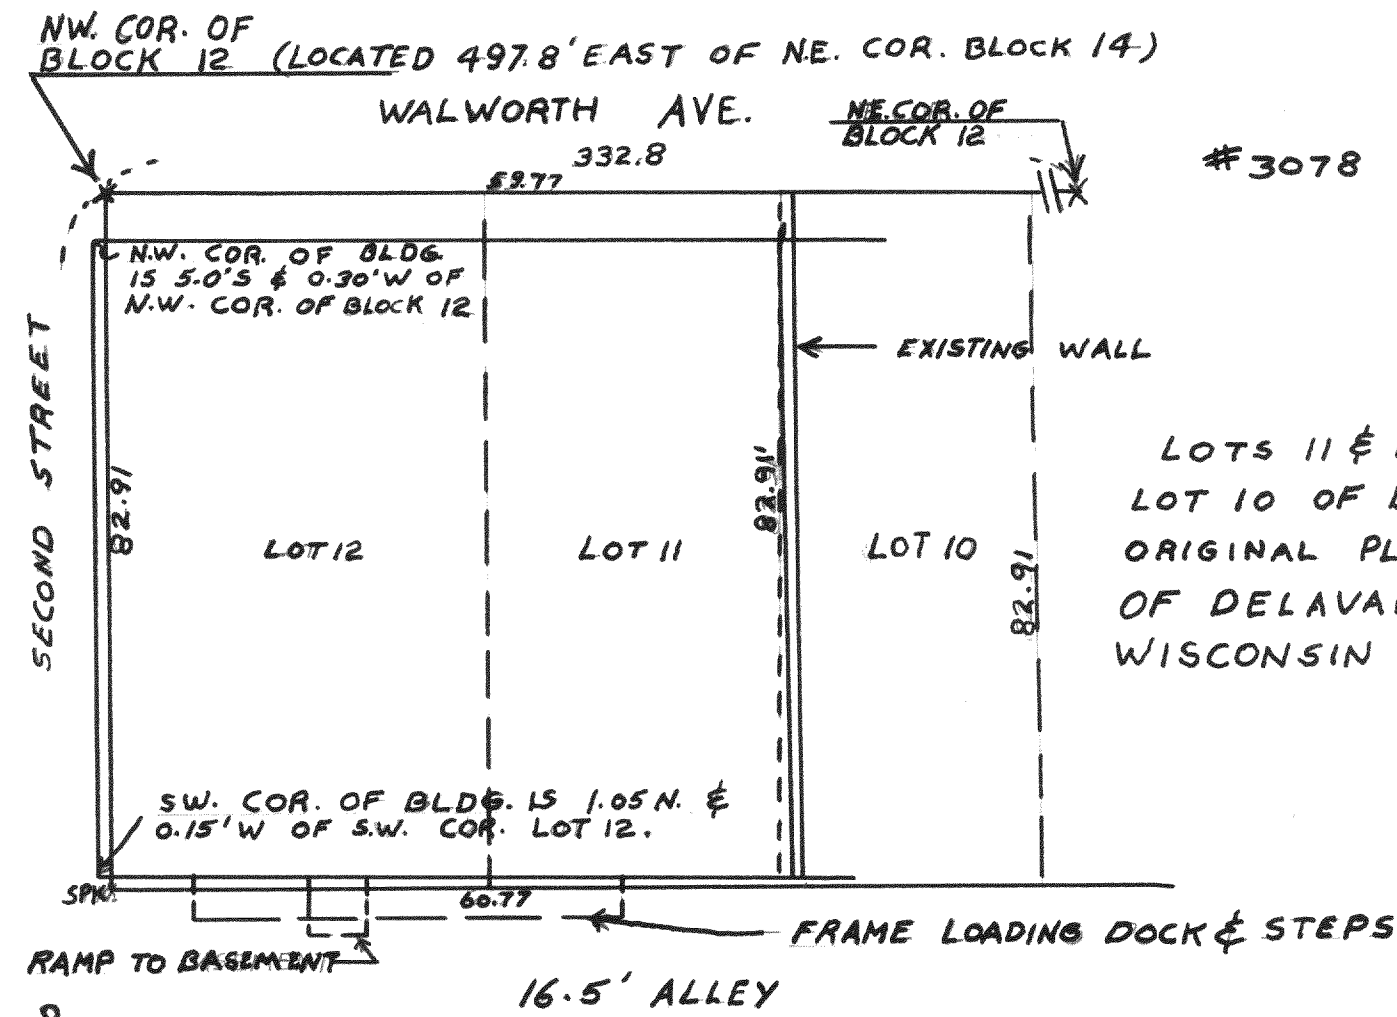


LOTS 11 & 12 AND PART OF
 LOT 10 OF BLOCK 12 OF THE
 ORIGINAL PLAT OF THE CITY
 OF DELAVAN, WALWORTH CO.,
 WISCONSIN

LLOYD L. JENSEN
 COUNTY SURVEYOR
 MARCH 14/56

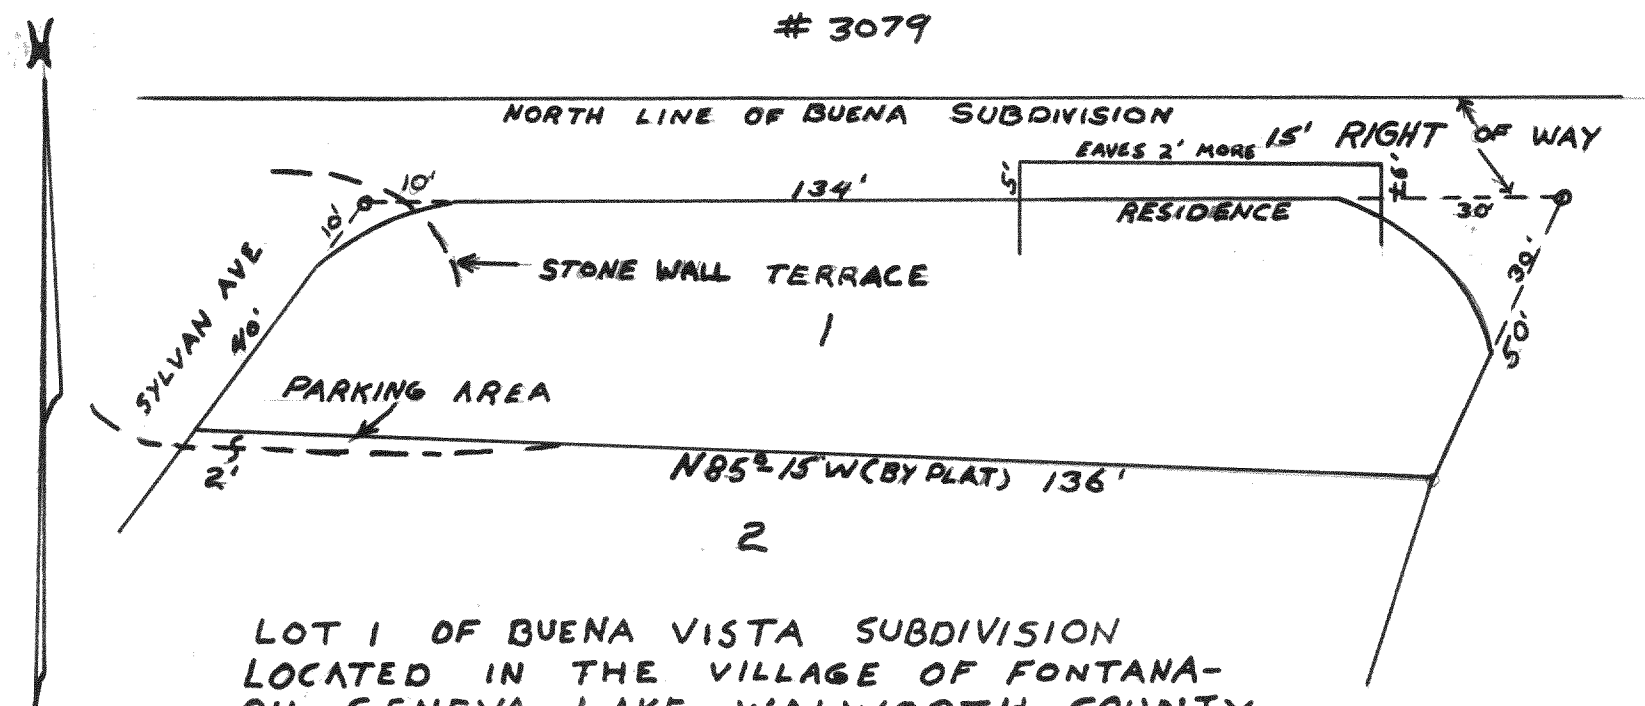

LOT 1 OF BUENA VISTA SUBDIVISION
 LOCATED IN THE VILLAGE OF FONTANA-
 ON-GENEVA LAKE, WALWORTH COUNTY
 WISC.
 MARCH 1956

LLOYD L. JENSEN
 COUNTY SURVEYOR

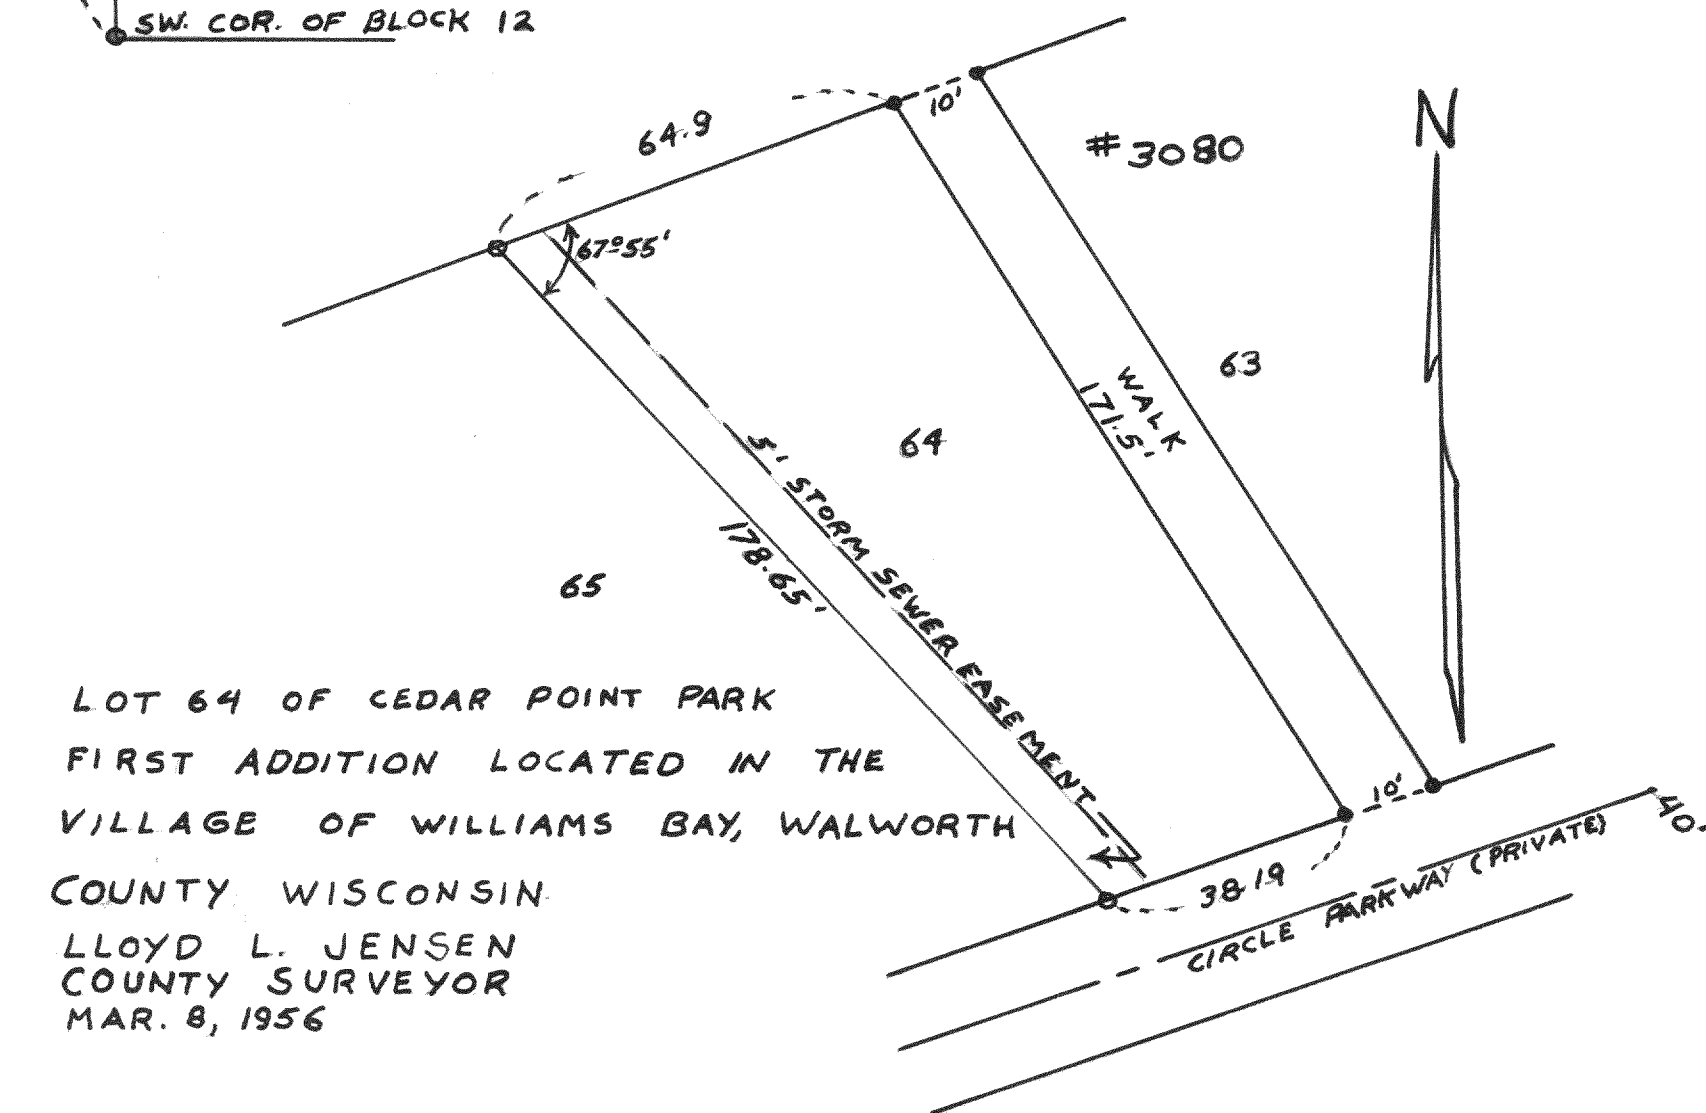

LOT 64 OF CEDAR POINT PARK
 FIRST ADDITION LOCATED IN THE
 VILLAGE OF WILLIAMS BAY, WALWORTH
 COUNTY WISCONSIN

LLOYD L. JENSEN
 COUNTY SURVEYOR
 MAR. 8, 1956