



#3096

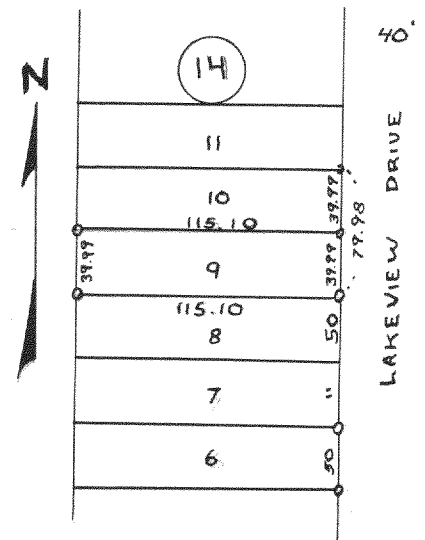


PLAT OF SURVEY OF LOT 9
BLOCK 14 SUNSET HILLS
WALWORTH COUNTY WISCONSIN
AUGUST 1955 LLOYD H. JENSEN
SURVEYOR

#3097

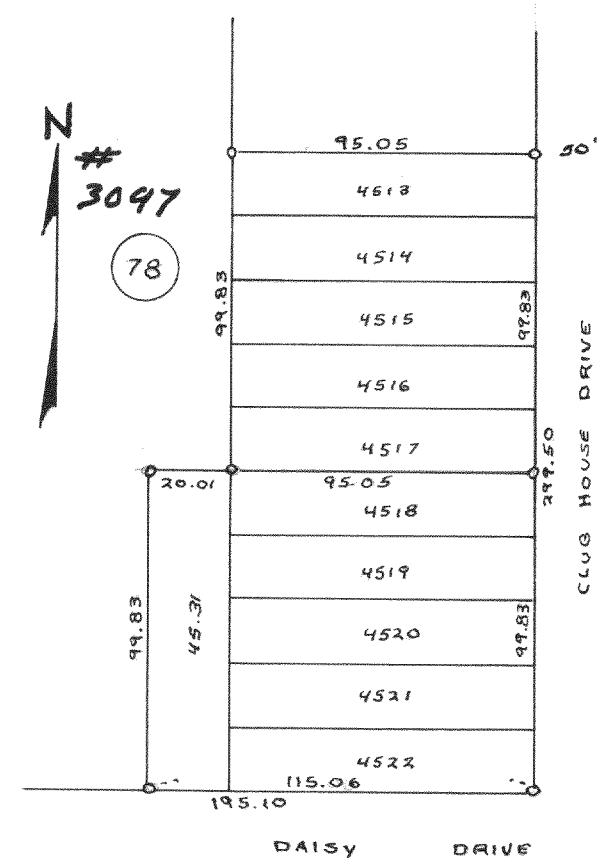


PLAT OF SURVEY OF LOTS
4513-4522 & 4537 BLOCK
78 LAKE COMO BEACH
WALWORTH COUNTY WISCONSIN
AUGUST 1955 LLOYD H. JENSEN
SURVEYOR

#3098

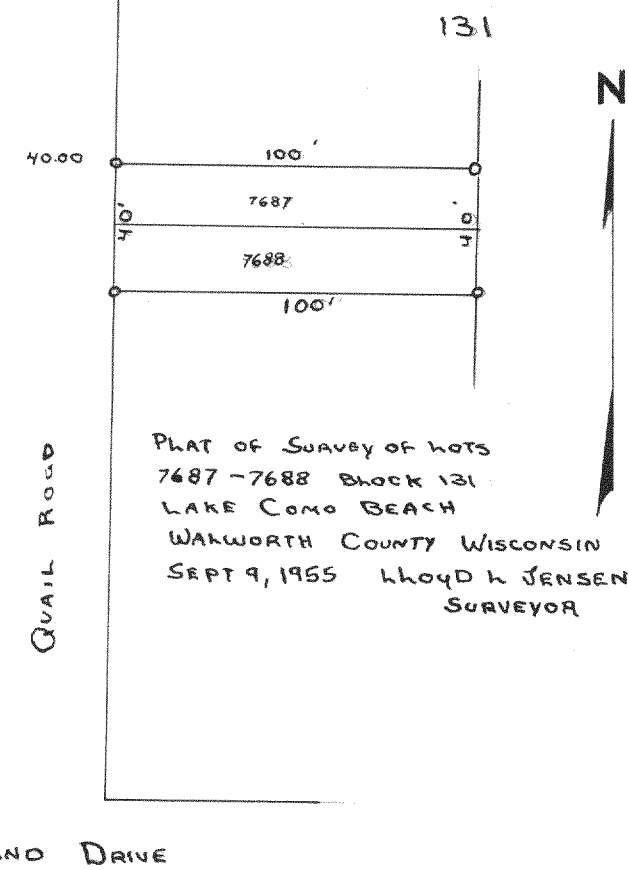


PLAT OF SURVEY OF LOTS
7687-7688 BLOCK 131
LAKE COMO BEACH
WALWORTH COUNTY WISCONSIN
SEPT 9, 1955 LLOYD H. JENSEN
SURVEYOR

#3099

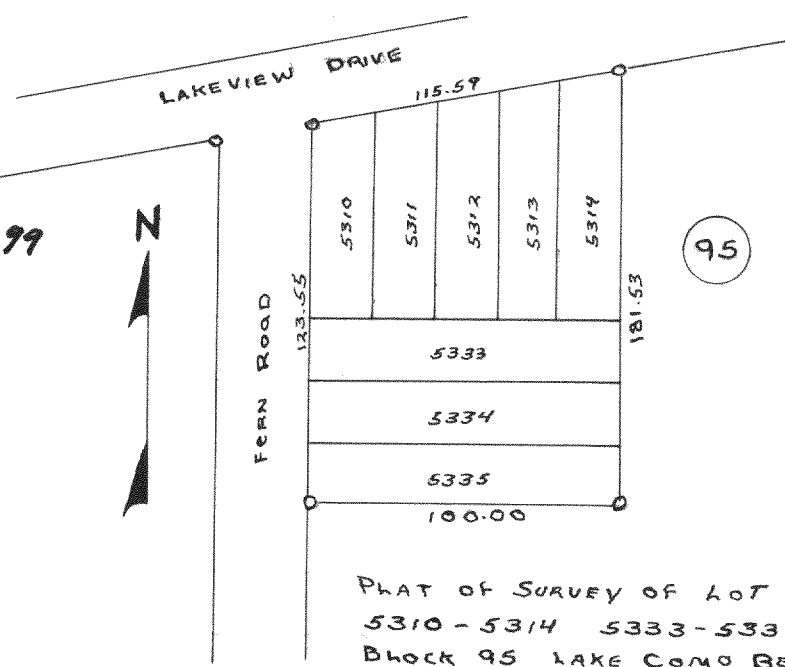


PLAT OF SURVEY OF LOT
5310-5314 5333-5335
BLOCK 95 LAKE COMO BEACH
WALWORTH COUNTY WISCONSIN
AUGUST 1955 LLOYD H. JENSEN
SURVEYOR

#3100

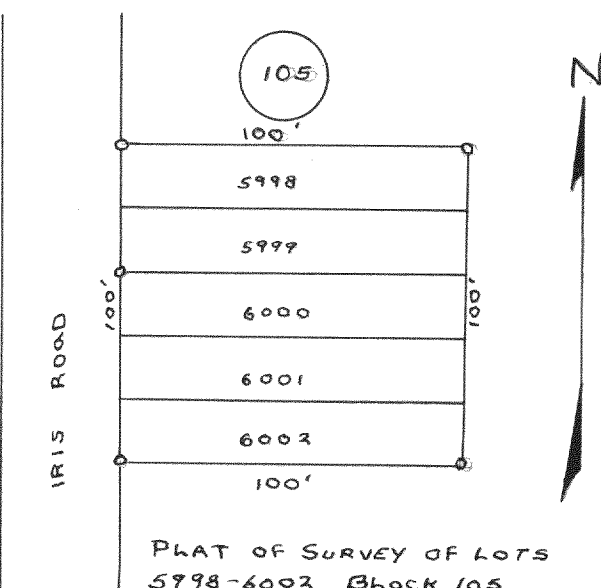

PLAT OF SURVEY OF LOTS
5998-6002 BLOCK 105
LAKE COMO BEACH WALWORTH
COUNTY WISCONSIN
SEPTEMBER 1955 LLOYD H. JENSEN
SURVEYOR

#3101

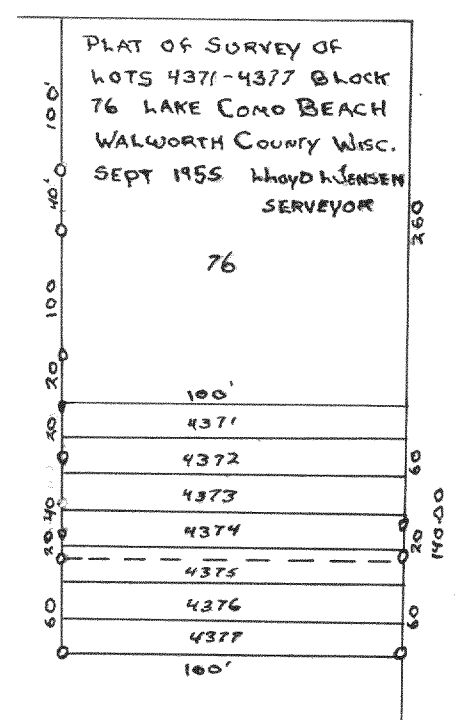

PLAT OF SURVEY OF
LOTS 4371-4377 BLOCK
76 LAKE COMO BEACH
WALWORTH COUNTY WISC.
SEPT 1955 LLOYD H. JENSEN
SURVEYOR