


# 2656

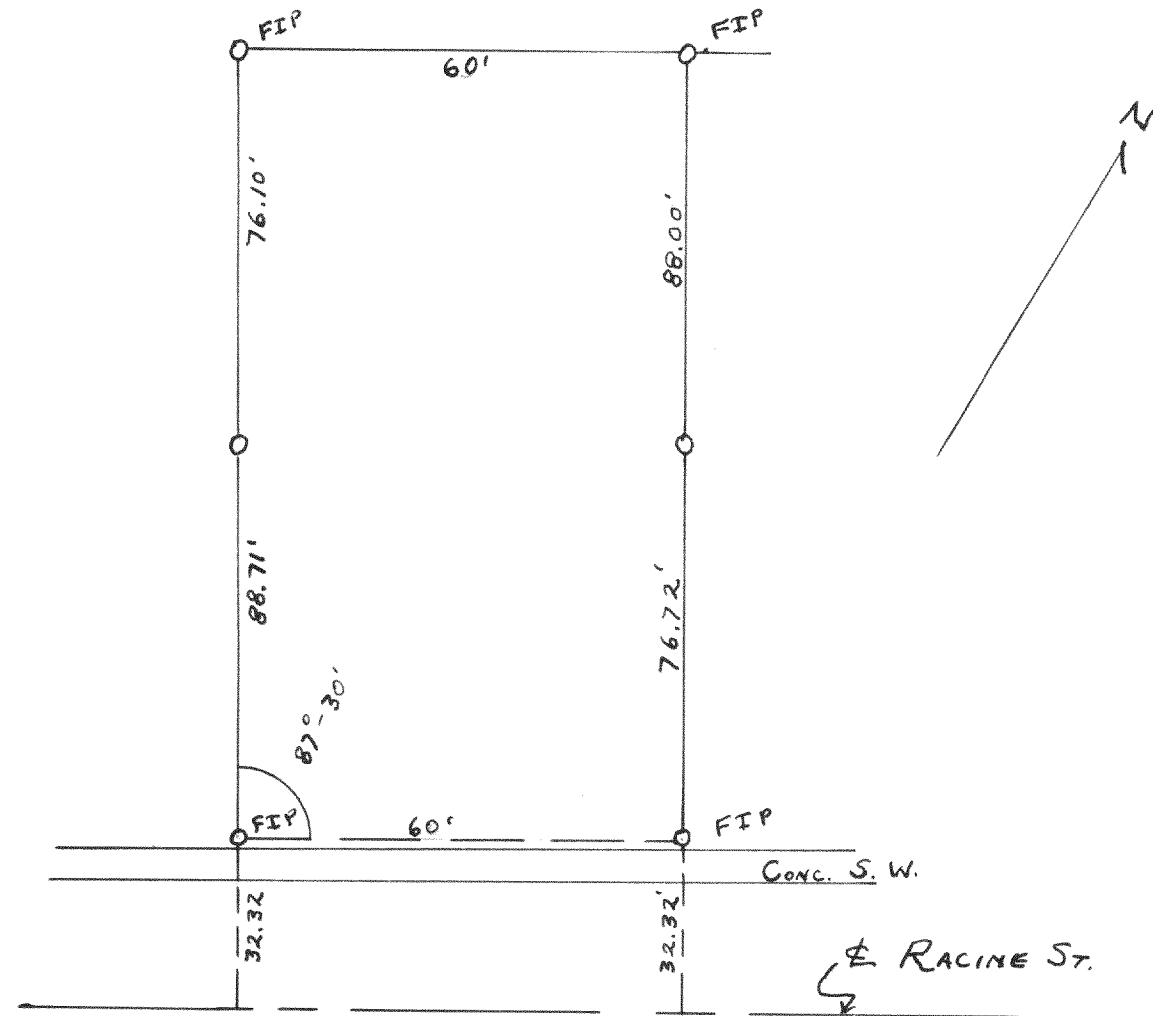


PLAT OF SURVEY OF PARCEL No. 35 OF THE CITY PLAT OF THE CITY OF DELAVAN

OCT 1, 1952

Lloyd L. Jensen

# 2658

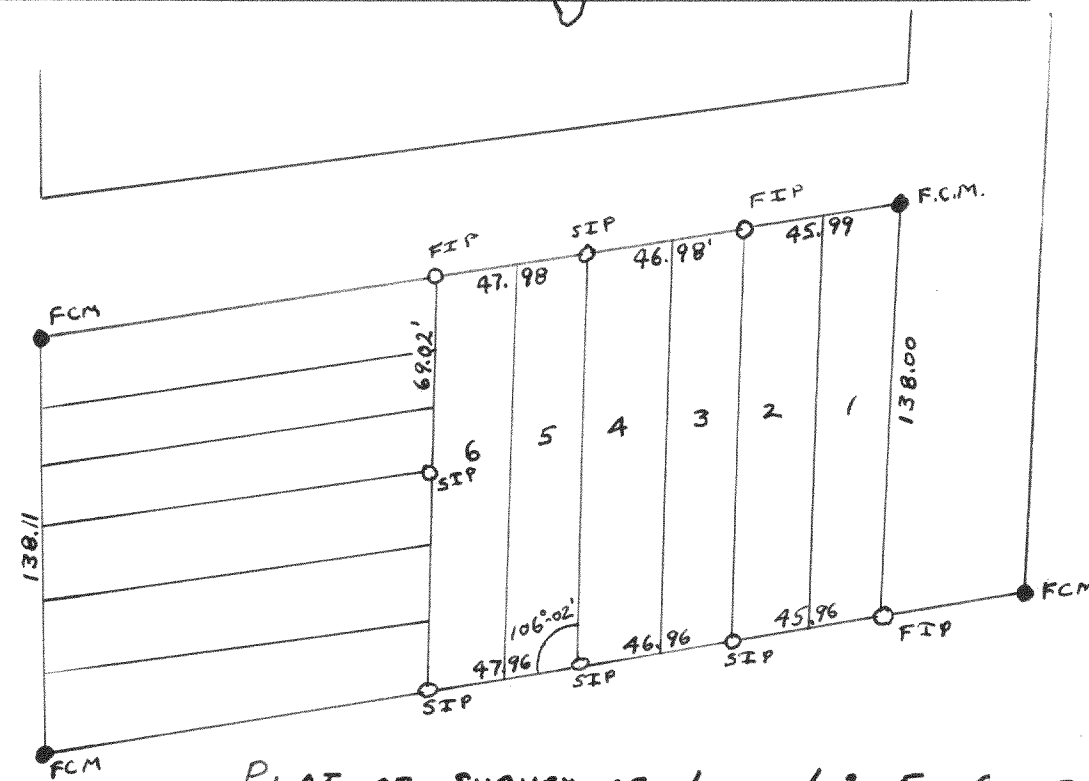


PLAT OF SURVEY OF LOTS 1, 2, 5 & 6 OF BLK 3 OF DELAVIEW SUBDIVISION IN THE CITY OF DELAVAN.

JUNE 27, 1952

LLOYD L. JENSEN COUNTY SURVEYOR

# 2657

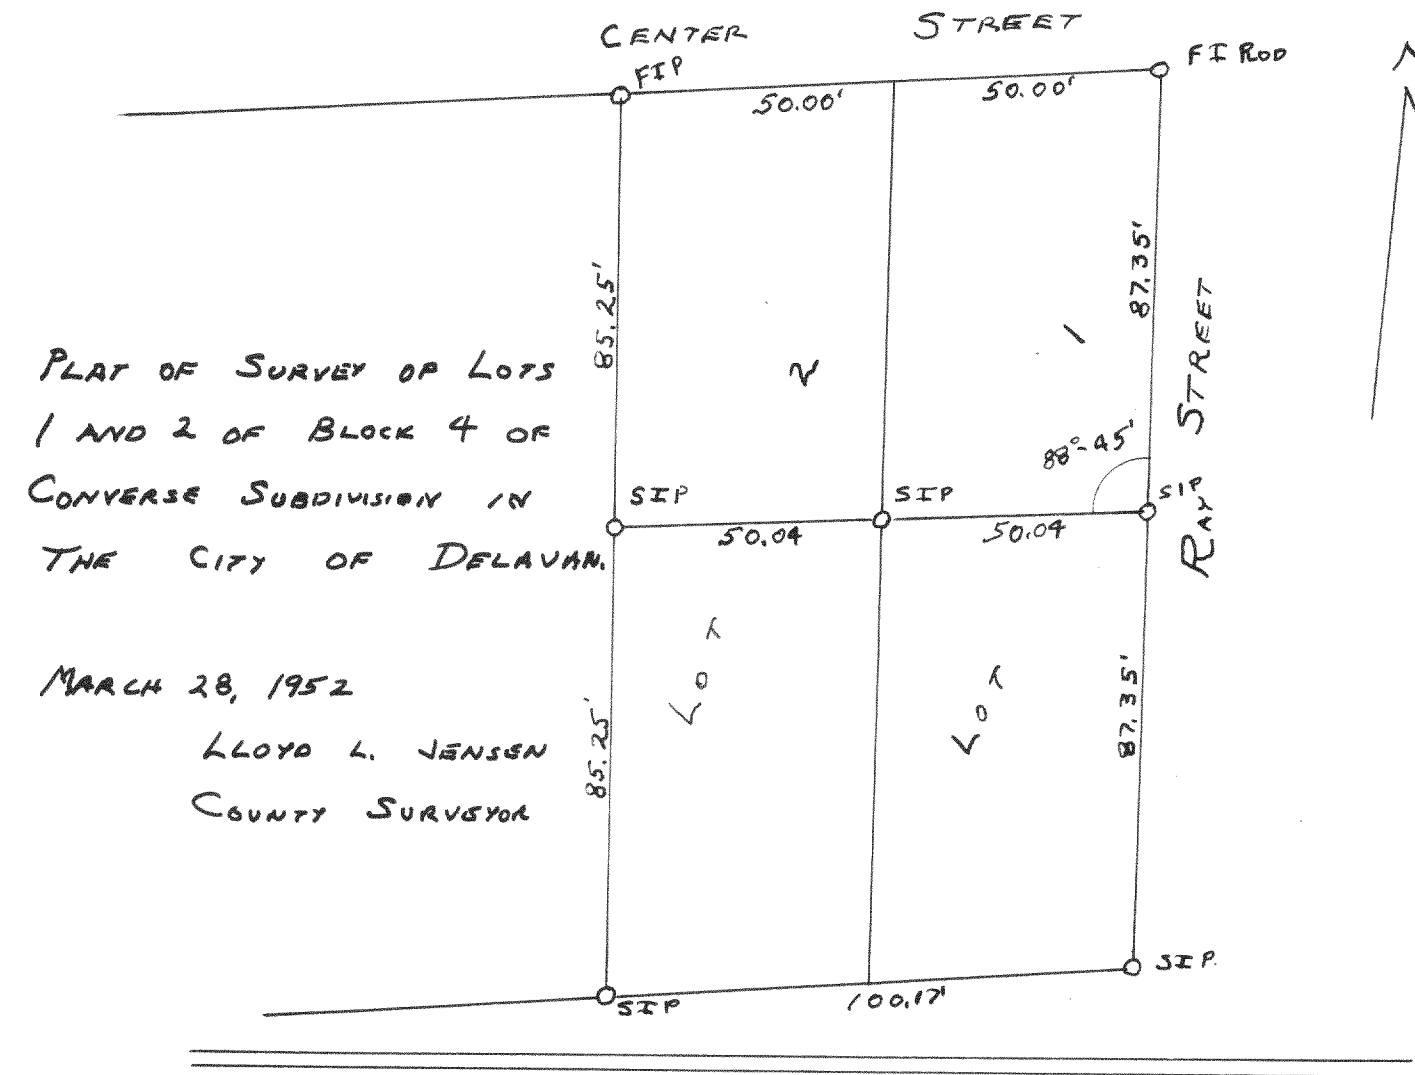


PLAT OF SURVEY OF LOTS 1 AND 2 OF BLOCK 4 OF CONVERSE SUBDIVISION IN THE CITY OF DELAVAN.

MARCH 28, 1952

LLOYD L. JENSEN COUNTY SURVEYOR

# 2659

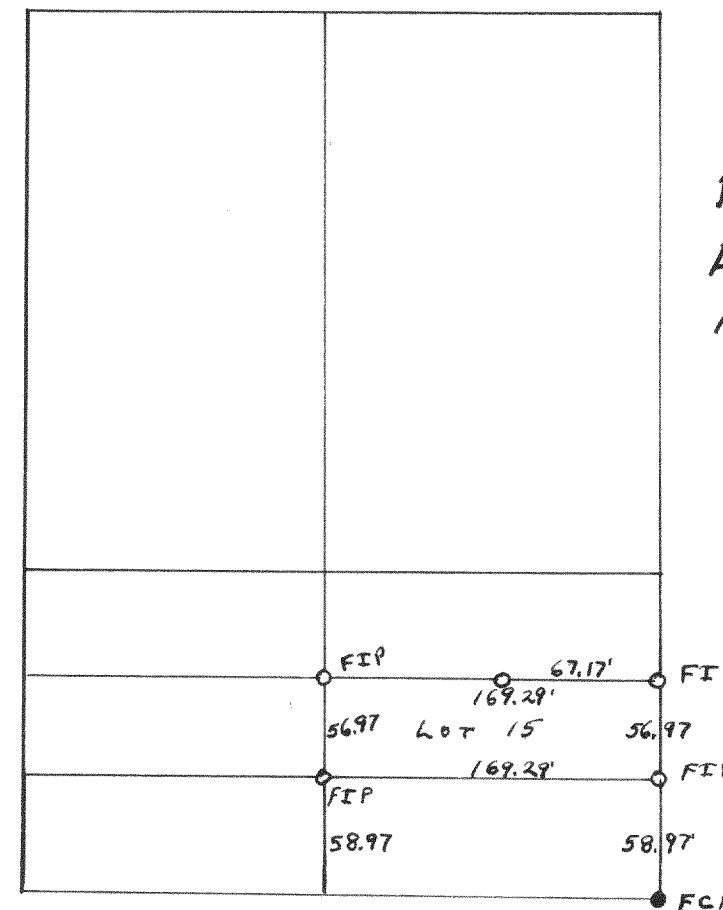

PLAT OF SURVEY OF LOT 15 OF BLOCK 3 OF FAIRVIEW HEIGHTS SUBD. DELAVAN.

JUNE 19, 1952

LLOYD L. JENSEN COUNTY SURVEYOR