



3128

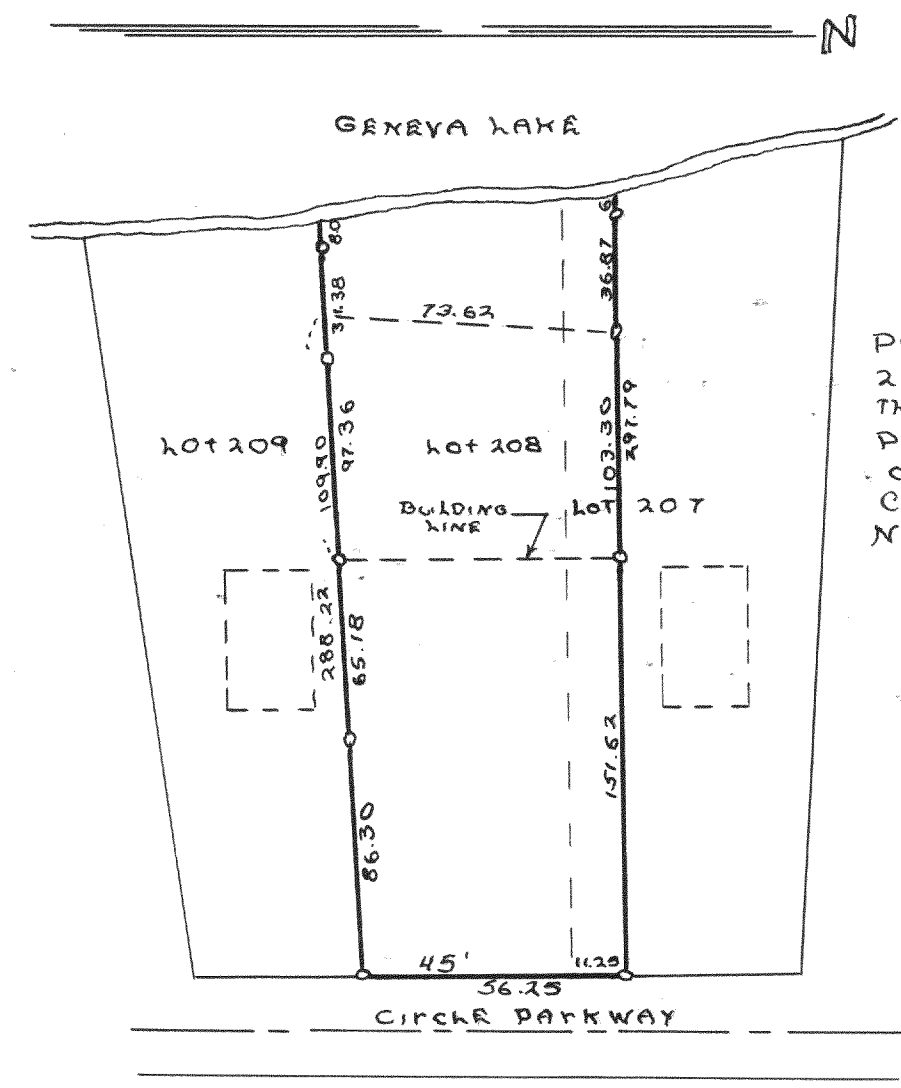

PLAT OF SURVEY OF LOT 208 & S¼ LOT 207 OF THE THIRD ADDITION TO CEDAR POINT PARK IN THE VILLAGE OF WILLIAMS BAY, WALWORTH COUNTY, WISCONSIN NOV. 1956
LLOYD L. JENSEN
SURVEYOR


3129

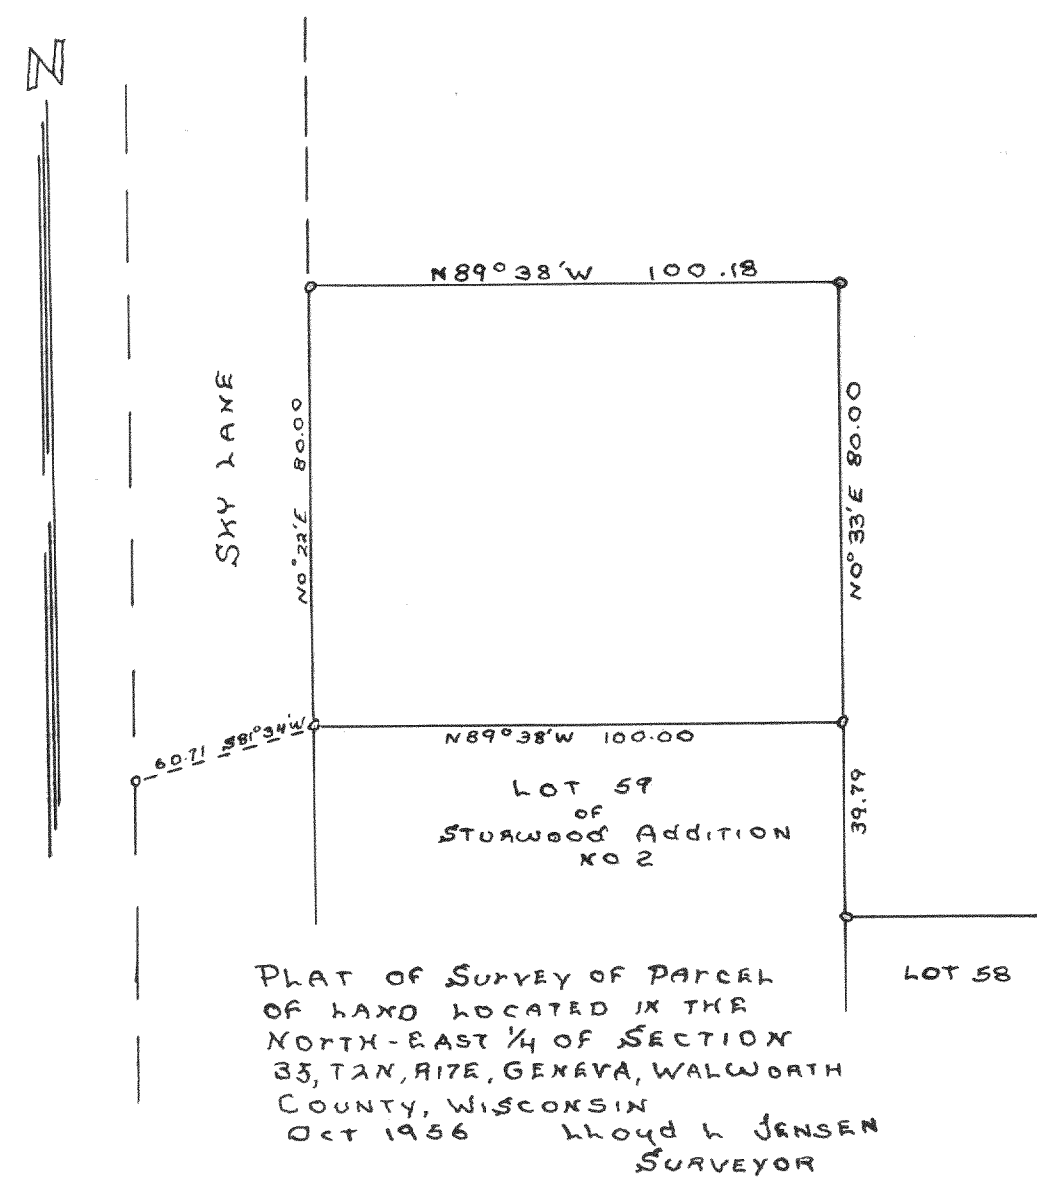

PLAT OF SURVEY OF PARCEL OF LAND LOCATED IN THE NORTH-EAST ¼ OF SECTION 35, T2N, R17E, GENAYA, WALWORTH COUNTY, WISCONSIN OCT 1956
LLOYD L. JENSEN
SURVEYOR


PLAT OF SURVEY OF LAND IN BLOCK 13 OF THE CITY OF WHITEWATER, WISCONSIN AND PLAT OF LAND DRAWN FROM DESCRIPTIONS DEC, 1956
LLOYD L. JENSEN
SURVEYOR

3130

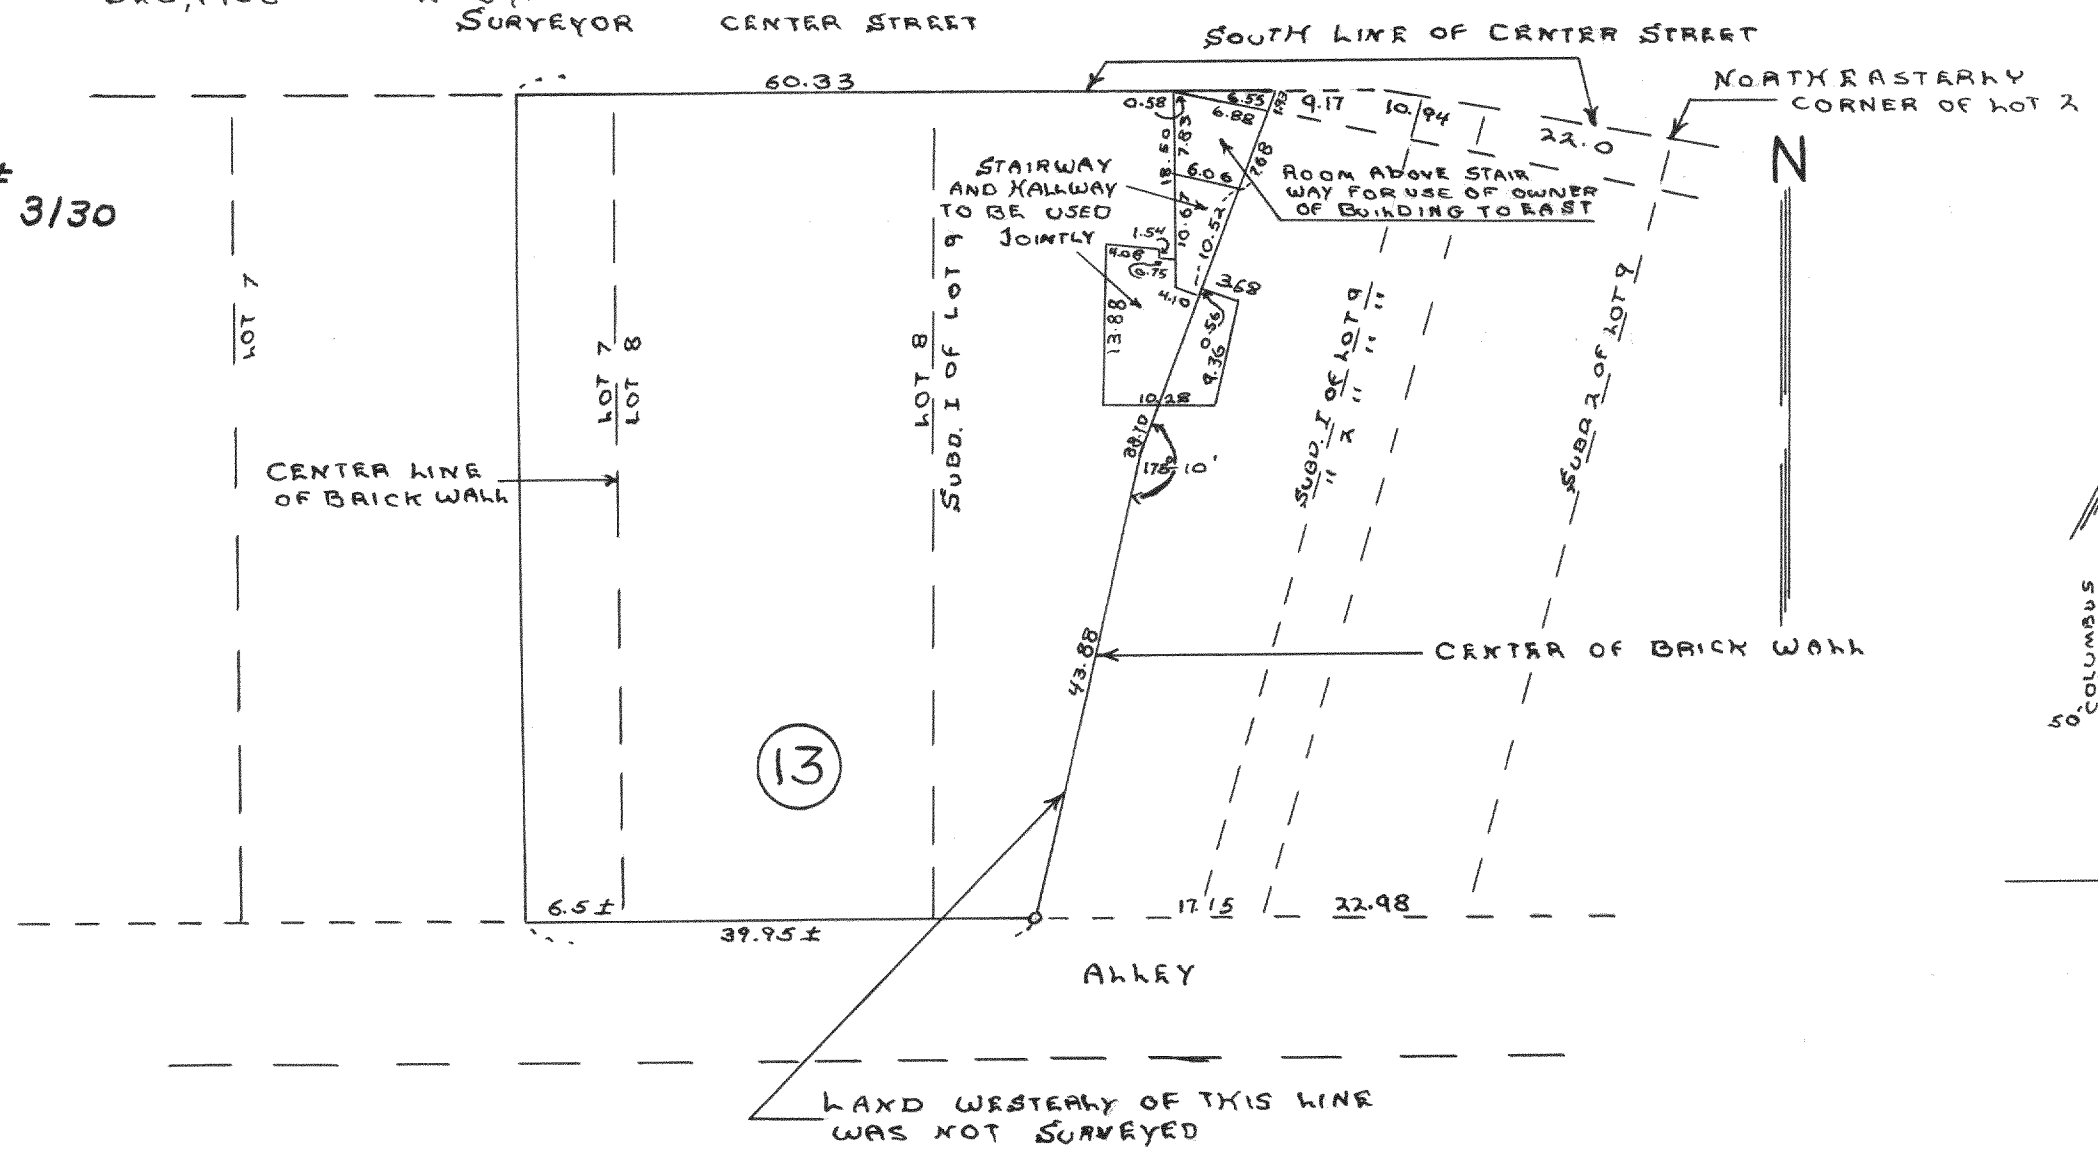

LAND WESTERLY OF THIS LINE WAS NOT SURVEYED

3131

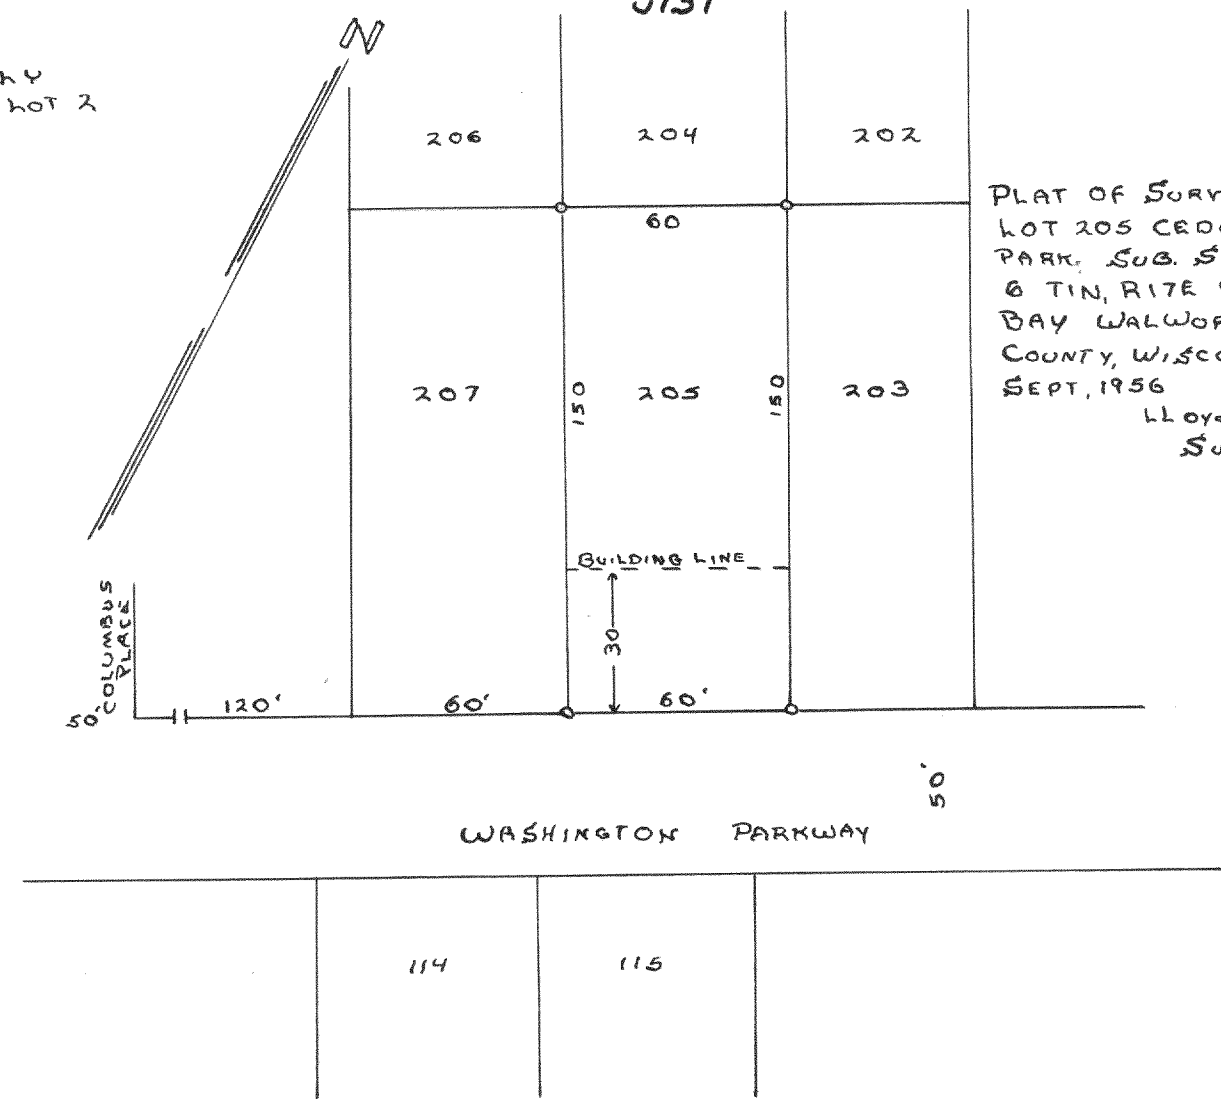

PLAT OF SURVEY OF LOT 205 CEDAR POINT PARK, SUB. SECTION 6 T1N, R17E WILLIAMS BAY WALWORTH COUNTY, WISCONSIN SEPT, 1956
LLOYD L. JENSEN
SURVEYOR