



PLAT OF SURVEY OF PART OF LOT 9 AND LOT 10 OF ADDITION "D" TO COUNTRY CLUB ESTATES LOCATED IN THE VILLAGE OF FONTANA ON GENEVA LAKE WALWORTH COUNTY WIS. 11-1-56 LLOYD L. JENSEN SURVEYOR

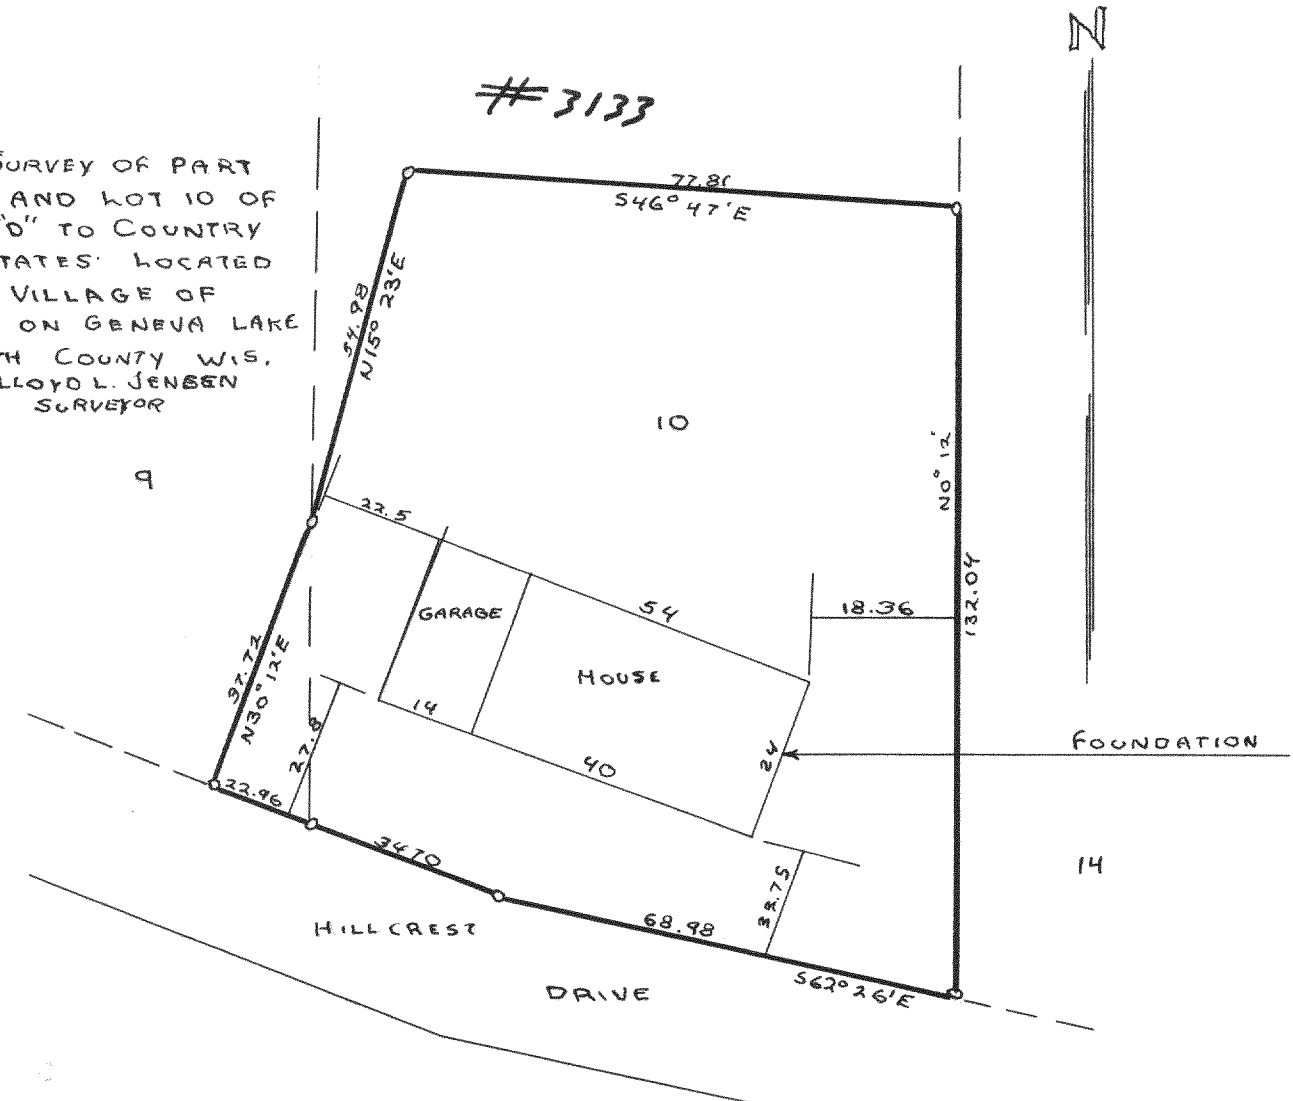

PLAT OF SURVEY OF PARCEL OF LAND LOCATED IN THE SOUTHEAST 1/4 OF SECTION 33, T2N, R17E, GENEVA WALWORTH COUNTY, WISCONSIN OCT 1956 LLOYD L. JENSEN SURVEYOR

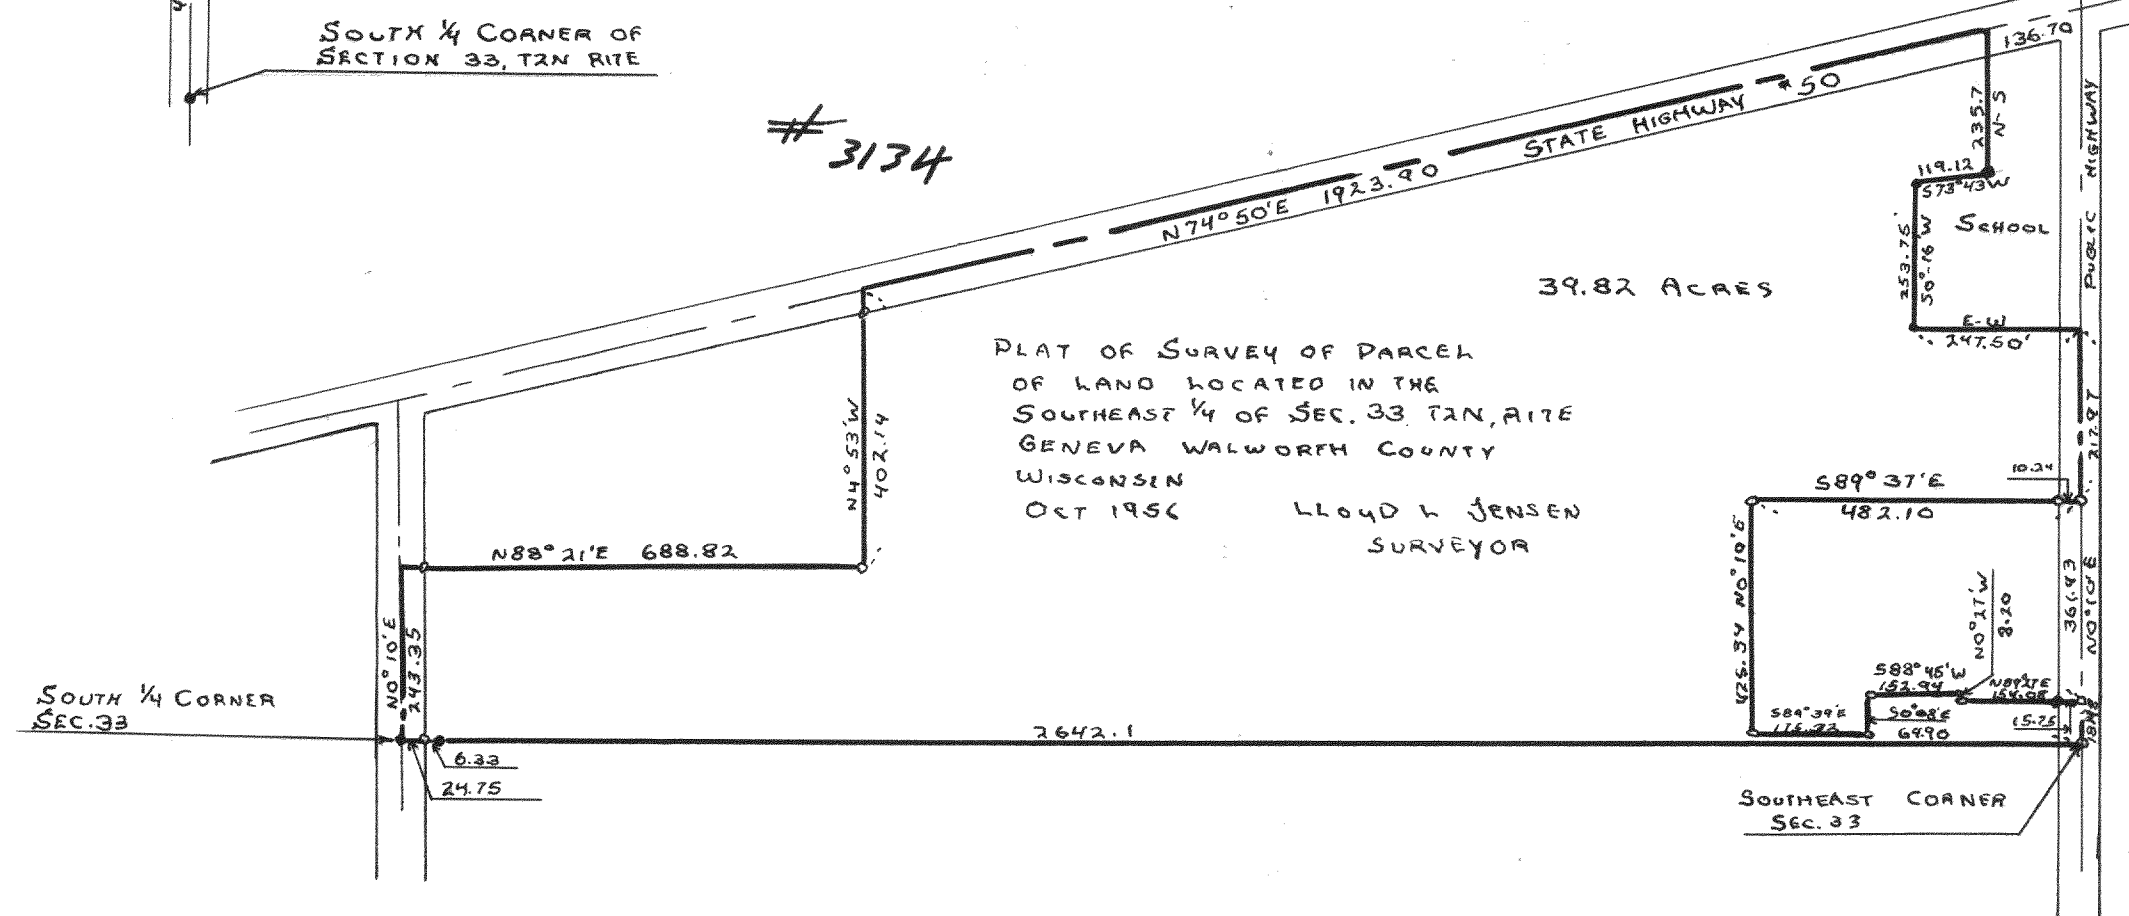

PLAT OF SURVEY OF LOT 15 OF THE 1ST ADDITION TO CEDAR POINT PARK VILLAGE OF WILLIAMS BAY SEC. 6 T1N R17E WALWORTH COUNTY WISCONSIN DEC. 1956 LLOYD L. JENSEN SURVEYOR

