


136

#3166

PLAT OF SURVEY OF LOT 1, BLOCK D, CISCO
BEACH SUBDIVISION, SEC. 6, T1N, R17E,
WALWORTH COUNTY, WISCONSIN
JULY 1956 LLOYD L. JENSEN
SURVEYOR

SHORE VIEW DRIVE

35'

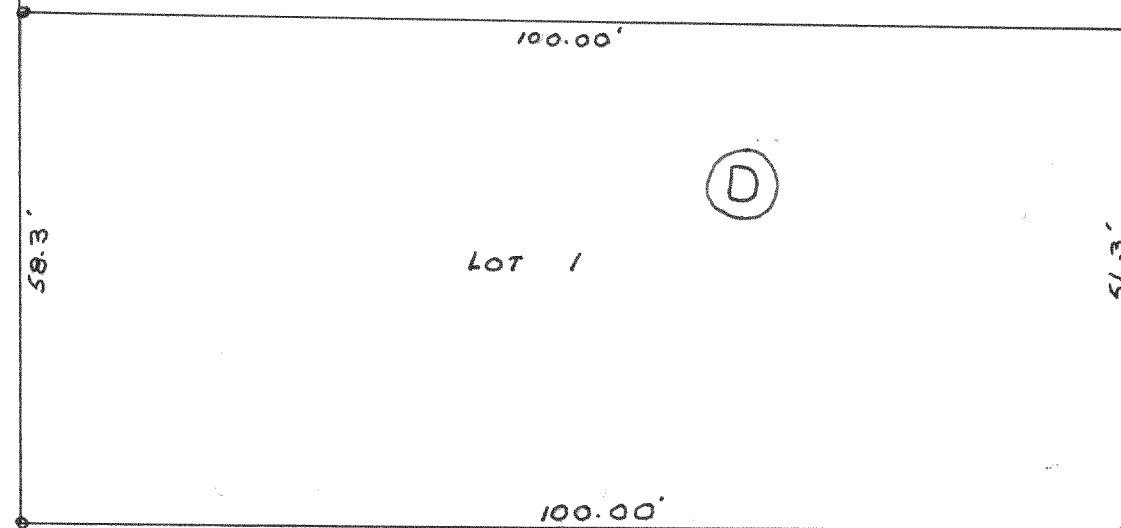

ORIOLE LANE

GENEVA LAKE

#3168

LOT 208

8' 31.38 97.36 288.27 65.18 86.30

LOT 209

59.76


7 37.72 82.68 59.98 92.42 279.20

LOT 210

PLAT OF SURVEY OF GRIDE OF LOT 209, THIRD ADDITION
TO CEDAR POINT PARK, VILLAGE OF WILLIAMS BAY
WALWORTH COUNTY WISCONSIN
AUGUST 1956 LLOYD L. JENSEN
SURVEYOR

#3167

DRIVEWAY

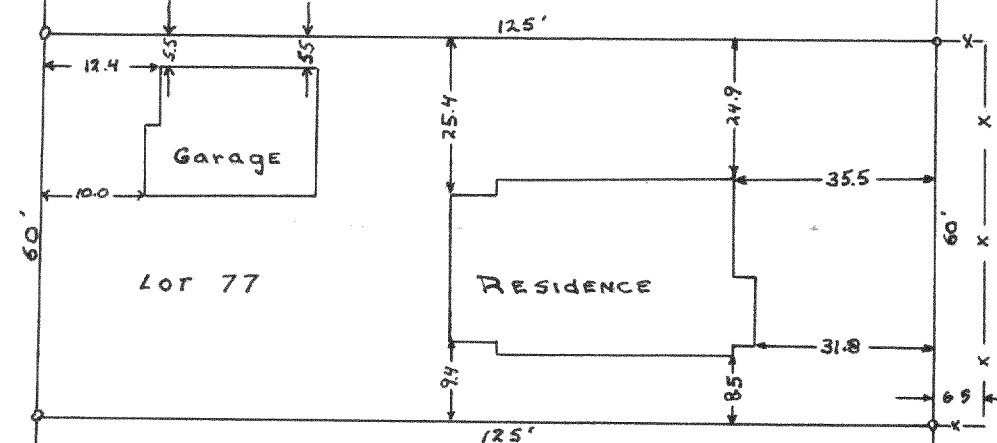

LOT 78

STATE OF WISCONSIN } SS
COUNTY OF WALWORTH }

I, LLOYD L. JENSEN, DO
HEREBY CERTIFY THAT I HAVE SURVEYED THE
PROPERTY DESCRIBED HEREON ACCORDING TO THE
OFFICIAL RECORDS, AND THAT THE PLAT HEREON IS
A CORRECT REPRESENTATION OF THE LOT LINES
AND PRINCIPAL LINES OF BUILDINGS THEREON
ELKHORN, WISCONSIN LLOYD L. JENSEN
AUGUST 1956 SURVEYOR

PLAT OF SURVEY OF LOT 77
CEDAR POINT PARK SUBDIVISION
SEC. 6, T1N, R17E, WILLIAMS BAY
WALWORTH COUNTY, WISCONSIN
AUGUST 1956 LLOYD L. JENSEN
SURVEYOR

40 FT. DRIVEWAY