




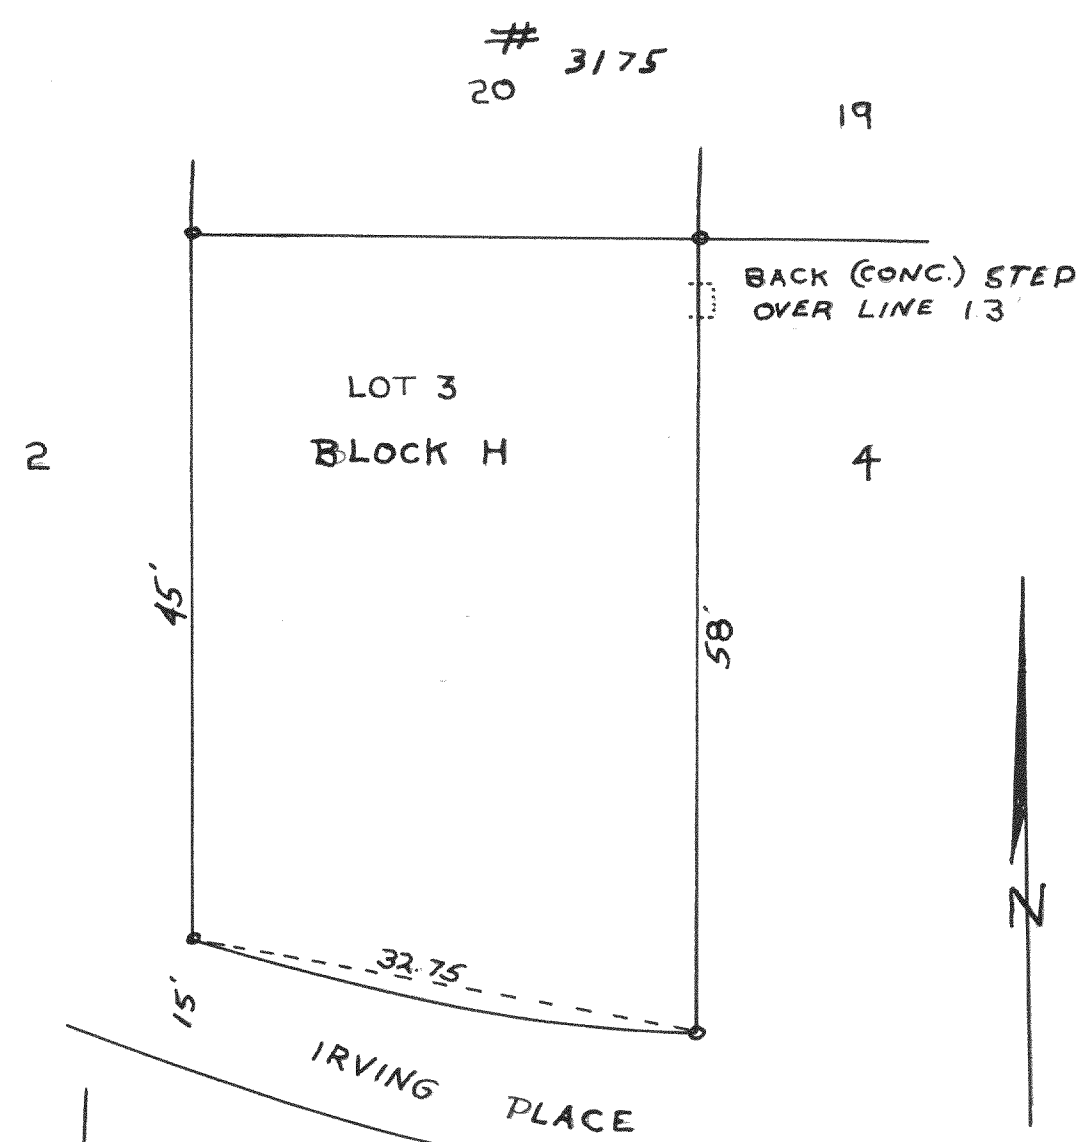


PLAT OF SURVEY OF LOT 3 OF
BLOCK H. OF DELAVAN LAKE ASSEMBLY
GROUNDS LOCATED IN T2N R16E
WALWORTH COUNTY, WISCONSIN
LLOYD L. JENSEN
COUNTY SURVEYOR
MAY 1956

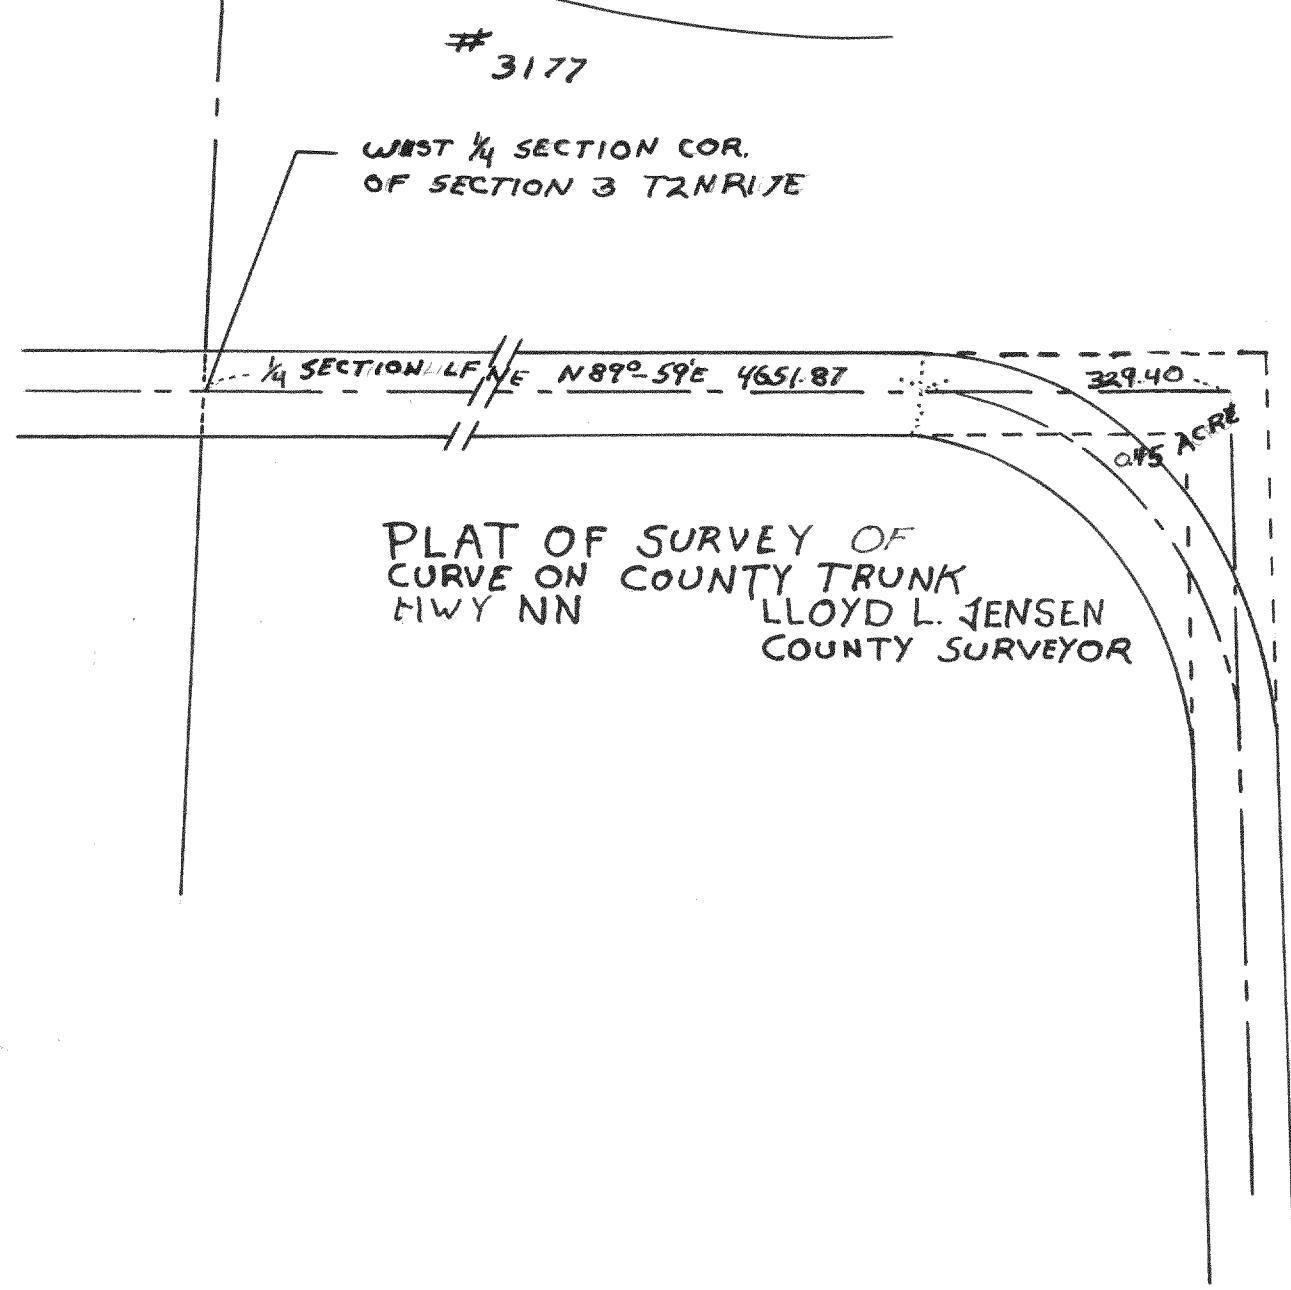

PLAT OF SURVEY OF
CURVE ON COUNTY TRUNK
HWY NN
LLOYD L. JENSEN
COUNTY SURVEYOR
JUNE 2, 1956

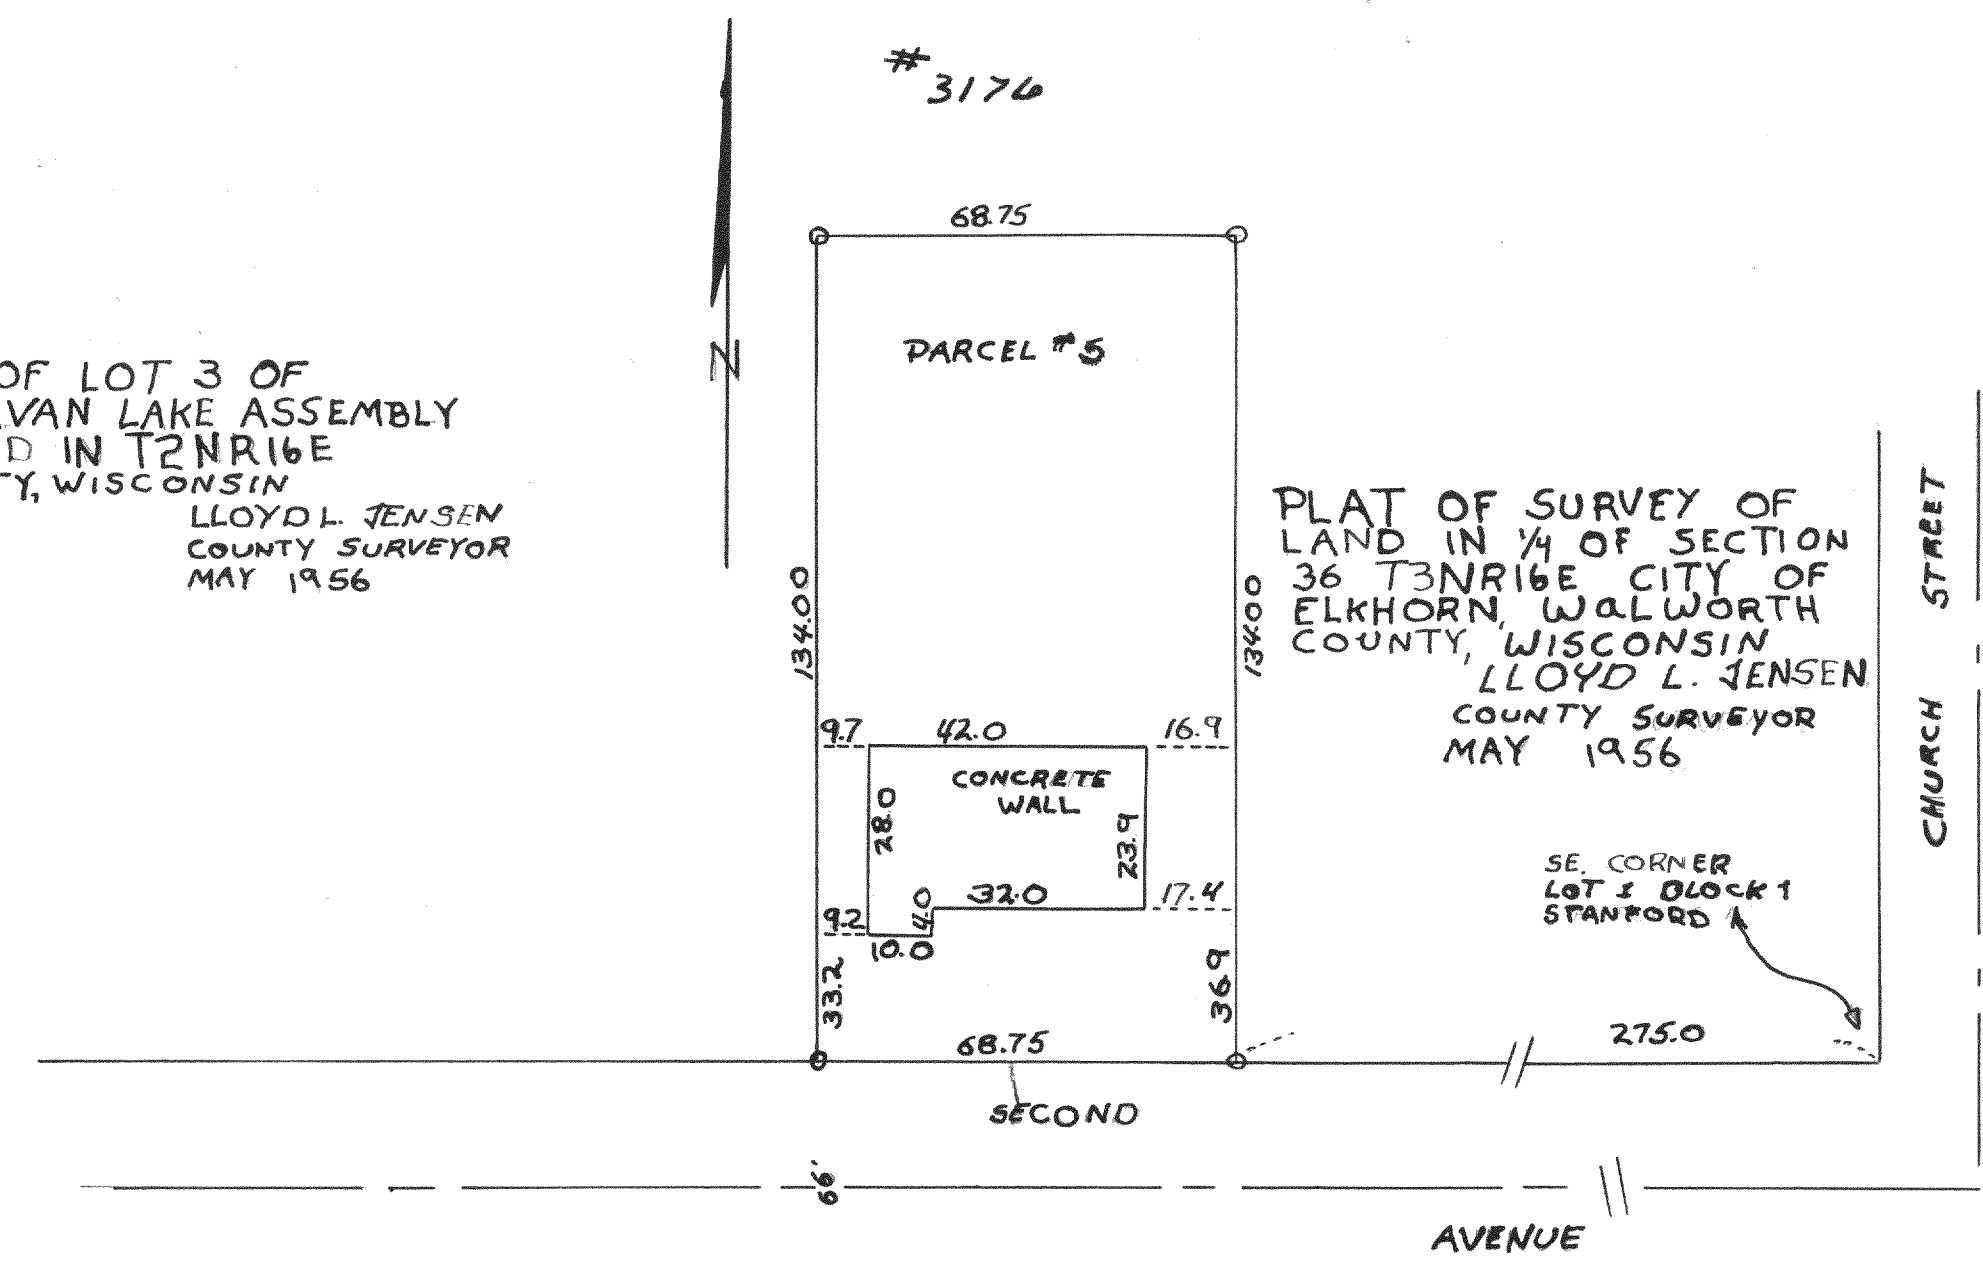

PLAT OF SURVEY OF
LAND IN 1/4 OF SECTION
36 T3N R16E CITY OF
ELKHORN, WALWORTH
COUNTY, WISCONSIN
LLOYD L. JENSEN
COUNTY SURVEYOR
MAY 1956

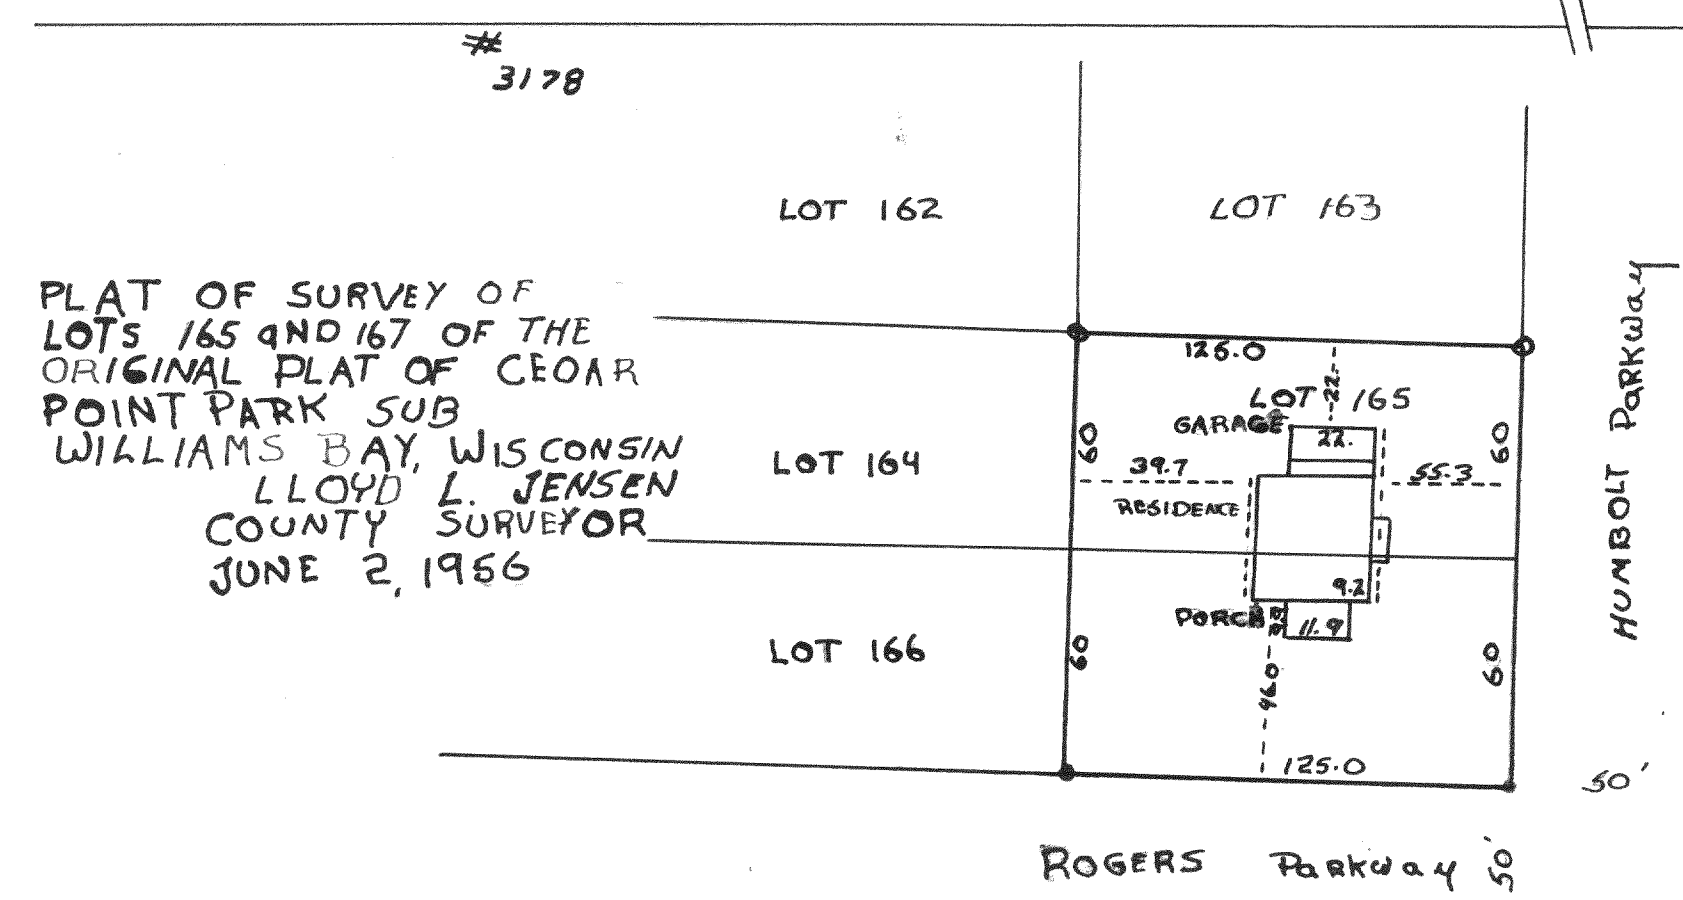

PLAT OF SURVEY OF
LOTS 165 AND 167 OF THE
ORIGINAL PLAT OF CEDAR
POINT PARK SUB
WILLIAMS BAY, WISCONSIN
LLOYD L. JENSEN
COUNTY SURVEYOR
JUNE 2, 1956