



#3181

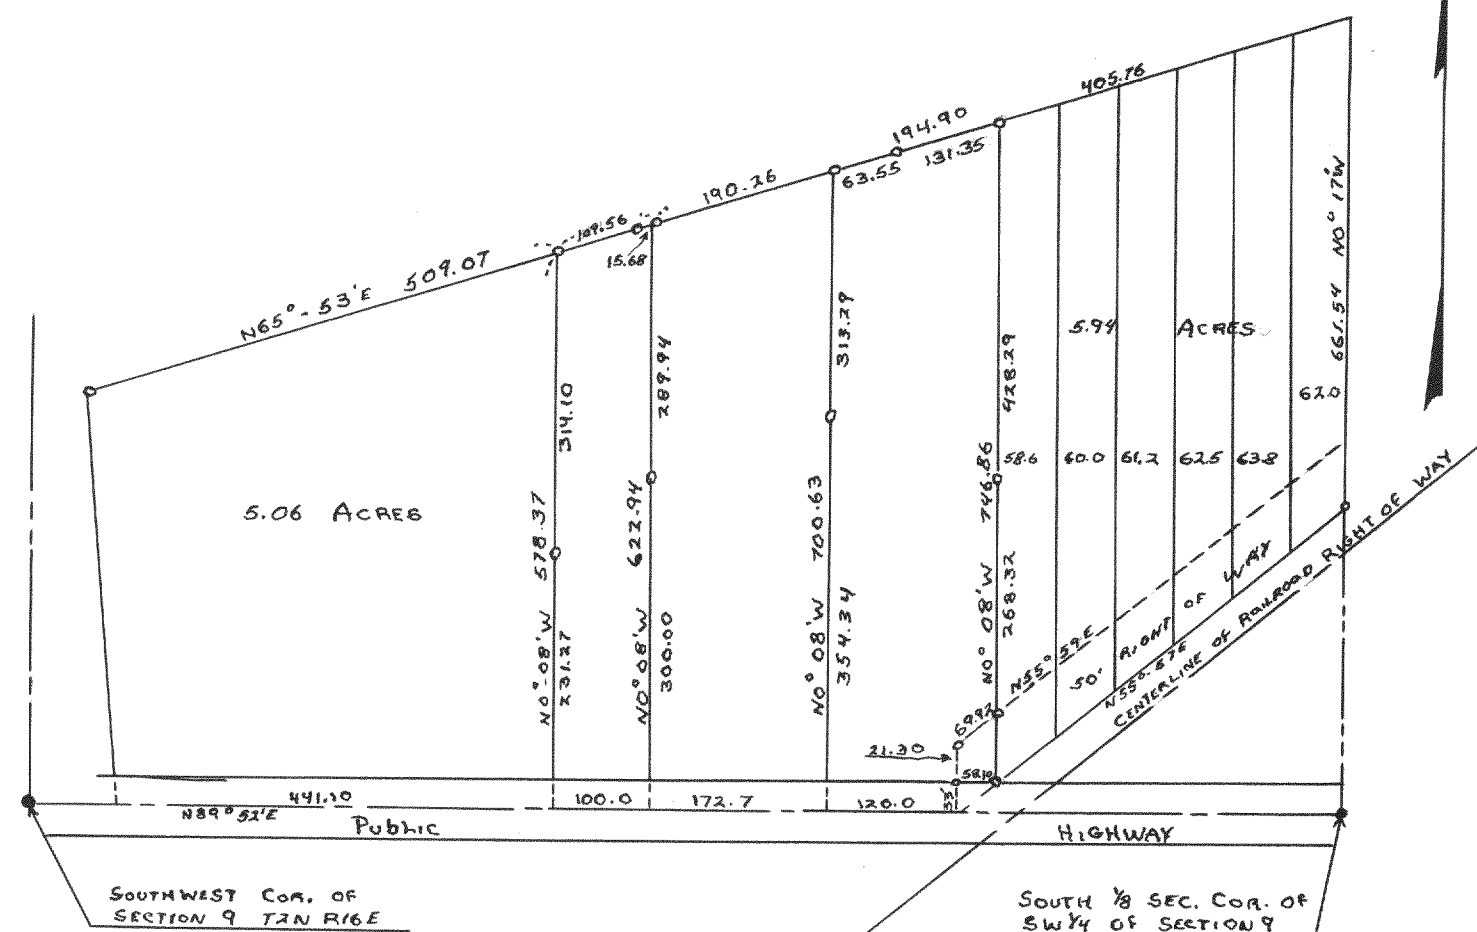


PLAT OF SURVEY OF PARCEL OF LAND
LOCATED IN THE SW 1/4 OF SEC. 9 T2N R16E
WALWORTH COUNTY WISCONSIN
FEB 1957 LLOYD L JENSEN
SURVEYOR

#3183

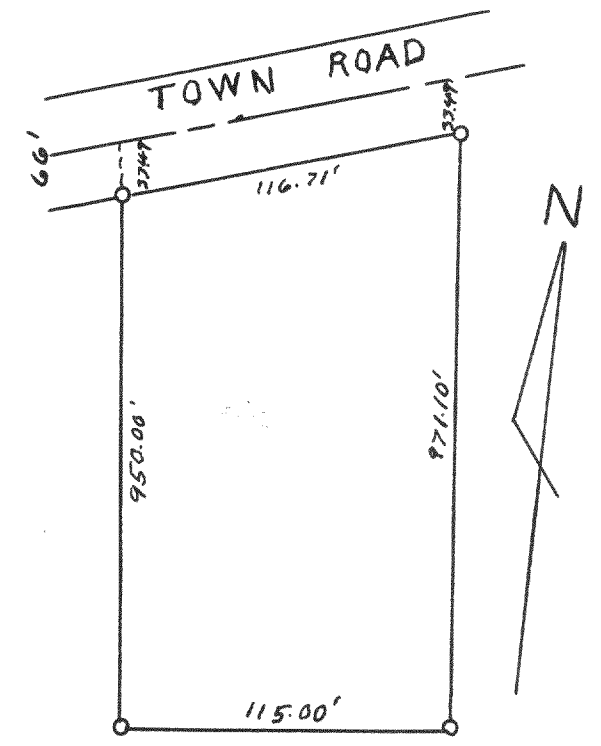


PLAT OF SURVEY OF LAND IN
NW 1/4 SE 1/4 SECTION 11 T2N R16E
WALWORTH COUNTY WISCONSIN
FEB. 1957 LLOYD L. JENSEN
SURVEYOR

#3184

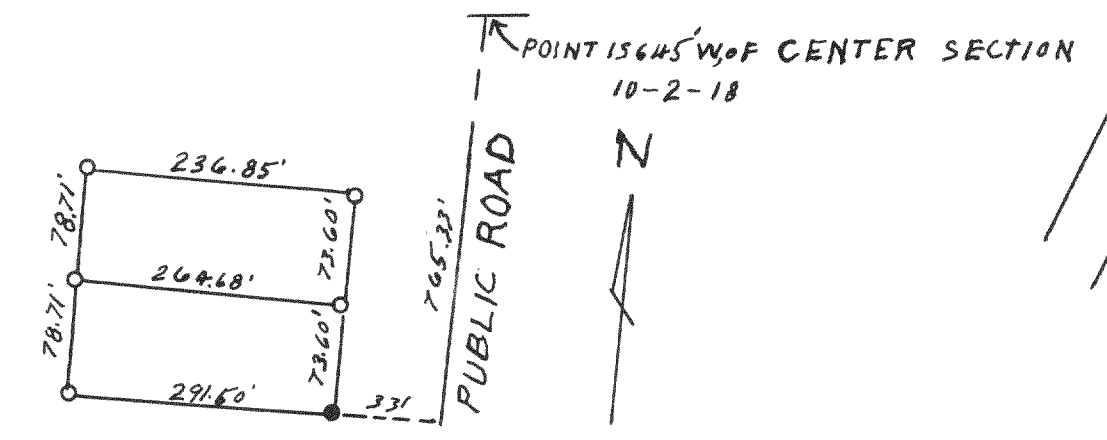


PLAT OF SURVEY OF LAND IN
SECTION 10 T2N R16E
WALWORTH COUNTY WISCONSIN
NOV. 1956 LLOYD L. JENSEN
SURVEYOR

#3182

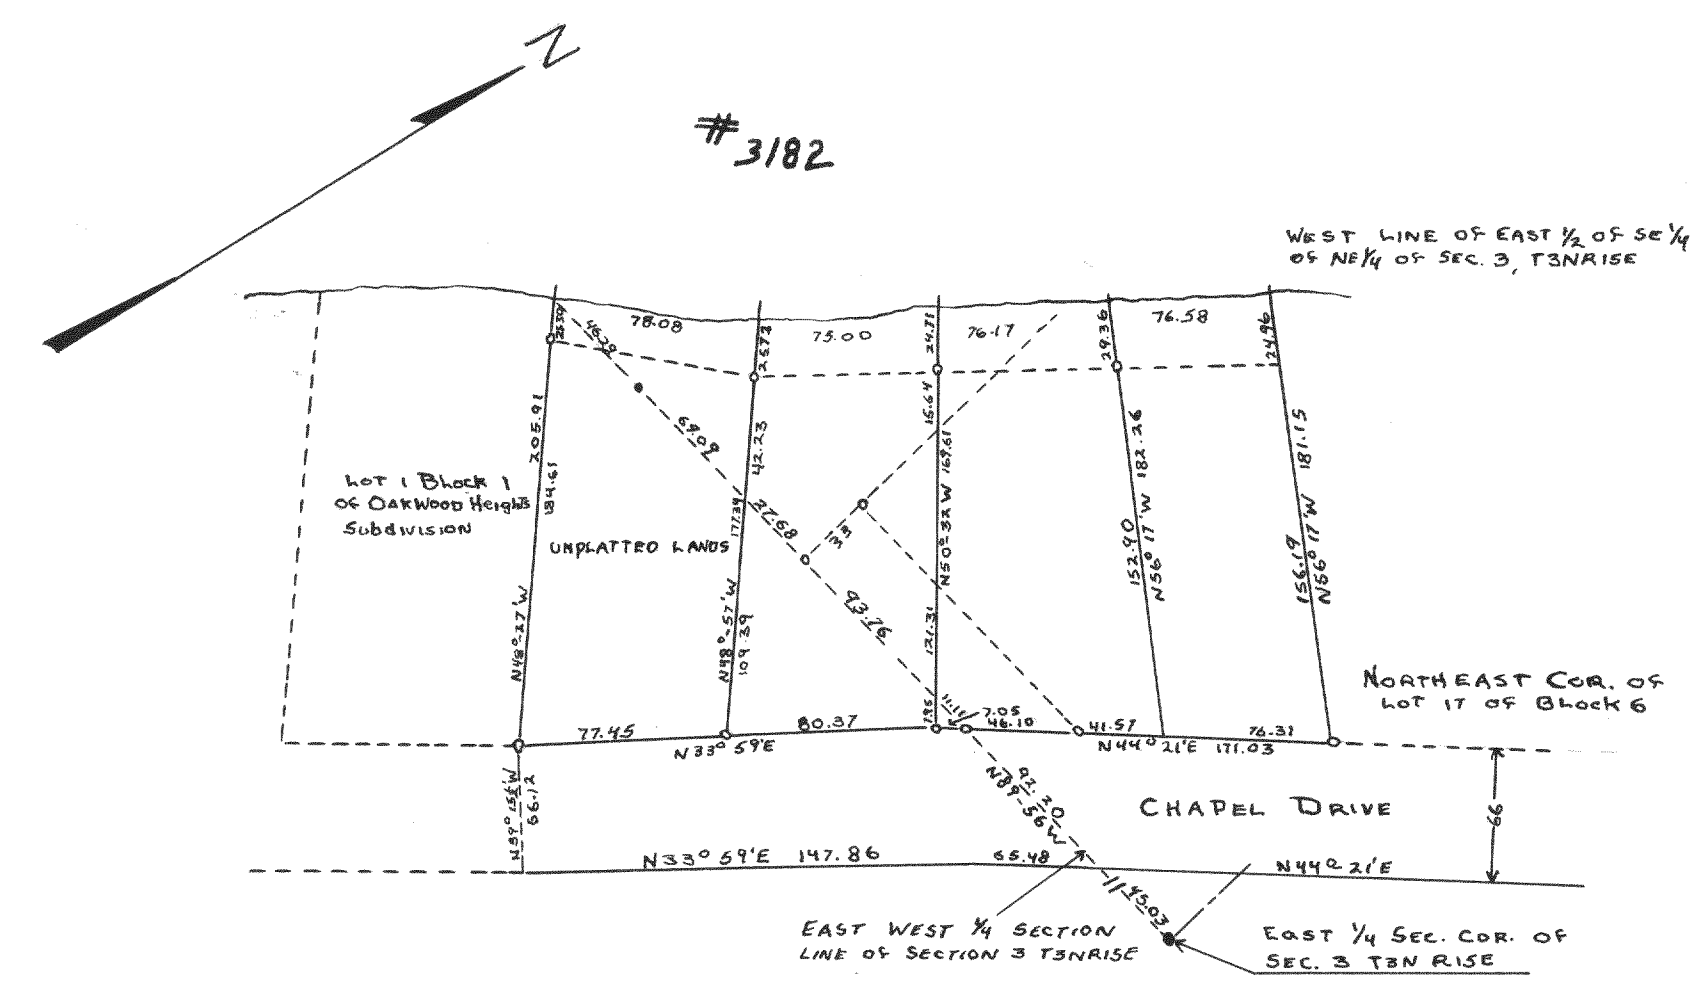


PLAT OF SURVEY OF LOT 17 OF CHAPEL
HILLS SUBDIVISION AND UNPLATTED LAND IN
THE EAST 1/2 OF SEC. 3 T2N R16E OF
WALWORTH COUNTY WISCONSIN
FEB 1957 LLOYD L JENSEN
SURVEYOR

#3185

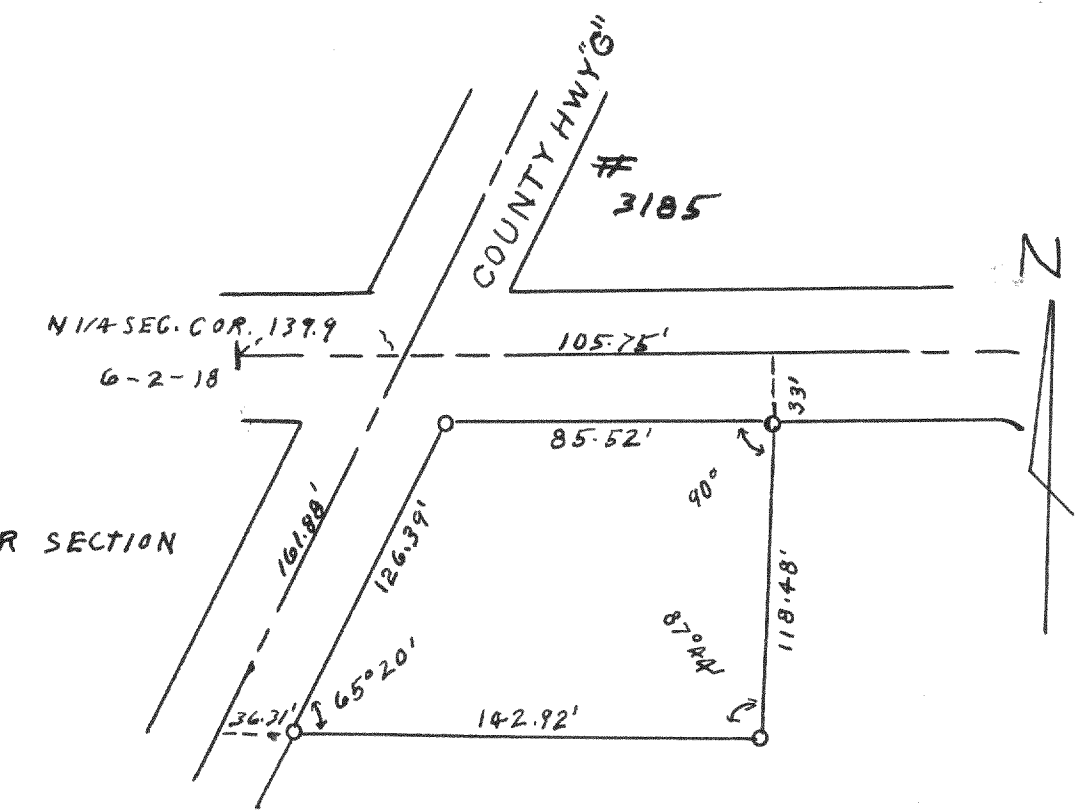

PLAT OF SURVEY OF LAND IN
NE 1/4 SECTION 6 T2N R16E
WALWORTH COUNTY WISCONSIN
SEPT 1953 LLOYD L. JENSEN
SURVEYOR

#3186

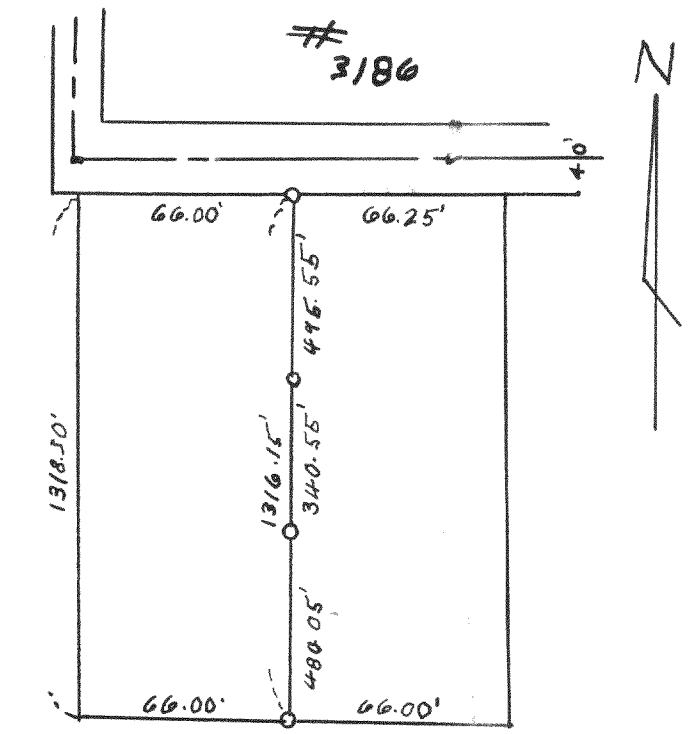

PLAT OF SURVEY OF W 1/2 NE 1/4 SE 1/4
SECTION 28 T2N R16E
WALWORTH COUNTY WISCONSIN
NOV. 1956 LLOYD L. JENSEN
SURVEYOR