




3204

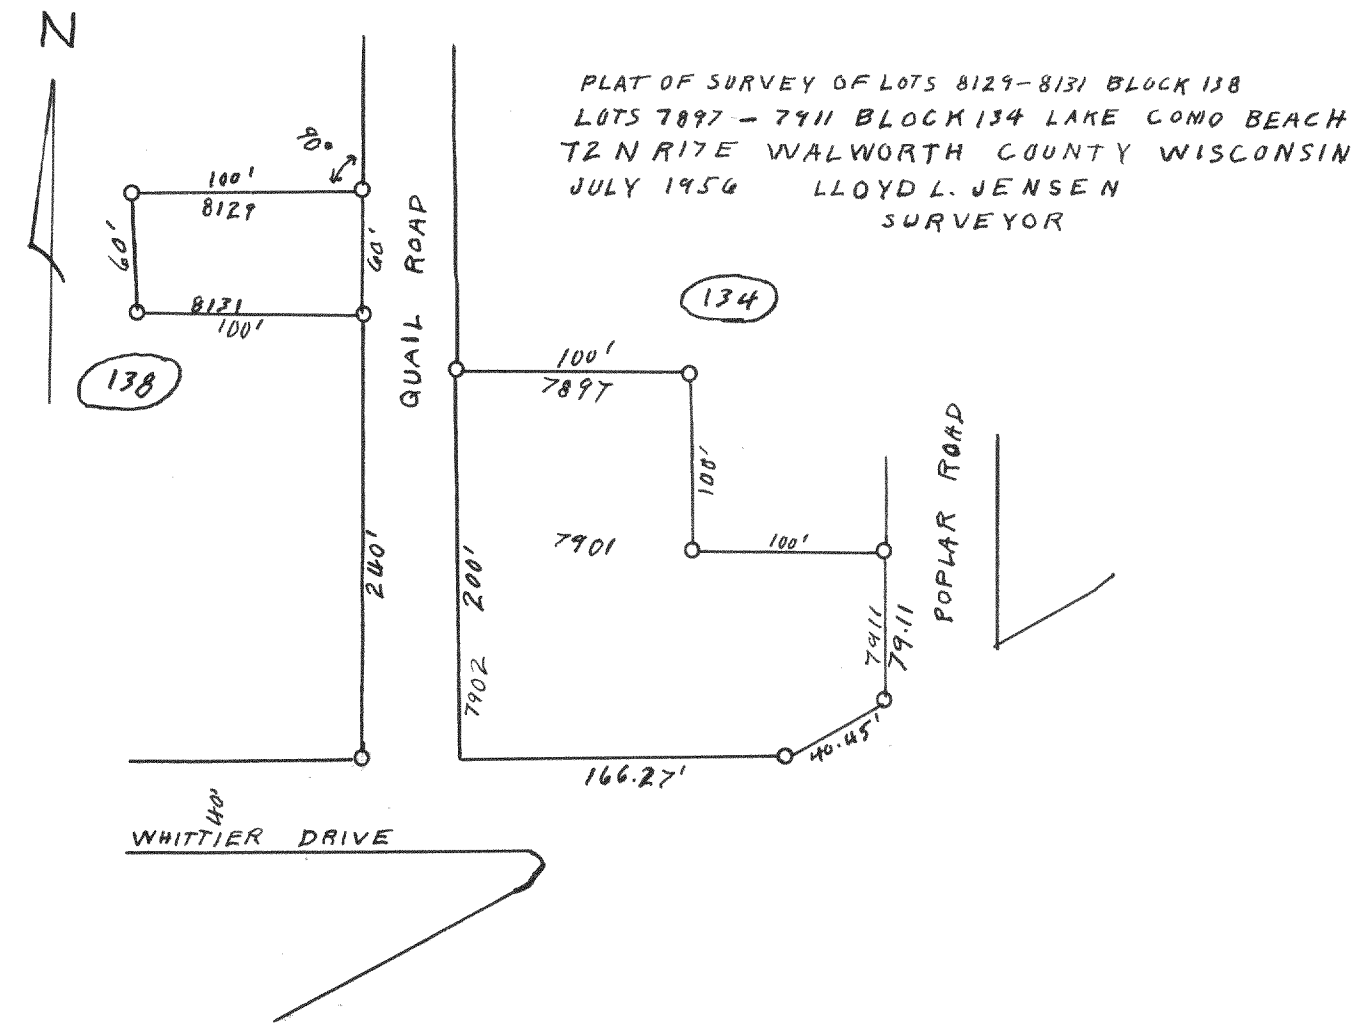


3205

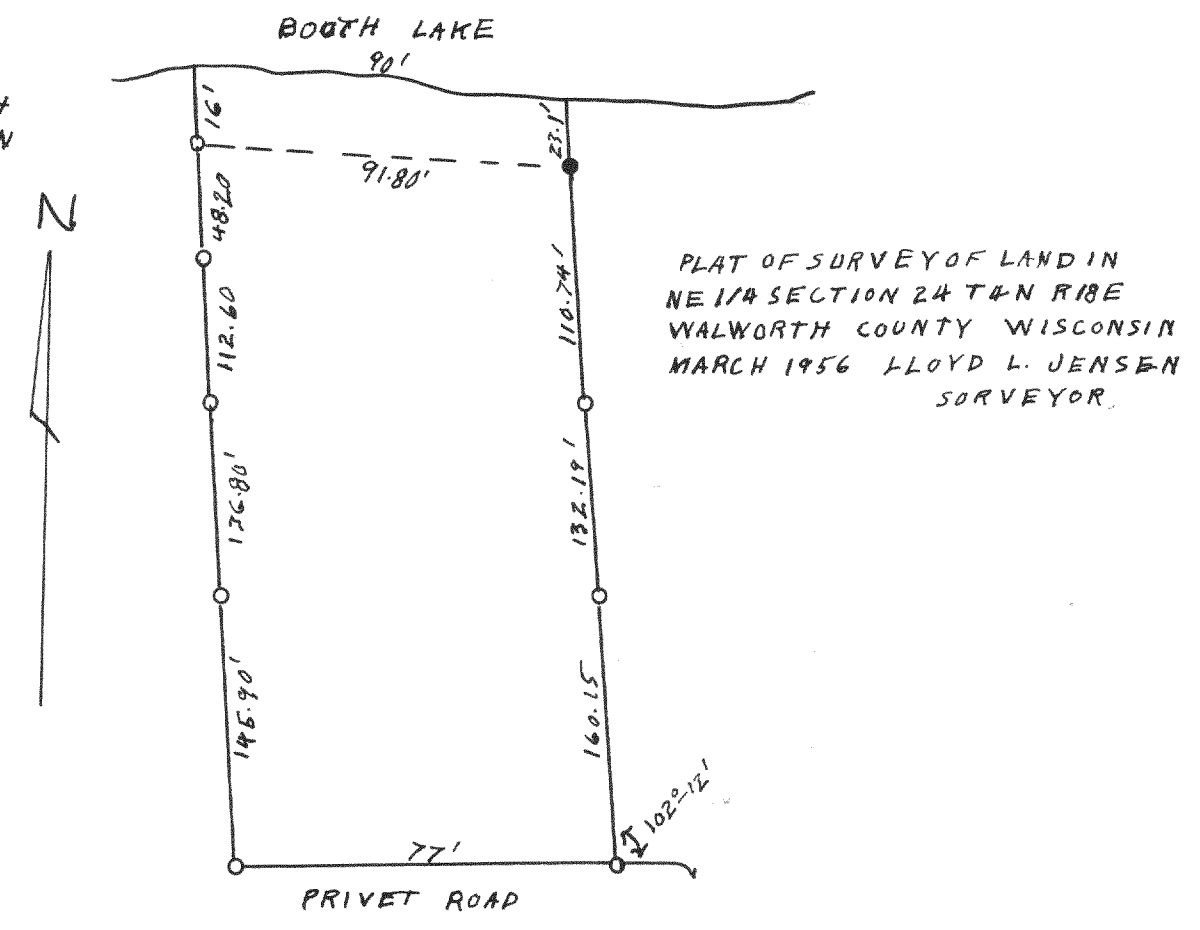


3206

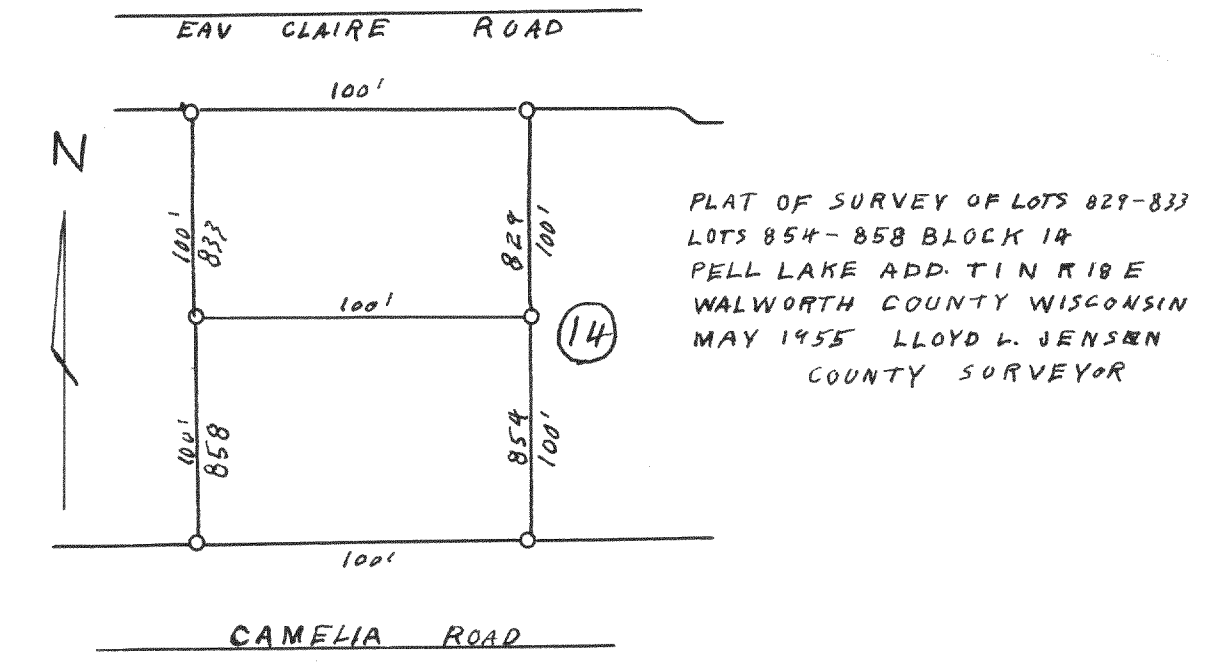


3207

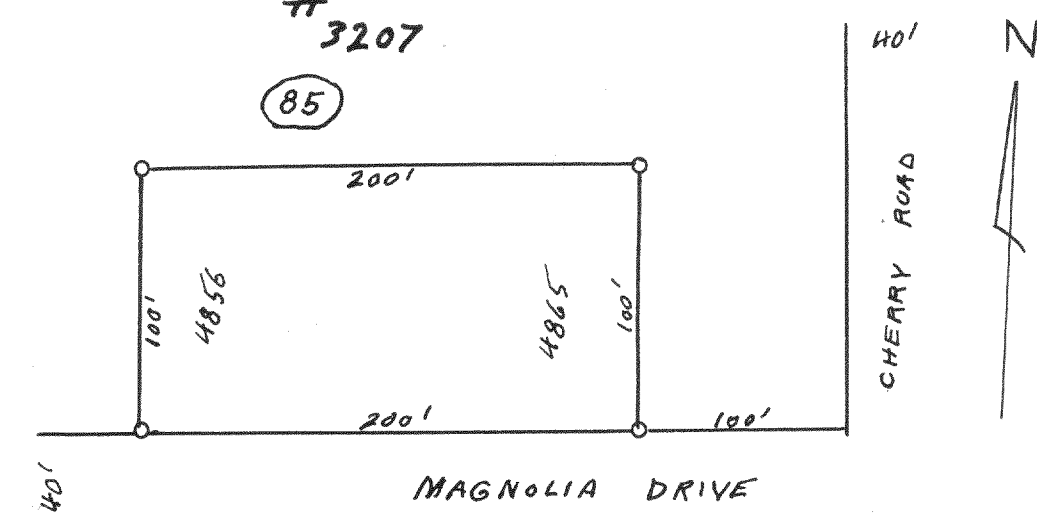

3208

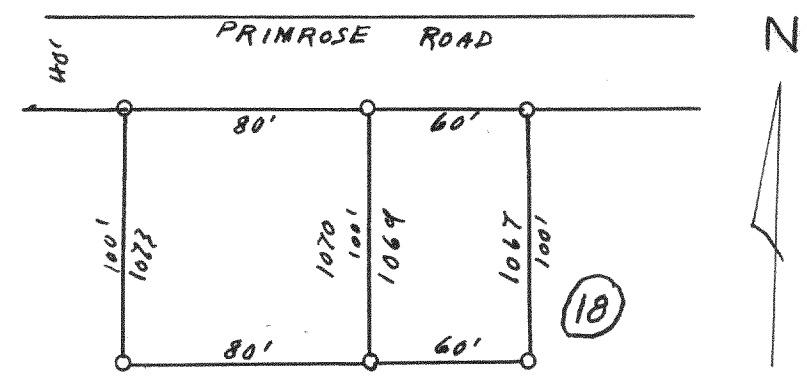

3209

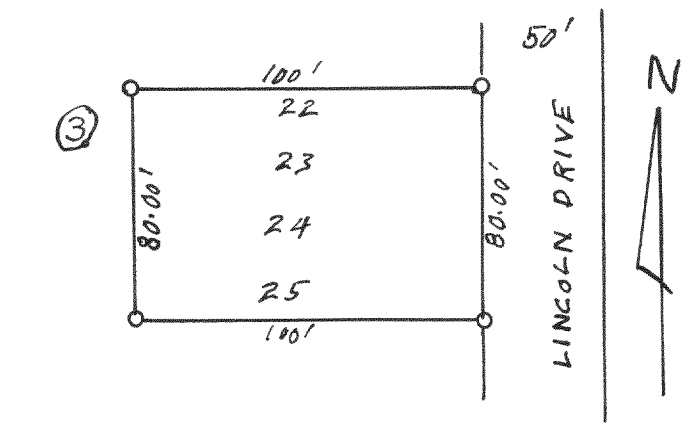

3210

