



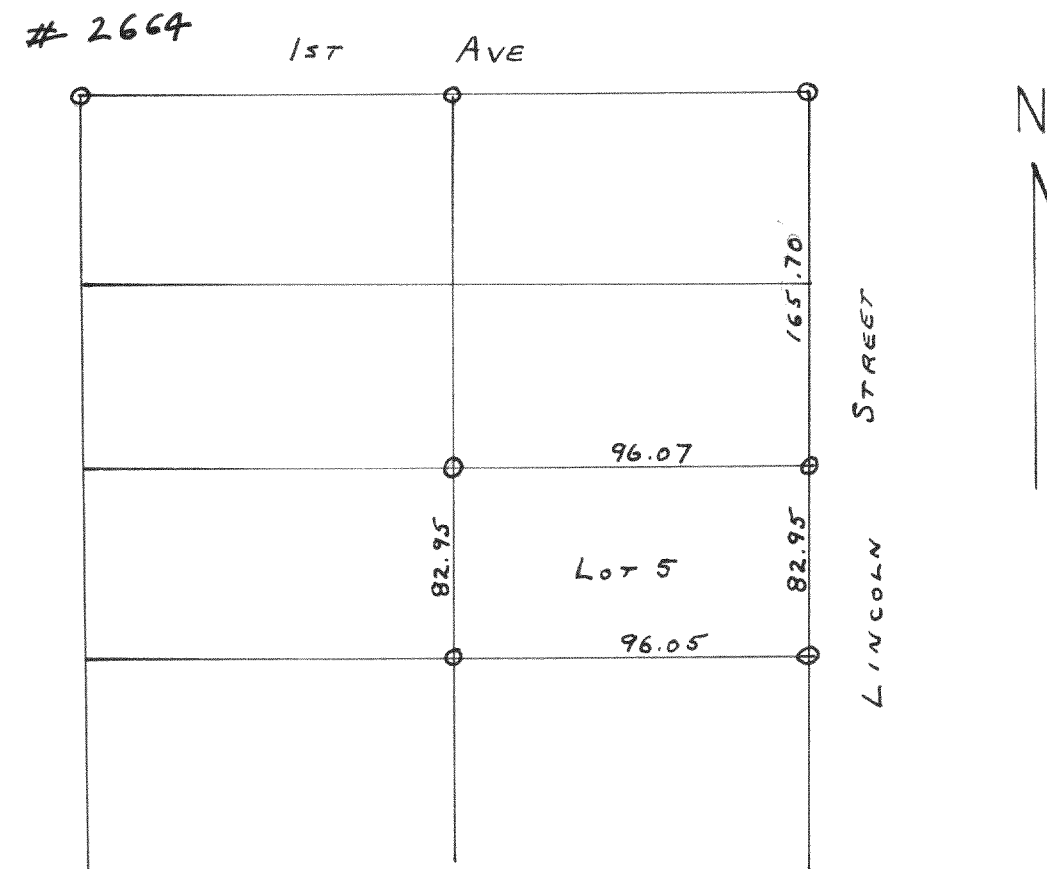


PLAT OF SURVEY OF LOT 5 OF BLOCK 35 OF
DAVIS' ADDITION TO THE CITY OF ELKHORN
AUGUST 25, 1952
Lloyd L Jensen
COUNTY SURVEYOR

2666

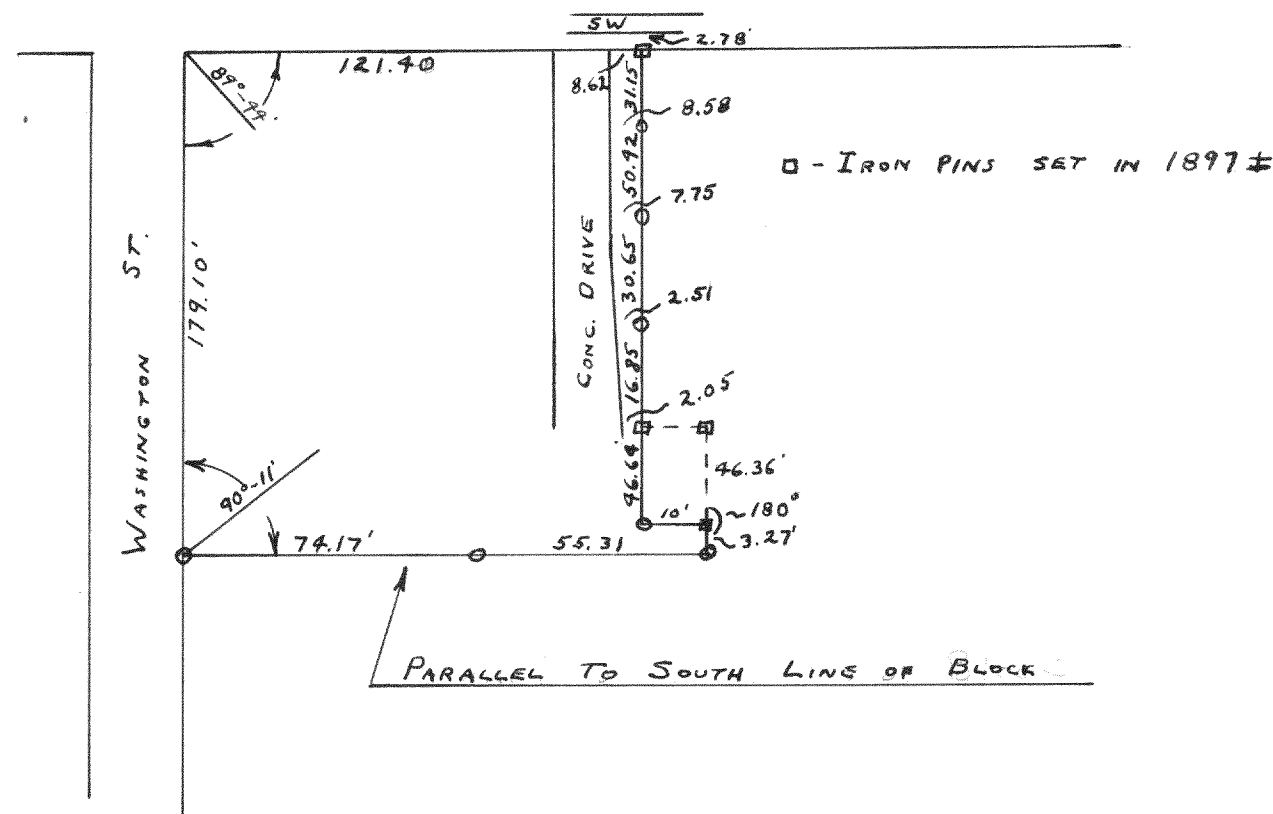

PLAT OF SURVEY OF THE NW PART OF
BLOCK 47 OF ROCKWELL'S 2ND. ADD. TO
THE CITY OF ELKHORN
AUGUST 1952
Lloyd L Jensen
COUNTY SURVEYOR

2665

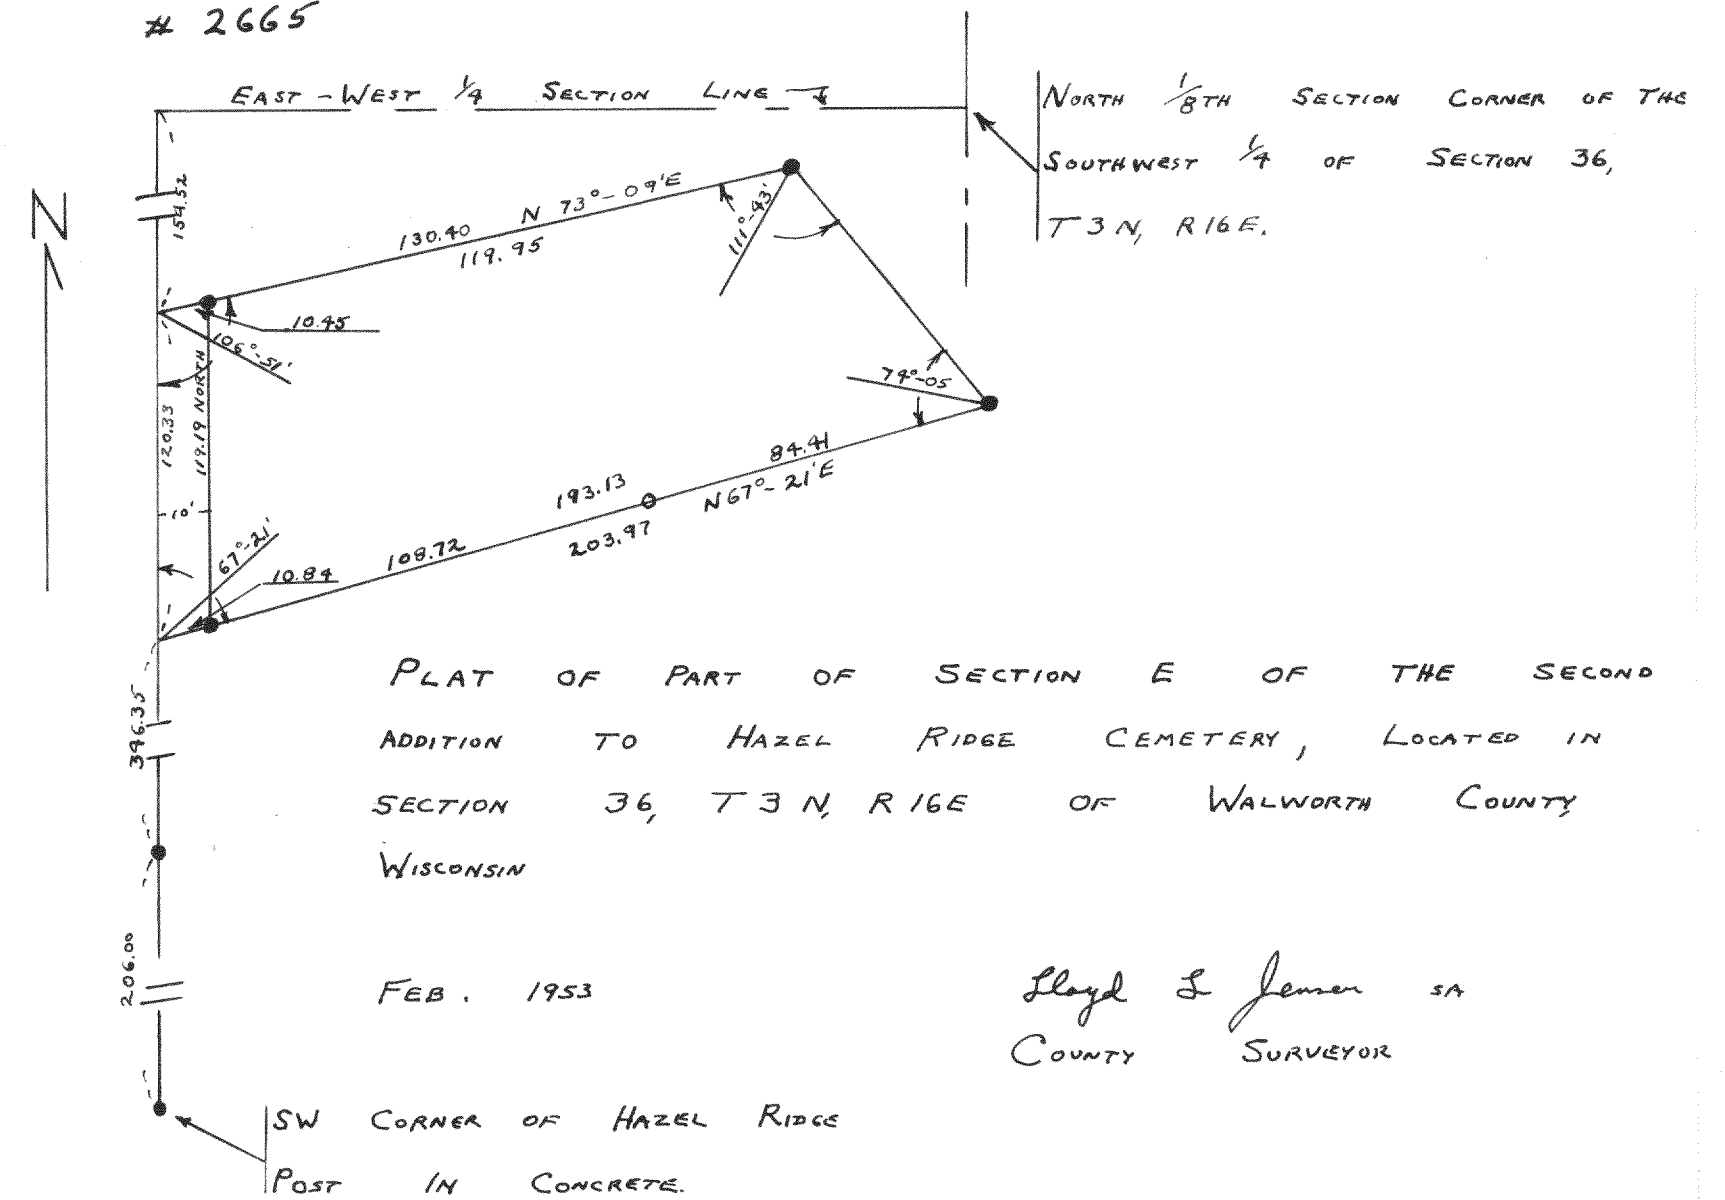


PLAT OF PART OF SECTION E OF THE SECOND
ADDITION TO HAZEL RIDGE CEMETERY, LOCATED IN
SECTION 36, T3N, R16E OF WALWORTH COUNTY
WISCONSIN

FEB. 1953

Lloyd L Jensen SA
COUNTY SURVEYOR

2667

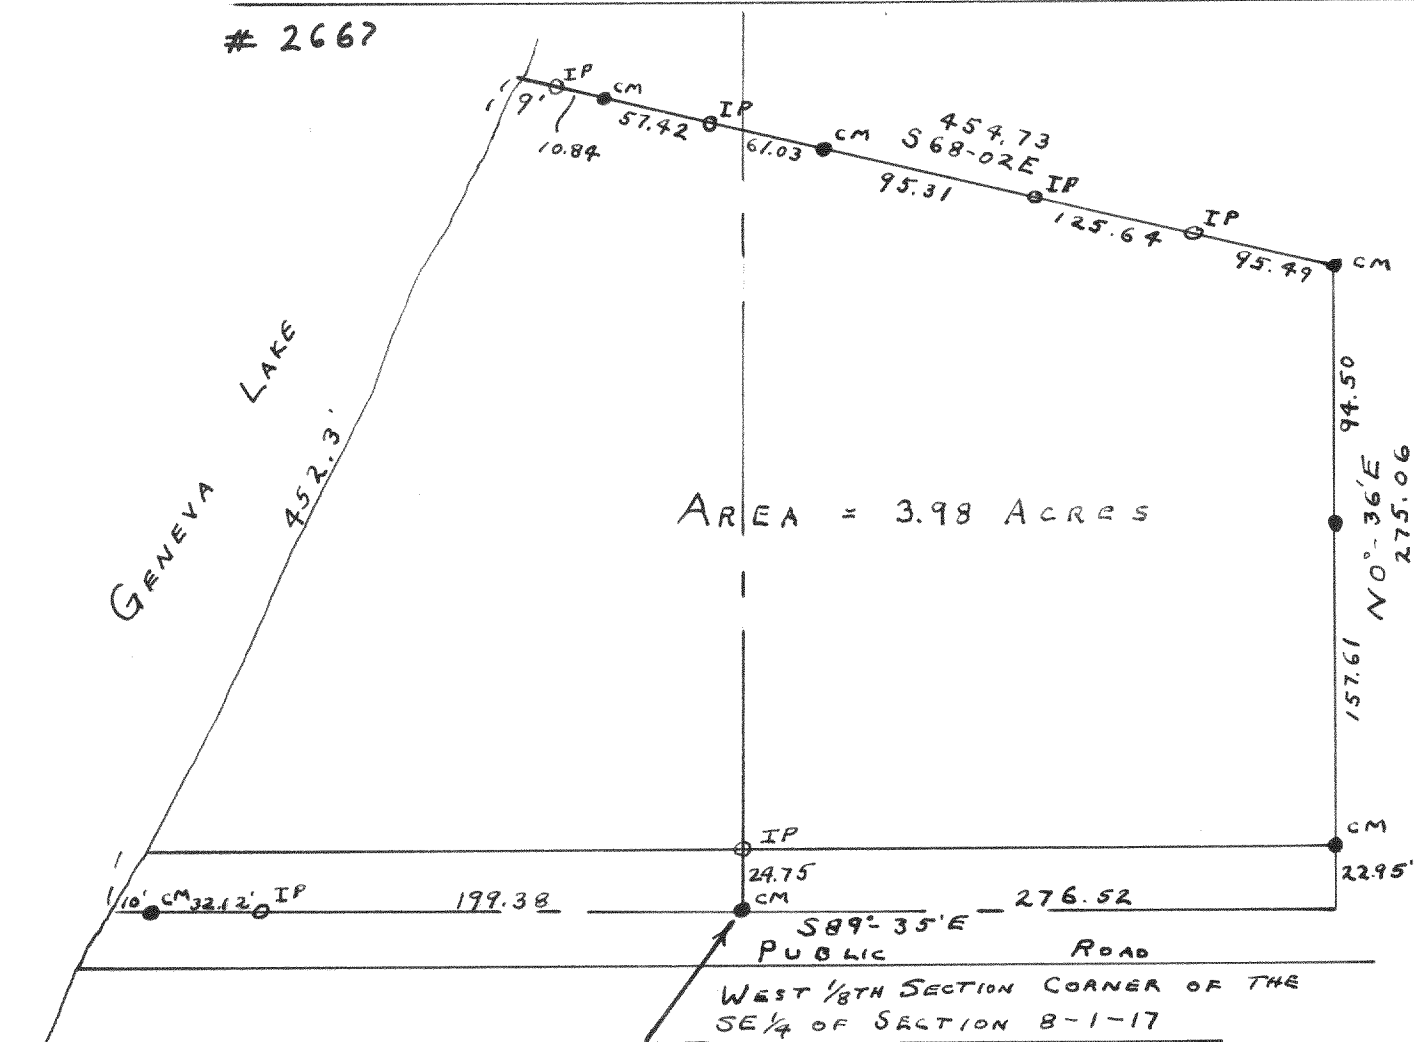

PLAT OF SURVEY OF LAND LOCATED IN THE
FRACTIONAL SECTION 8, T1N, R17E

JAN. 1953

Lloyd L Jensen SA
COUNTY SURVEYOR