

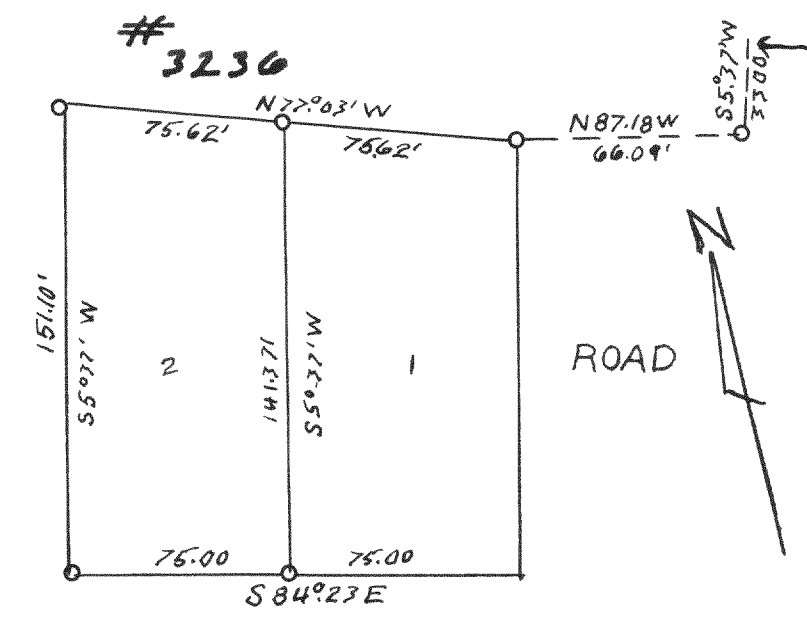
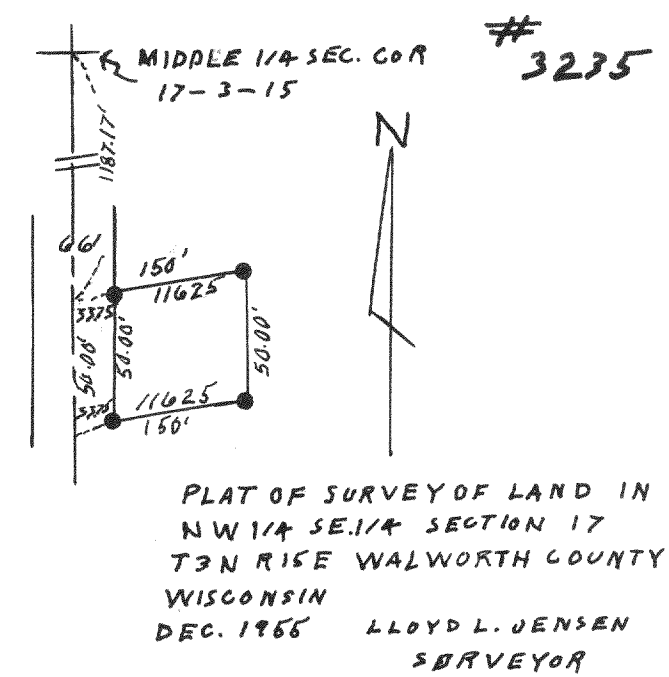
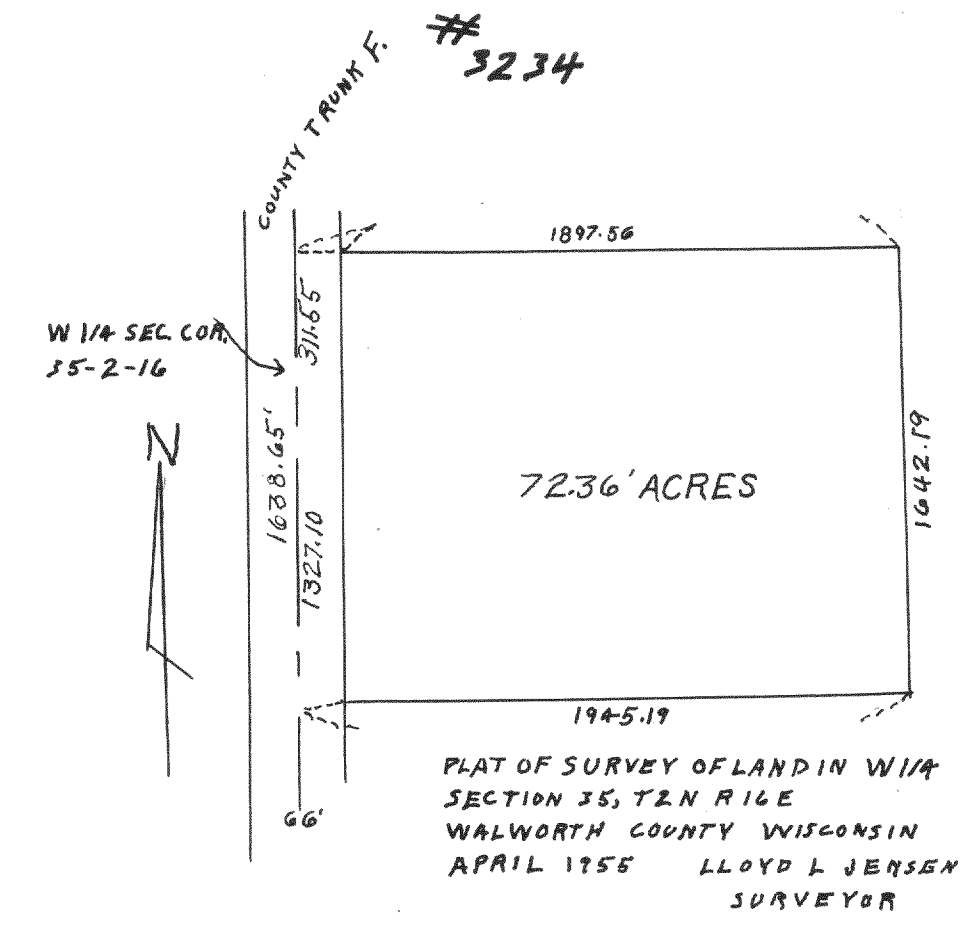


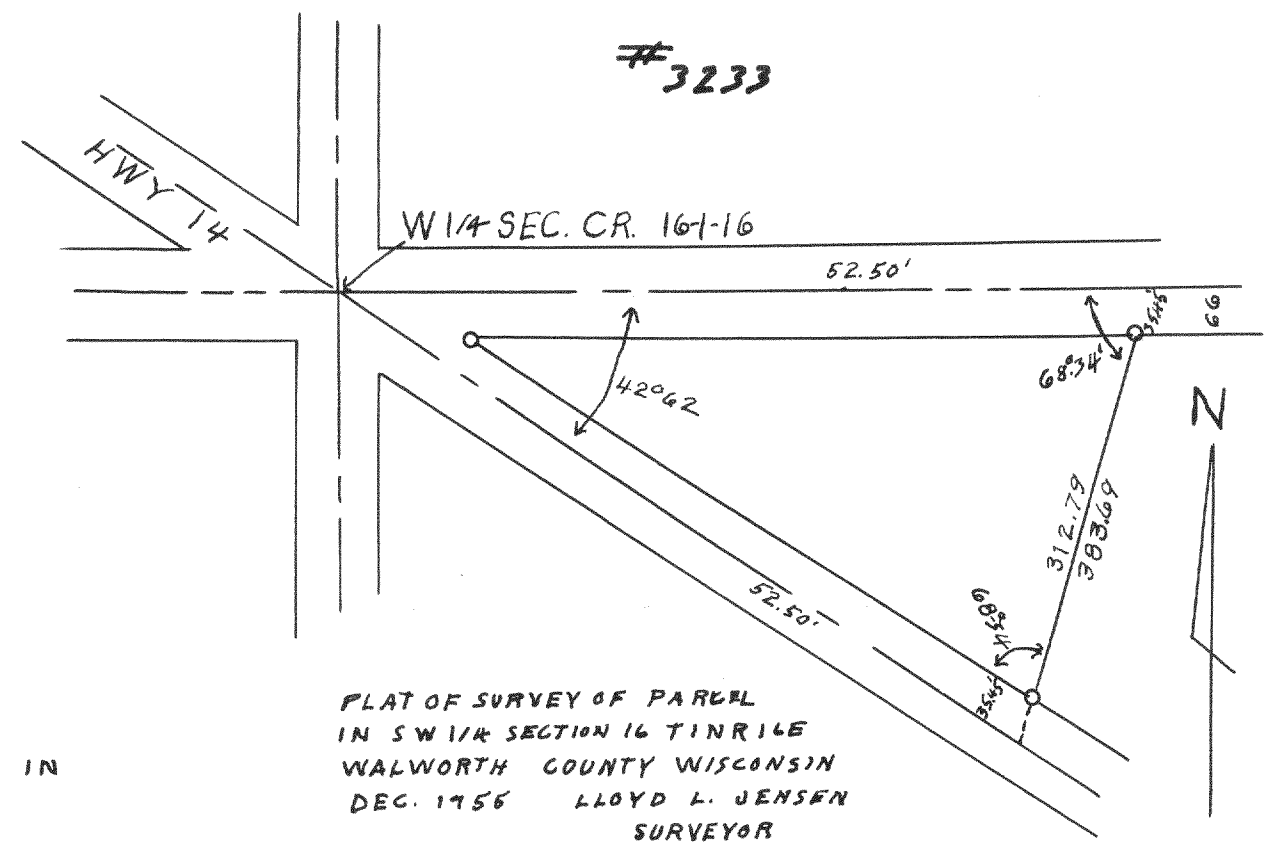

POINT IS EAST 161.90' S 60° 21' E 129.74 FEET
S 60° 22' E 147.71 FEET S 73° 07' E 75.40 FEET
S 79° 13' E 129.41 FEET S 84° 23' E 29.52 FEET OF
N NW CORNER SECTION 2 T3N R1E
WALWORTH COUNTY WISCONSIN
SEPT. 1956 LLOYD L. JENSEN SURVEYOR

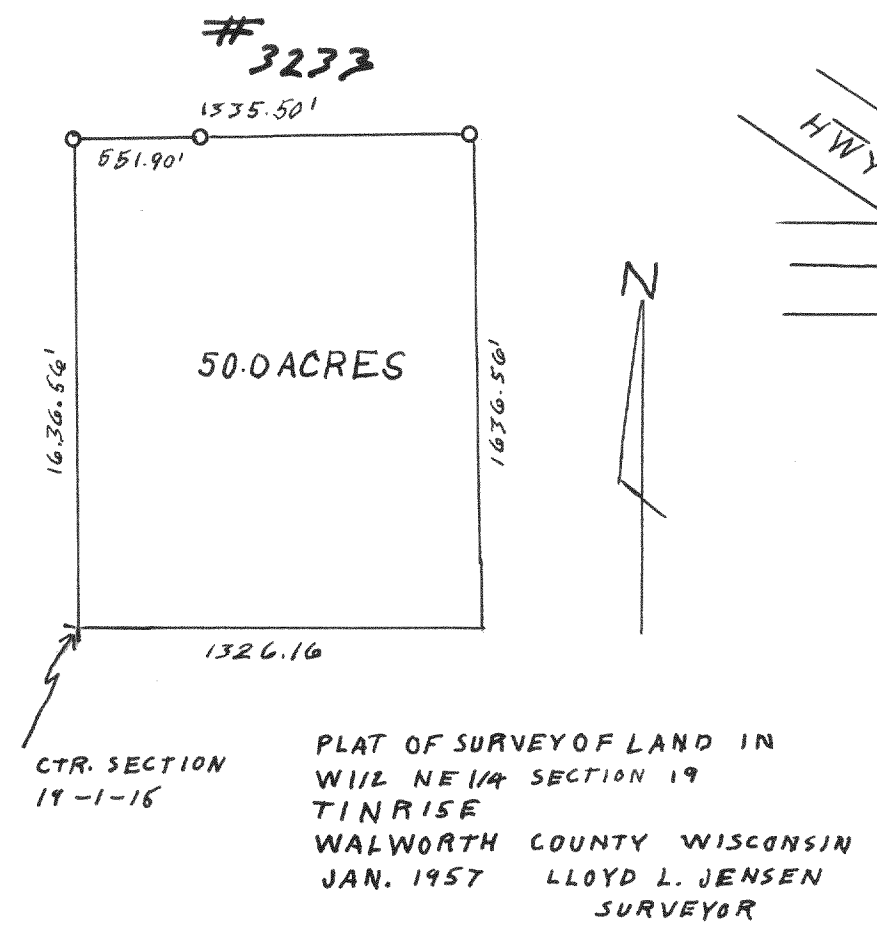