




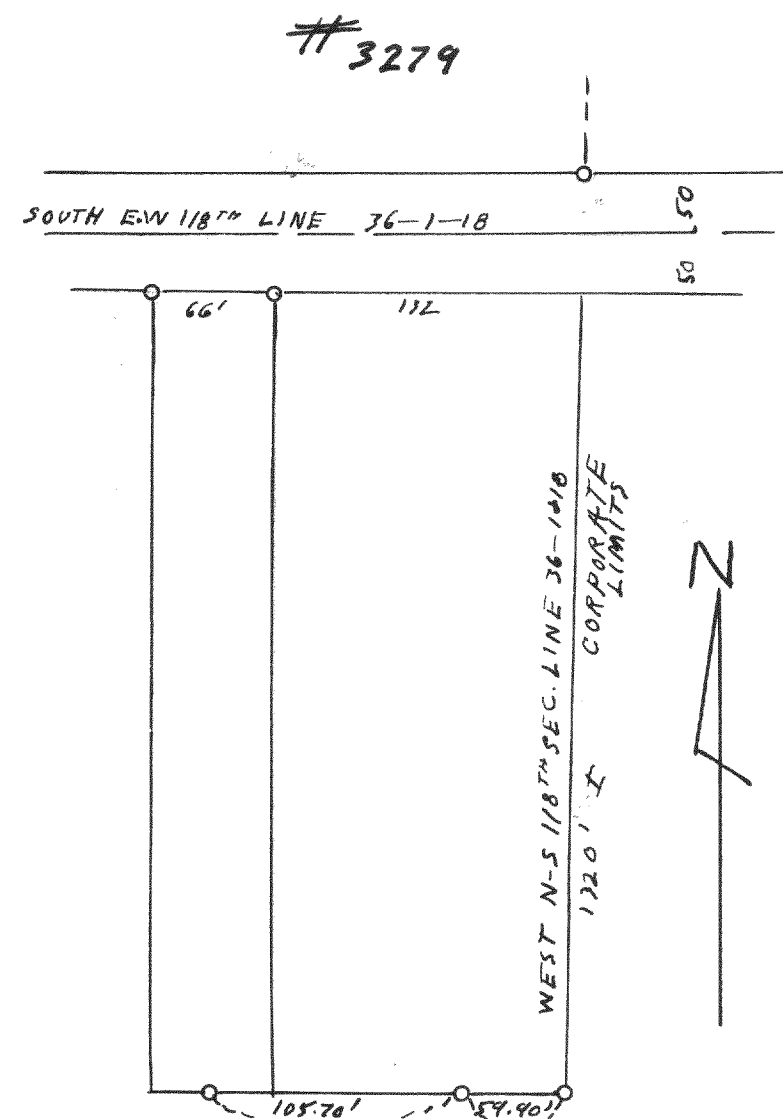

STATE OF ILLINOIS
PLAT OF SURVEY OF LAND IN SW 1/4
SECTION 36, T1N R18E VILLAGE OF
GENOA CITY IN WALWORTH COUNTY
WISCONSIN SEPT. 1954 LLOYD L. JENSEN
SURVEYOR

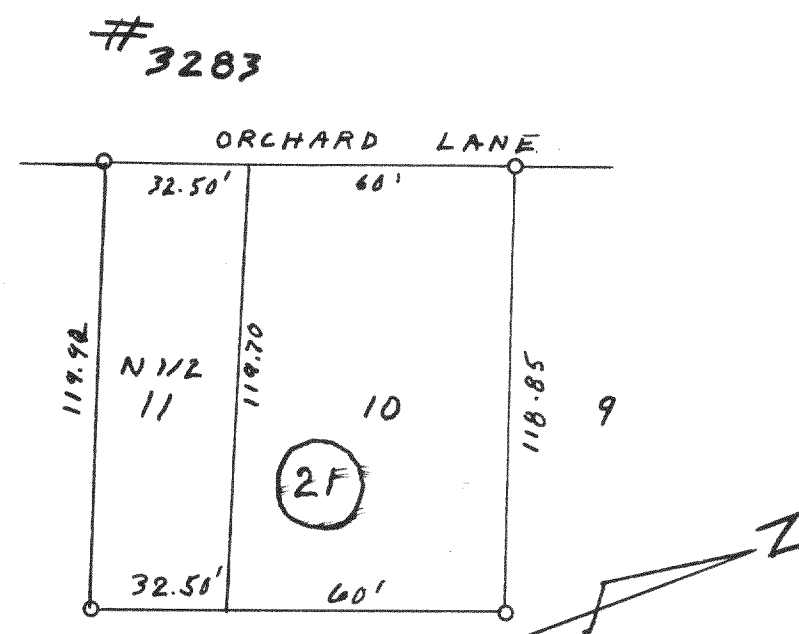


PLAT OF SURVEY OF LOT 10 AND N 1/2 OF LOT 11
BLOCK 21 LAKE GENEVA MANOR
CITY OF LAKE GENEVA
WALWORTH COUNTY WISCONSIN
SEPT. 1955 LLOYD L. JENSEN
SURVEYOR

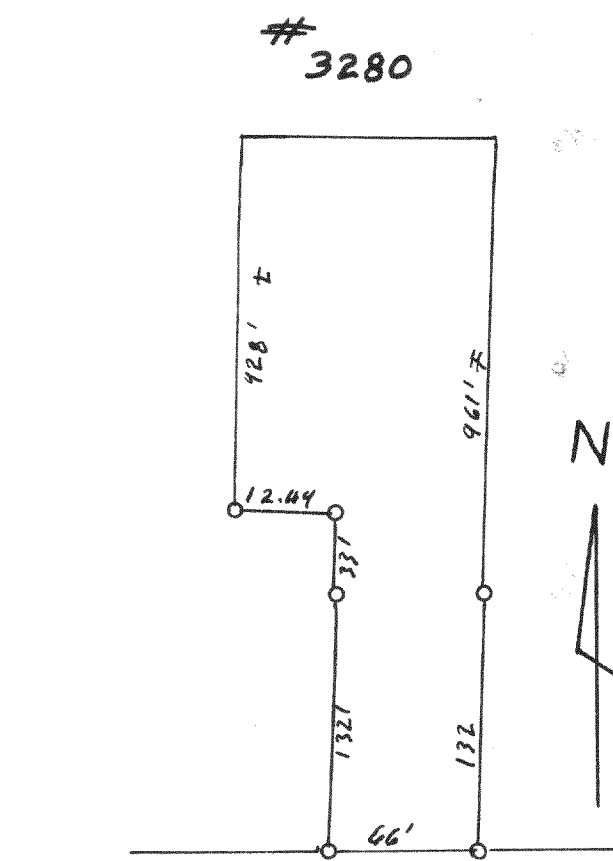


FRANKLIN STREET

PLAT OF SURVEY OF LAND IN NW 1/4
SECTION 35 T1N R18E VILLAGE
OF GENOA CITY
WALWORTH COUNTY WISCONSIN
JAN. 1957 LLOYD L. JENSEN
SURVEYOR


NE 1/4 SEC. COR.
35-1-18

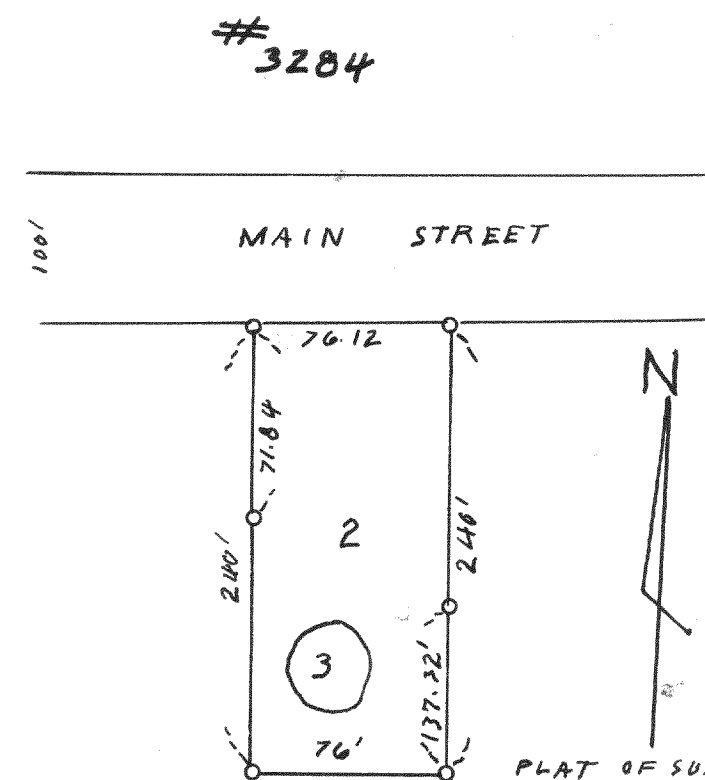


PLAT OF SURVEY OF LOT 2 BLOCK 3
E.D. PHILLIPS CITY OF LAKE GENEVA IN
WALWORTH COUNTY WISCONSIN
JUNE 1955 LLOYD L. JENSEN
SURVEYOR

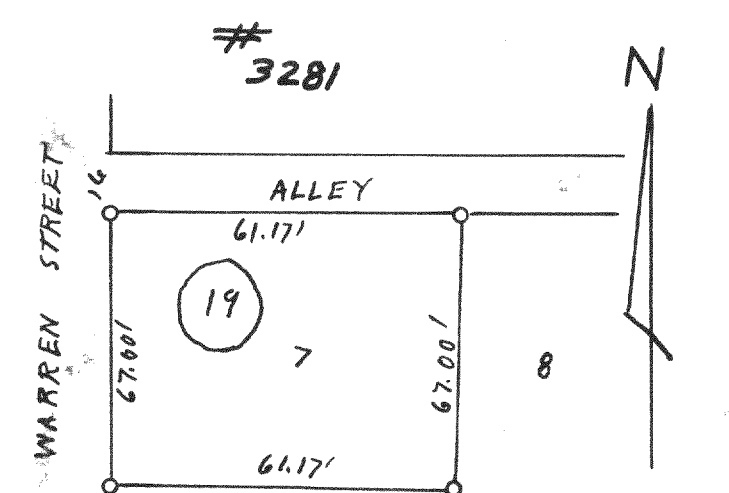


PLAT OF SURVEY OF THE N 1/2 FEET OF
LOT 7 BLOCK 19 ORIGINAL PLAT
CITY OF LAKE GENEVA
WALWORTH COUNTY WISCONSIN
MARCH 1957 LLOYD L. JENSEN
SURVEYOR

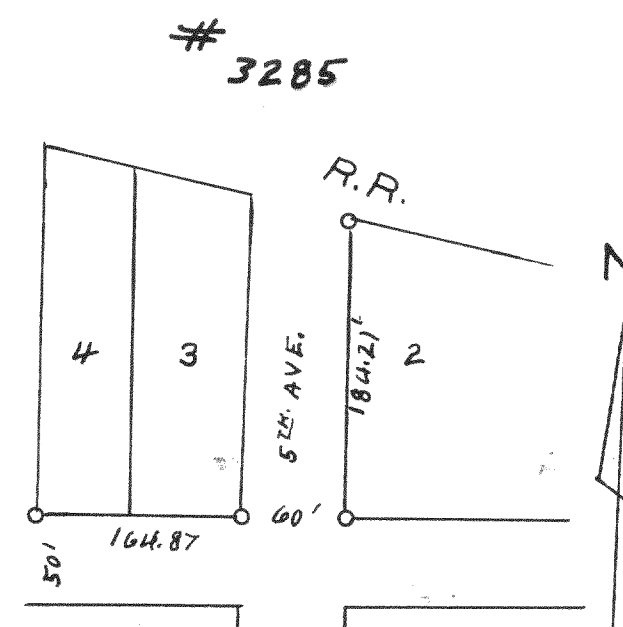

PLAT OF SURVEY OF LOT 3 BLOCK 2
E.W. CRUMBS ADD VILLAGE OF
WALWORTH, IN WALWORTH COUNTY
WISCONSIN JULY 1956
LLOYD L. JENSEN
SURVEYOR

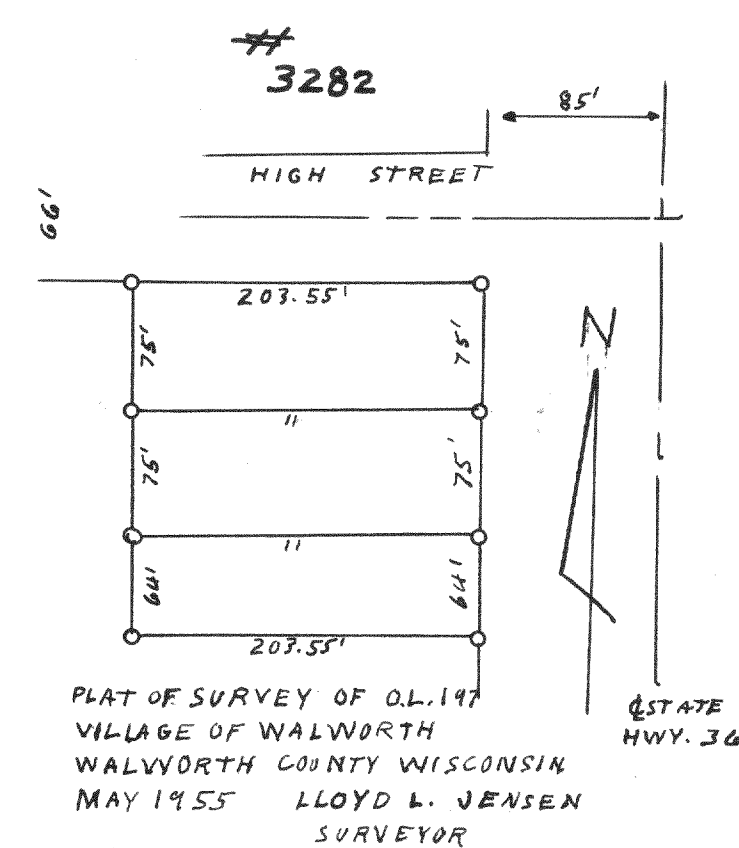

PLAT OF SURVEY OF Q.L. 197
VILLAGE OF WALWORTH
WALWORTH COUNTY WISCONSIN
MAY 1955 LLOYD L. JENSEN
SURVEYOR

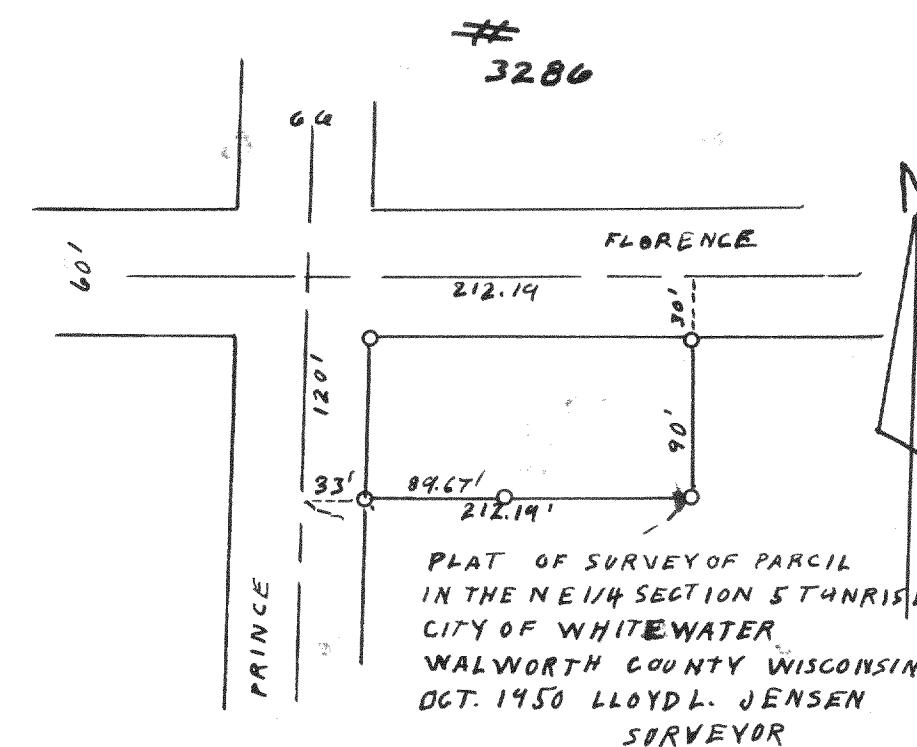

PLAT OF SURVEY OF PARCEL
IN THE NE 1/4 SECTION 5 T4N R18E
CITY OF WHITEWATER
WALWORTH COUNTY WISCONSIN
OCT. 1950 LLOYD L. JENSEN
SURVEYOR