


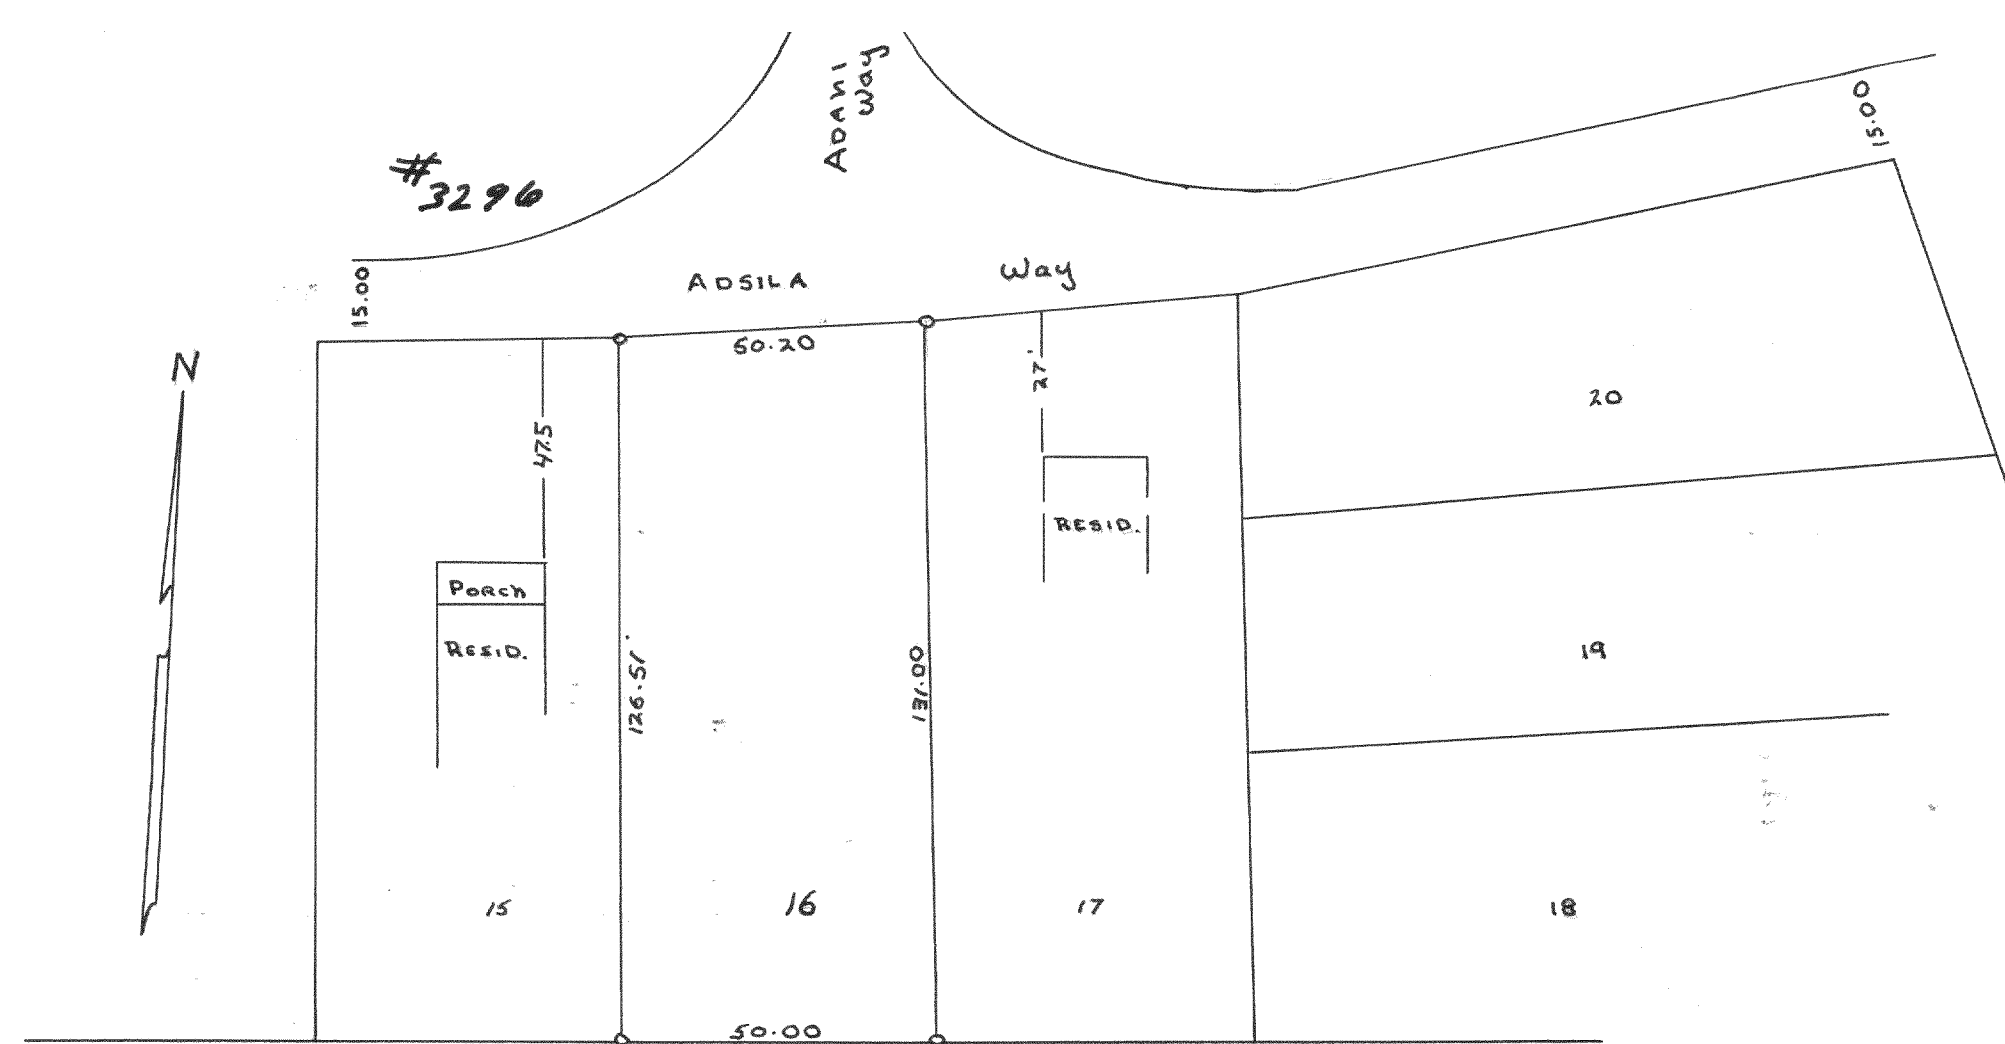

PLAT OF SURVEY OF LOT 16, OF BLOCK 5
INDIAN HILLS SUBDIVISION IN THE VILLAGE OF
FONTANA ON GENEVA LAKE" WALWORTH
COUNTY, WISCONSIN
AUGUST 56 LLOYD L. JENSEN
SURVEYOR

