




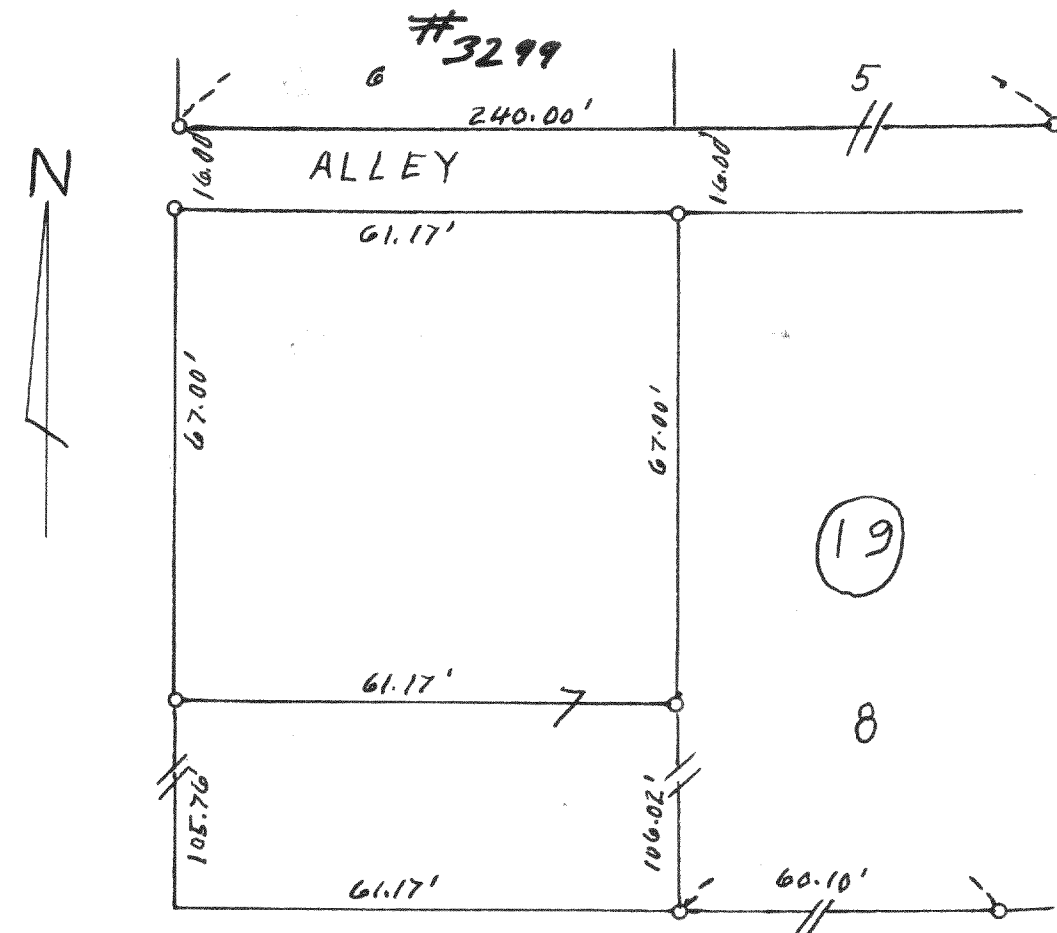


PLAT OF SURVEY OF LOT 7 BLOCK 19
ORIGINAL PLAT CITY OF LAKE GENEVA
WALWORTH COUNTY WISCONSIN
MARCH 1957 LLOYD L. JENSEN
SURVEYOR

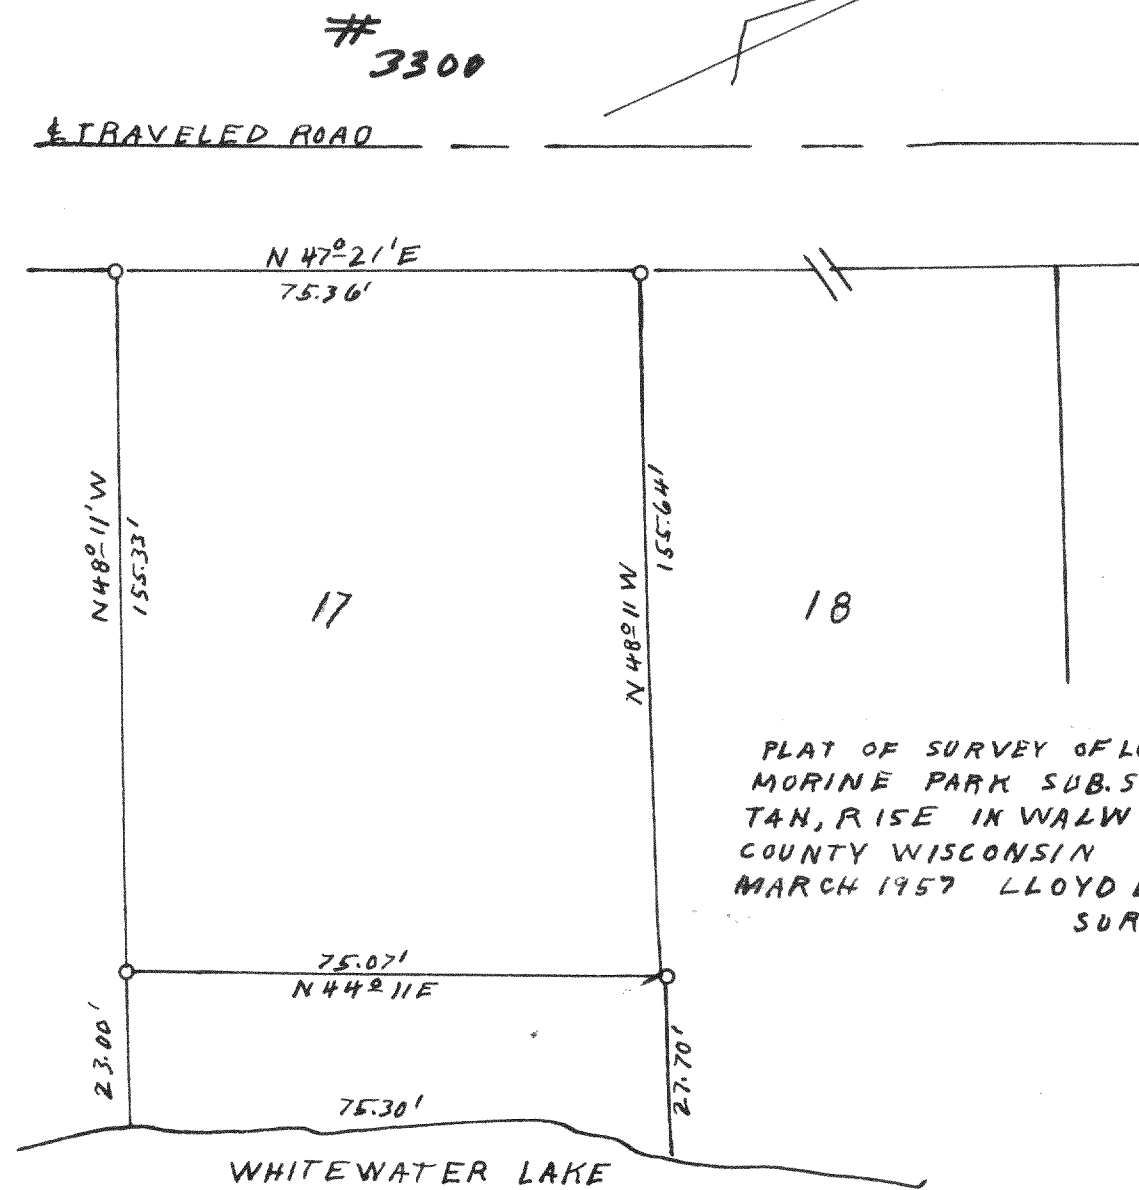


PLAT OF SURVEY OF LOT 17 IN
MORINE PARK SUBSECTION 34
T4N, R1E IN WALWORTH
COUNTY WISCONSIN
MARCH 1957 LLOYD L. JENSEN
SURVEYOR

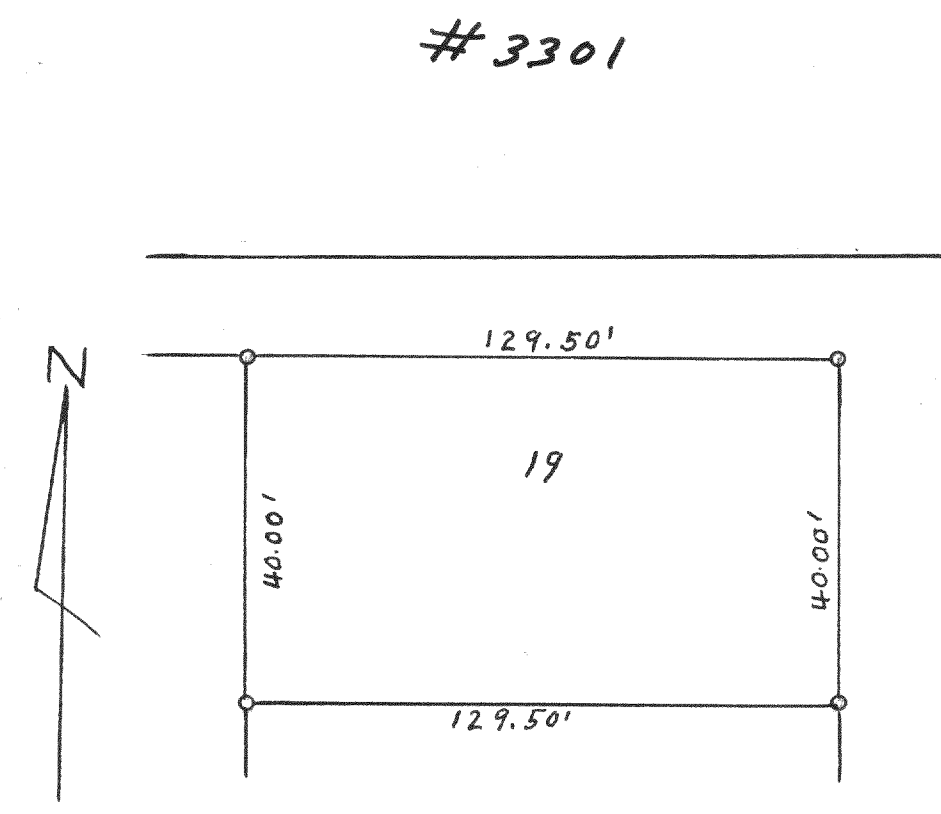


PLAT OF SURVEY OF LOT 19 CARLSONS ADD.
VILLAGE OF WILLIAMS BAY
WALWORTH COUNTY WISCONSIN
JULY 1955 LLOYD L. JENSEN
SURVEYOR

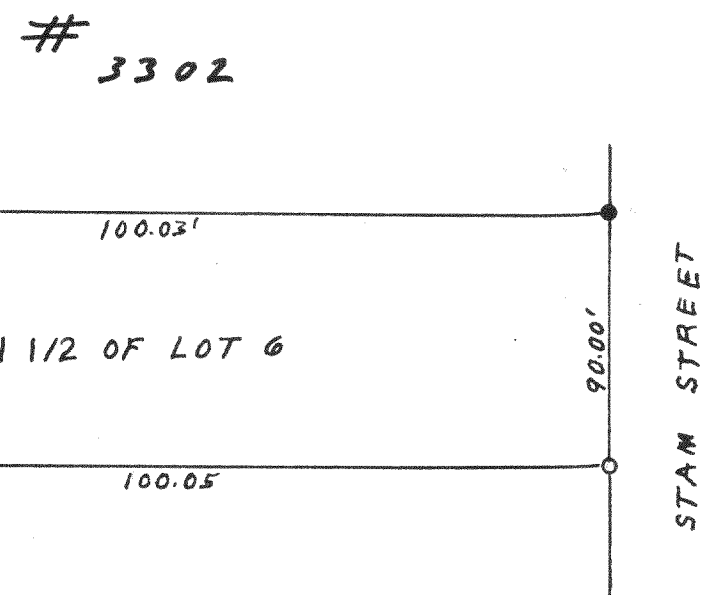

PLAT OF SURVEY OF PART OF LOT 6
OF BLOCK 1 OF UNIVERSITY HEIGHT
VILLAGE OF WILLIAMS BAY
WALWORTH COUNTY WISCONSIN
MARCH 1955 LLOYD L. JENSEN
SURVEYOR

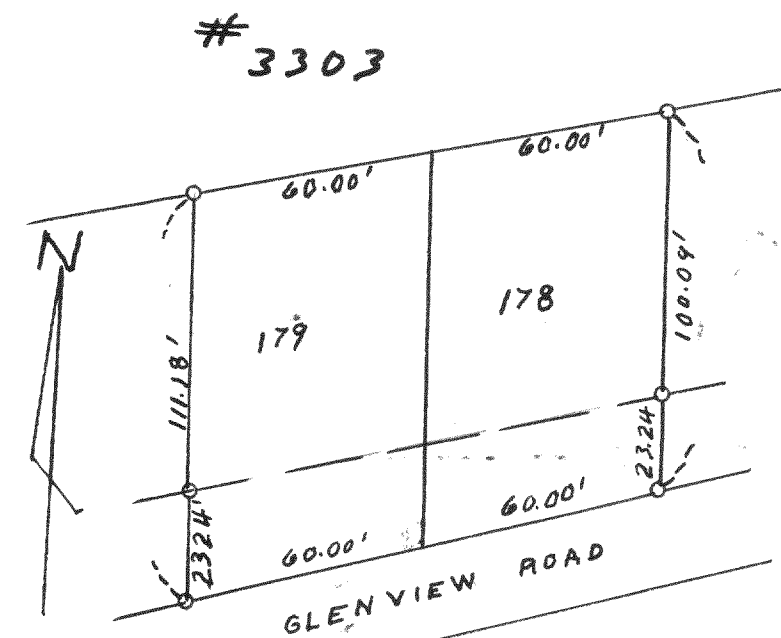

PLAT OF SURVEY OF LOT 178-179 OF
CEDAR POINT PARK 2ND ADDITION
VILLAGE OF WILLIAMS BAY
WALWORTH COUNTY WISCONSIN
AUG 1955 LLOYD L. JENSEN
SURVEYOR

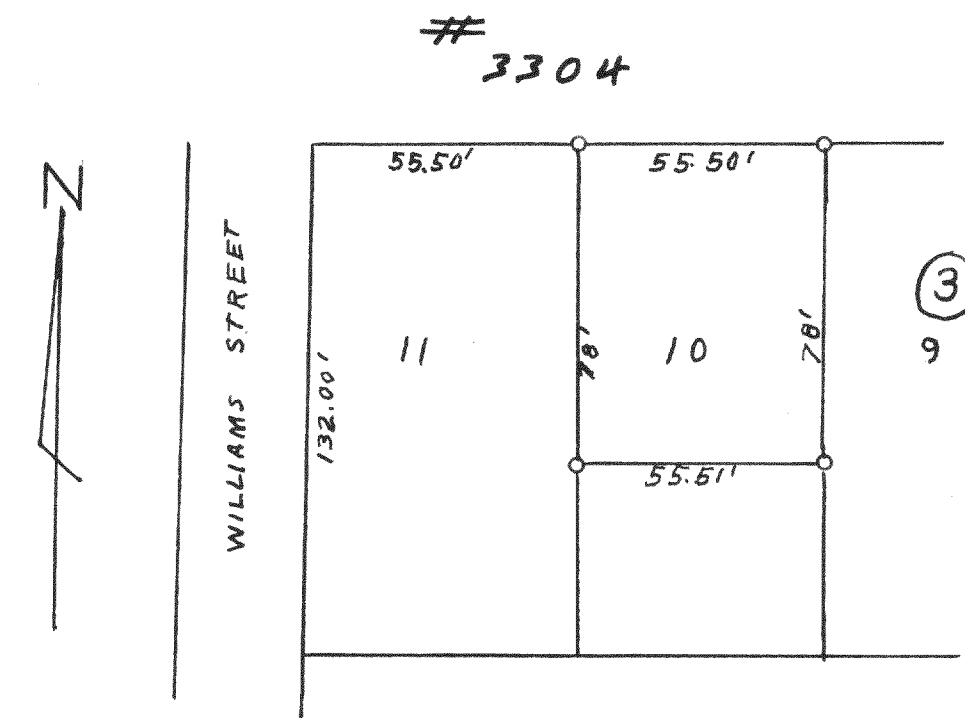

PLAT OF SURVEY OF PART OF LOT 10
BLOCK 3 OF ORIGINAL PLAT VILLAGE OF
WILLIAMS BAY WALWORTH COUNTY WISCONSIN
SEPT. 1955 LLOYD L. JENSEN
SURVEYOR

Paul To Love
Dec 1957