

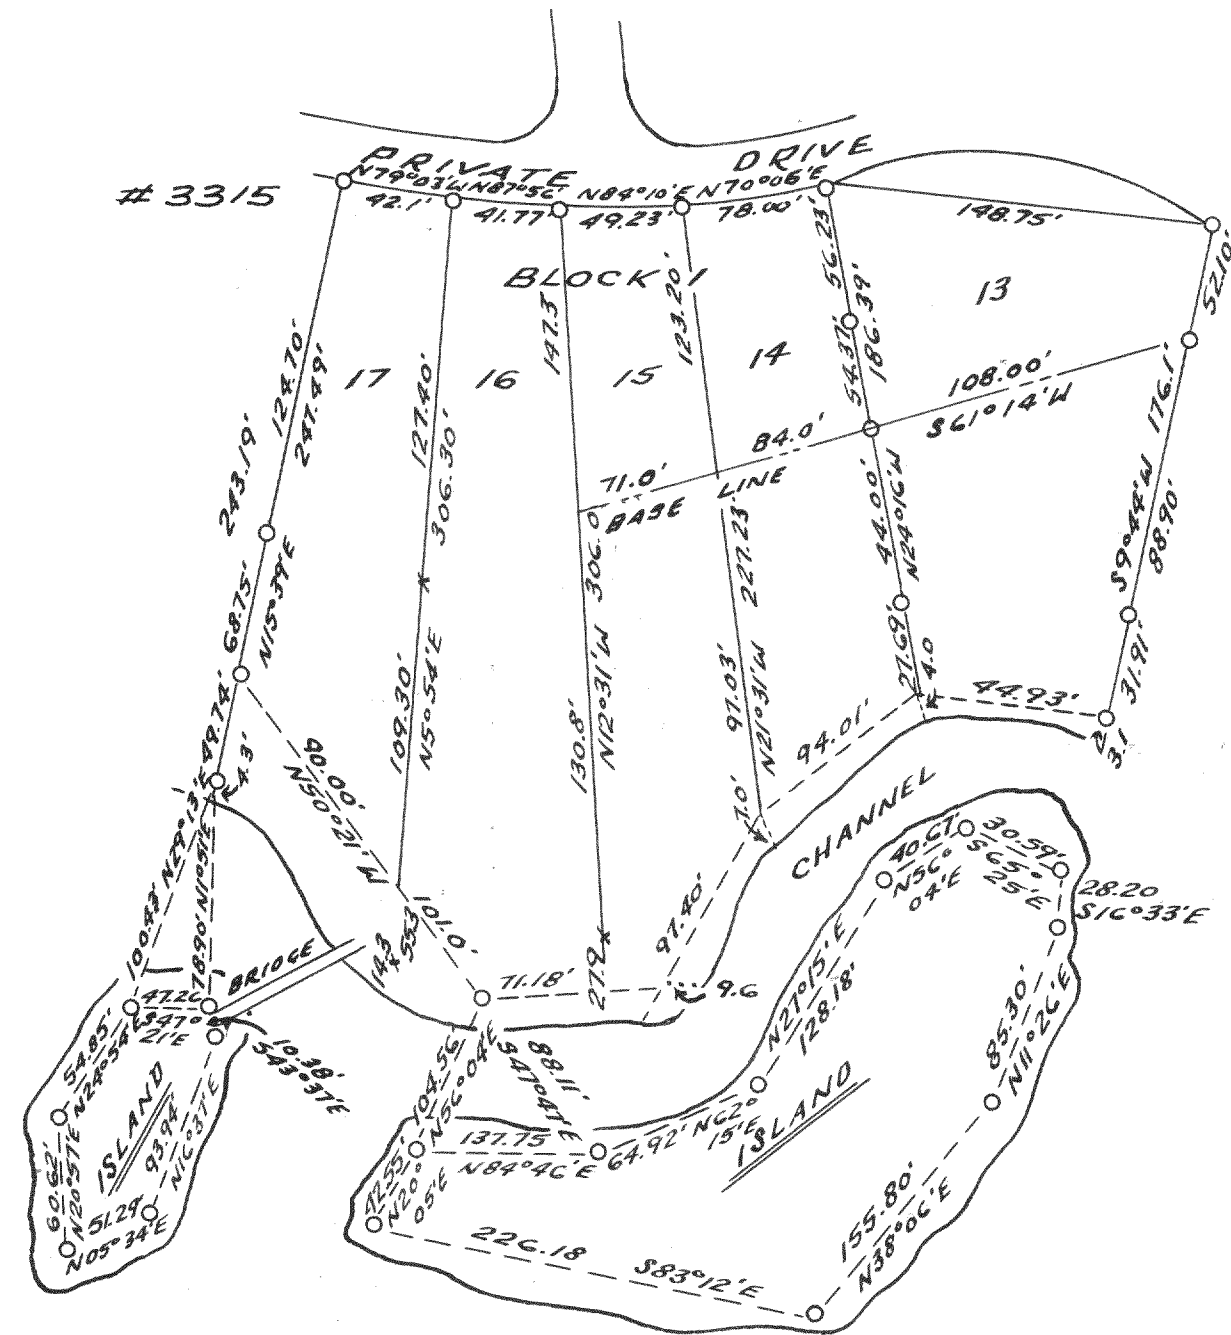


○ Iron pipe
Plat of Survey of
Lots 13, 14, 15, 16, and 17 in
Block 1 Nippersink
Park in the SE 1/4
of the NE 1/4 of
Section 28, T4N, R18E
Walworth County,
Wisconsin.
Lloyd L. Jensen
Surveyor
May 1957

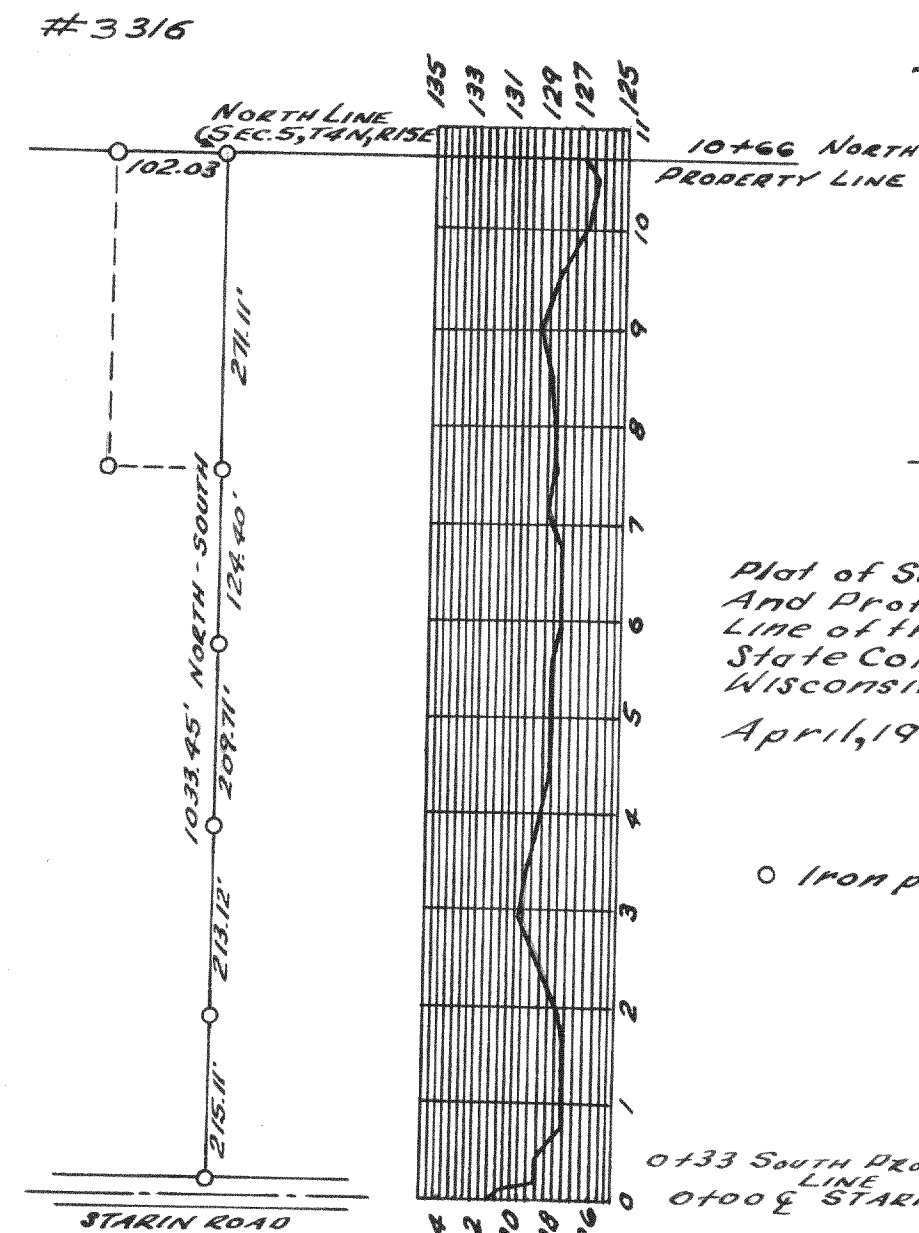

○ Iron pipe
Plat of Survey of Plan
And Profile of the West
Line of the Wisconsin
State College, Whitewater
Wisconsin.
April, 1958 Lloyd L. Jensen
Surveyor

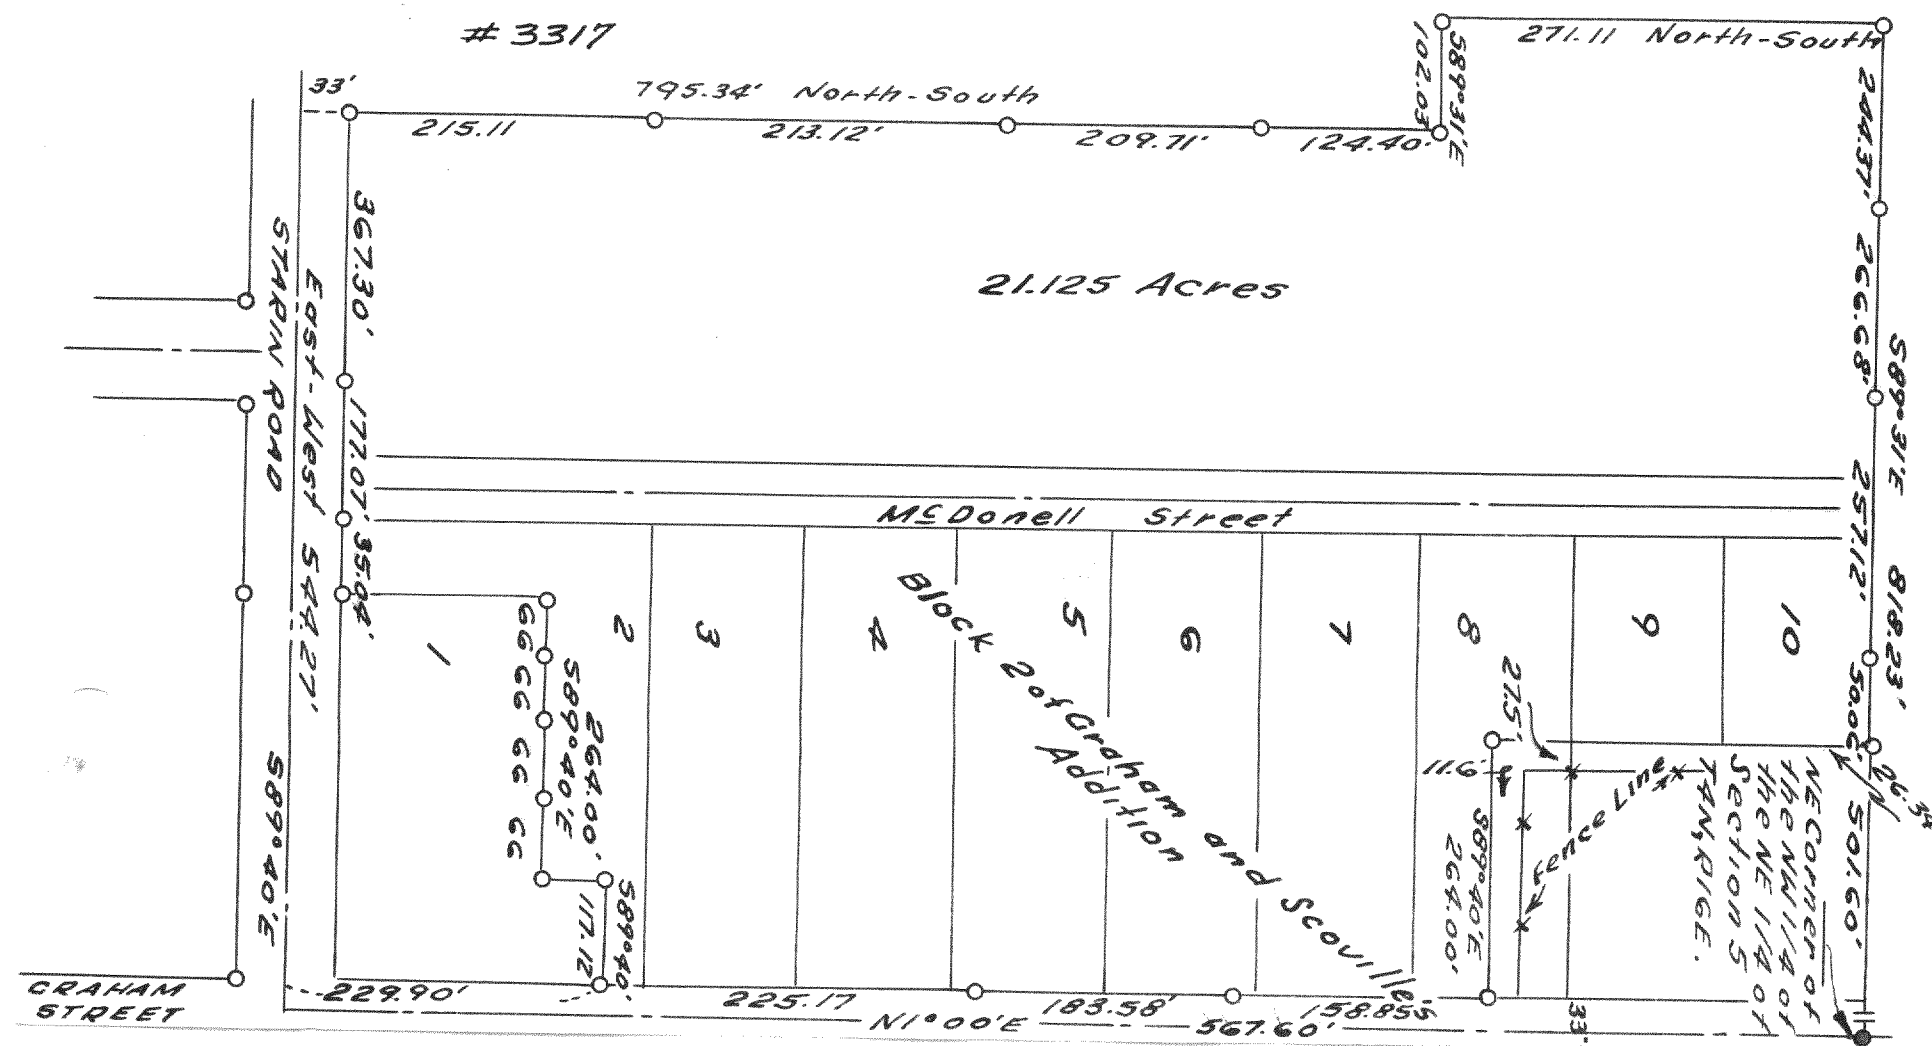

○ Iron Pipe
● Concrete monument