




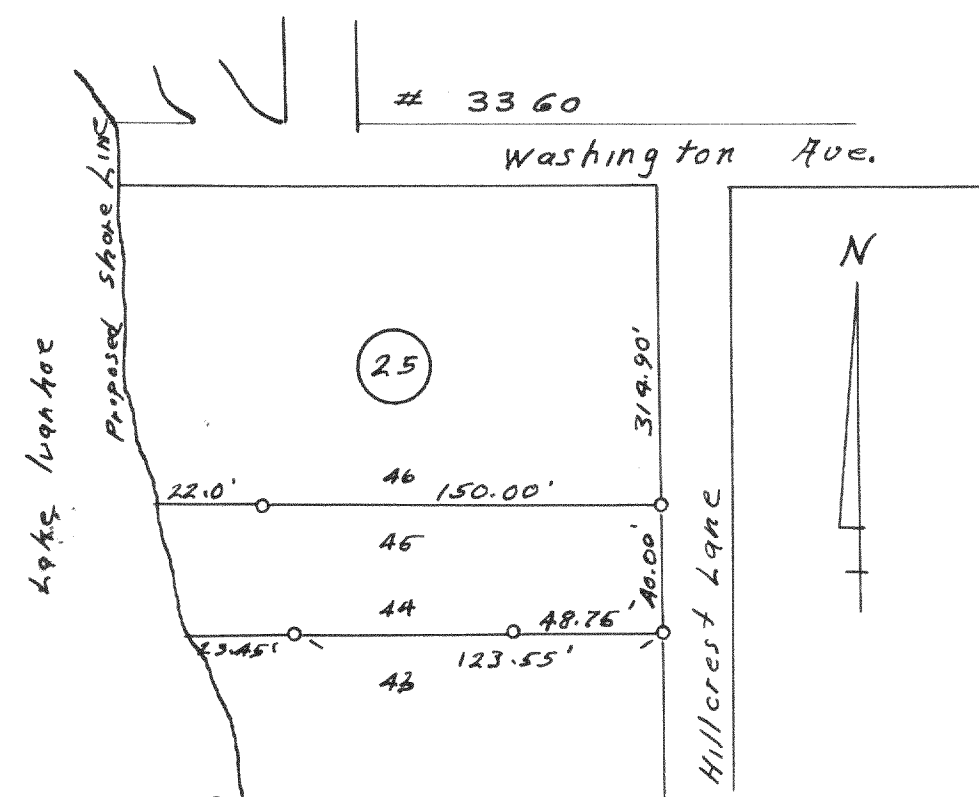


Survey of Lots 44 & 45 Blk 25 Lake Ivanhoe Resort

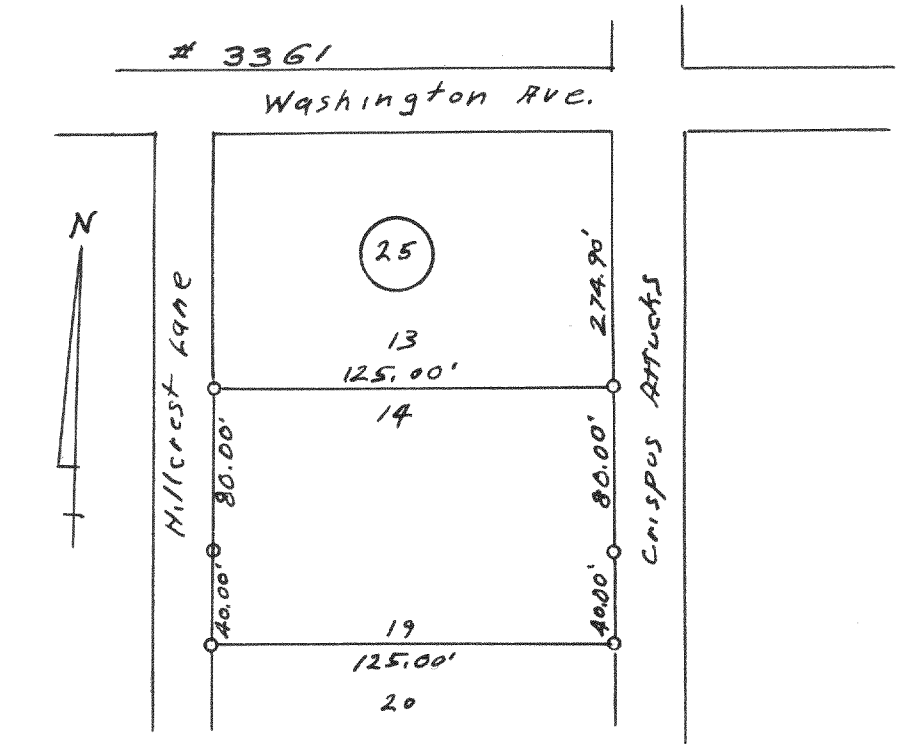


Survey of Lots 14-19 Blk 25 Lake Ivanhoe Resort

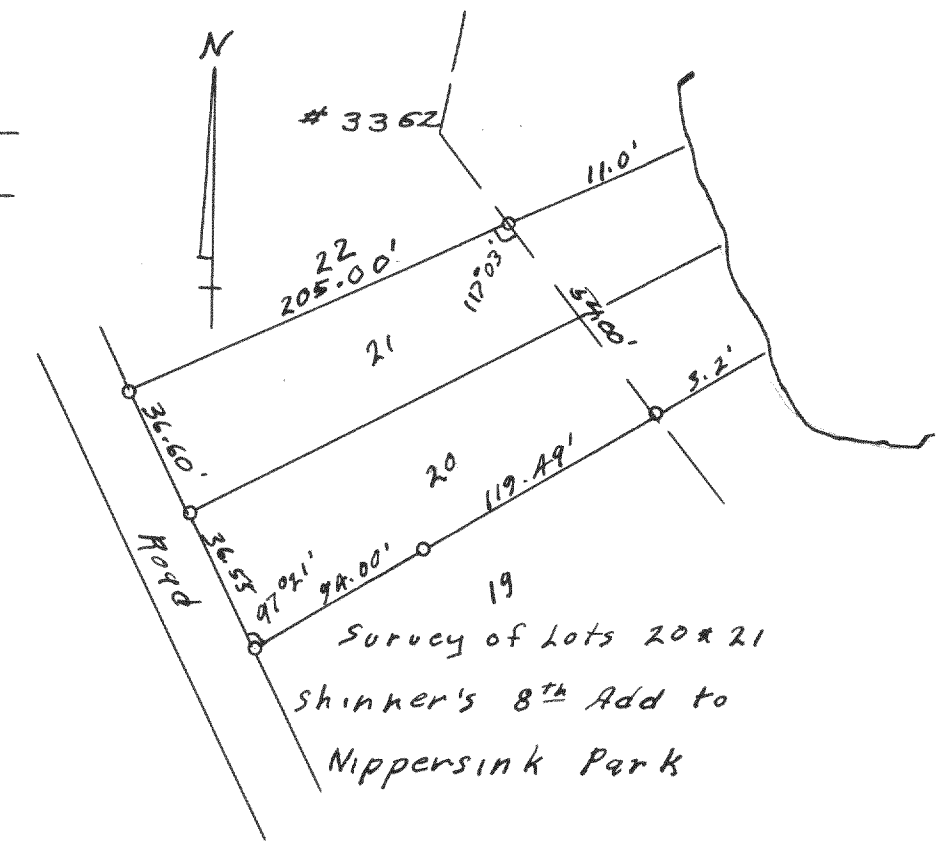


Survey of Lots 20 & 21 Shinner's 8th Add to Nippersink Park

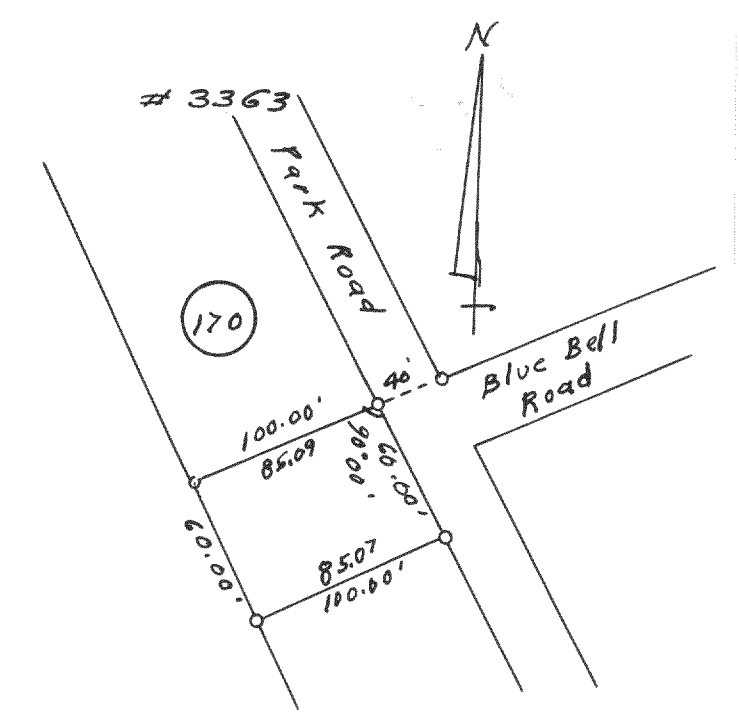


Survey of Lots 8507-9 Blk 170 Section 5 Pell Lake

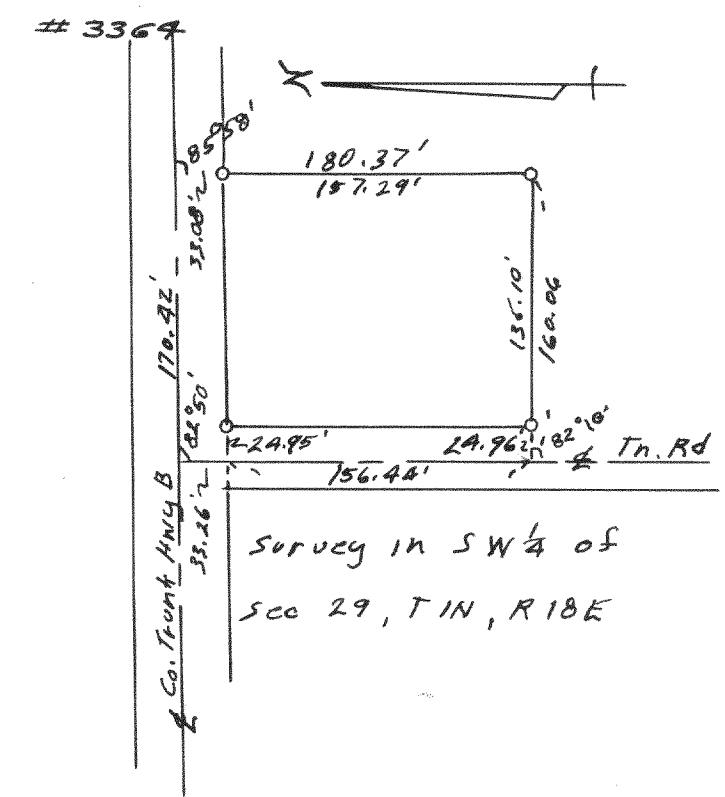


Survey in SW 1/4 of Sec 29, T1N, R18E

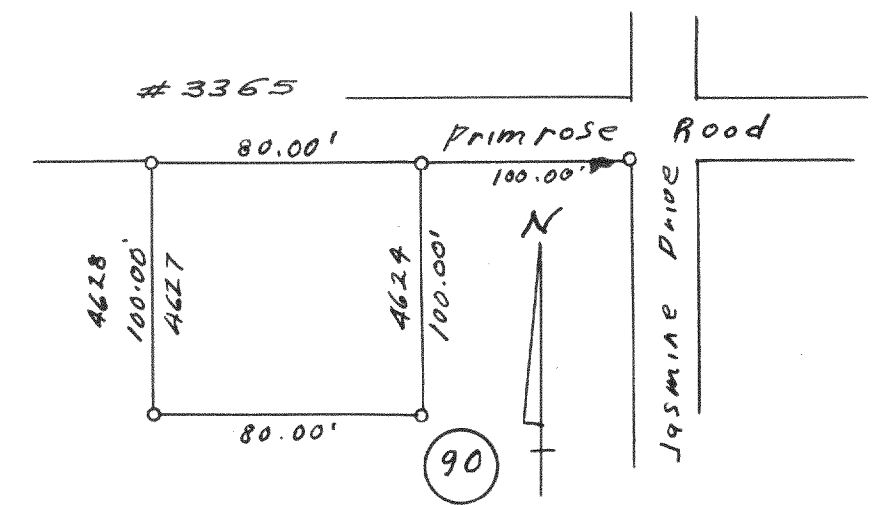


Survey of Lots A624-7 Blk 90 Pell Lake

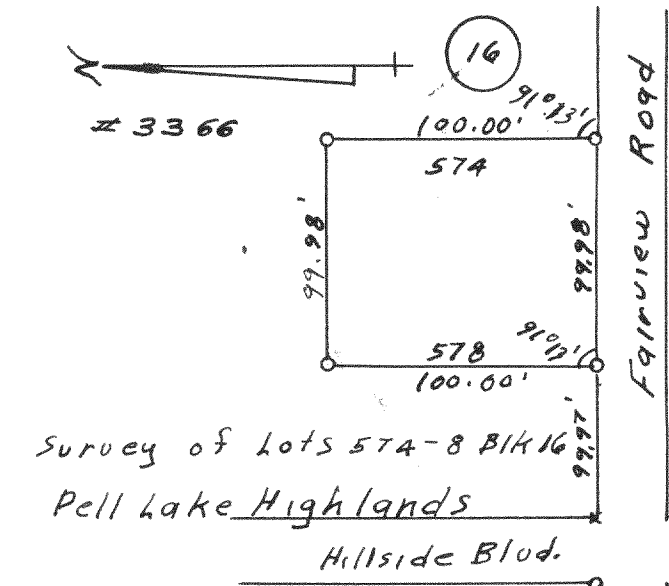


Survey of Lots 574-8 Blk 16 Pell Lake Highlands

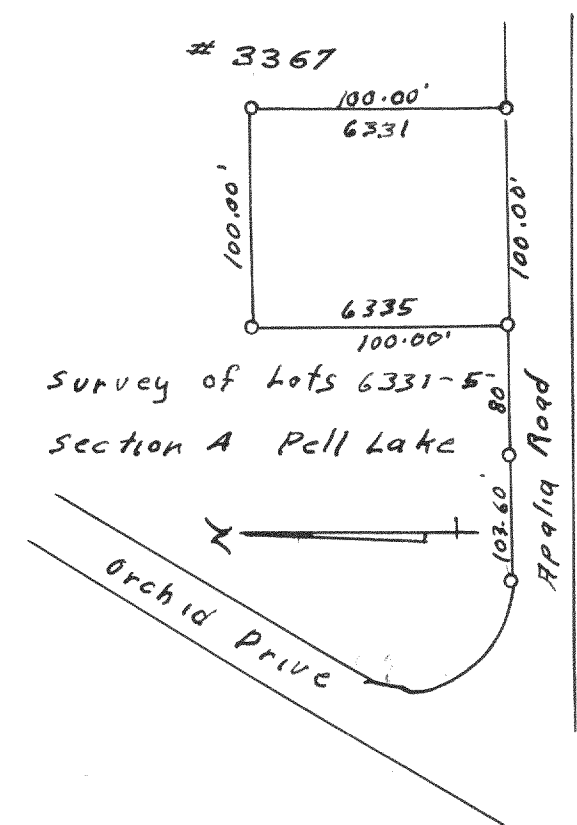


Survey of Lots 6331-5 Section A Pell Lake

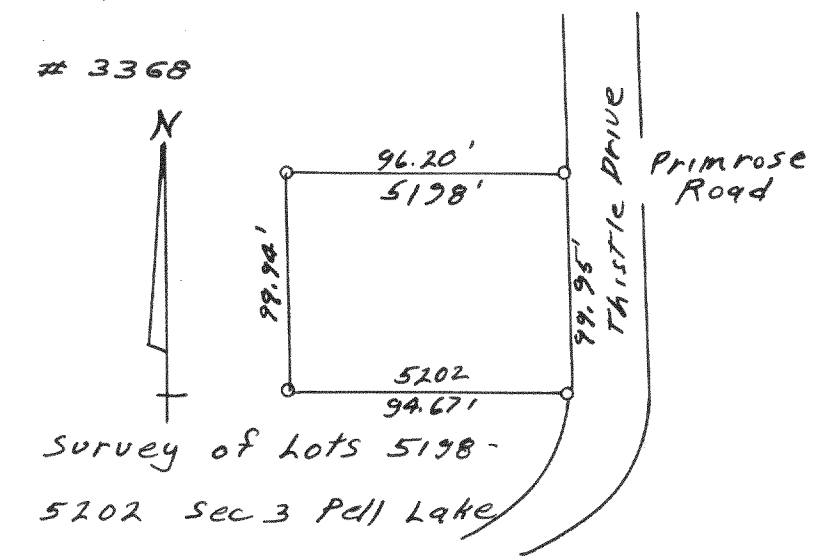


Survey of Lots 5198-5202 Sec 3 Pell Lake

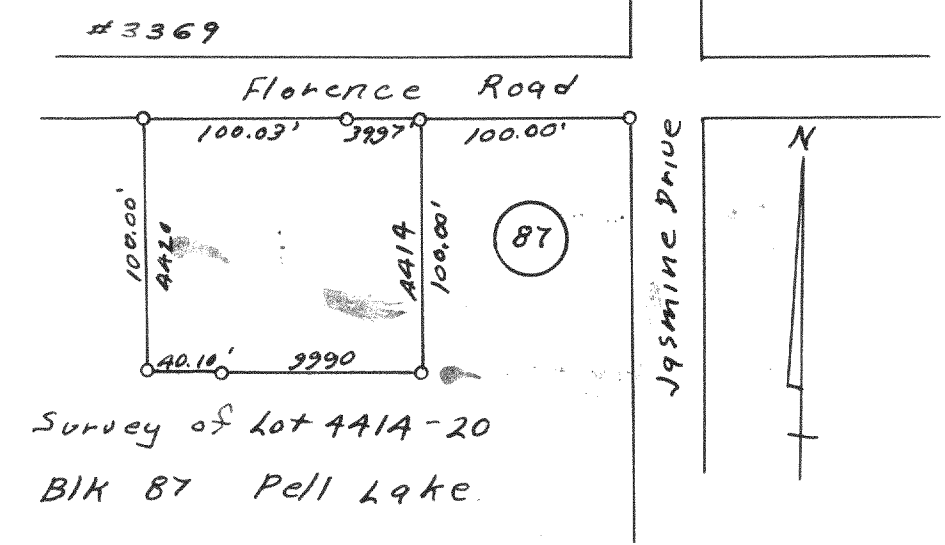

Survey of Lot 441A-20 Blk 87 Pell Lake

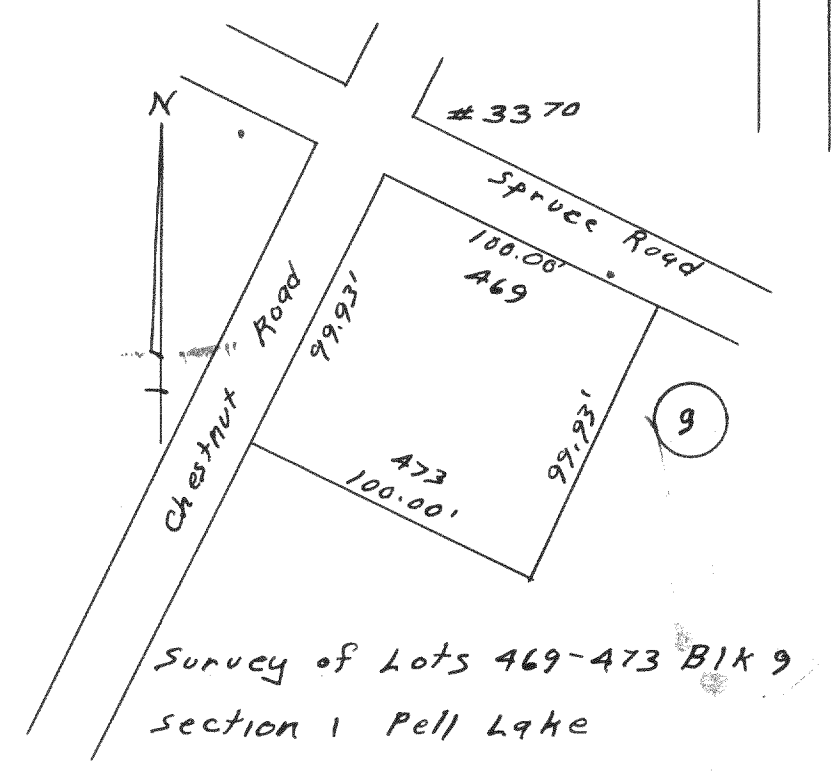

Survey of Lots 469-473 Blk 9 Section 1 Pell Lake

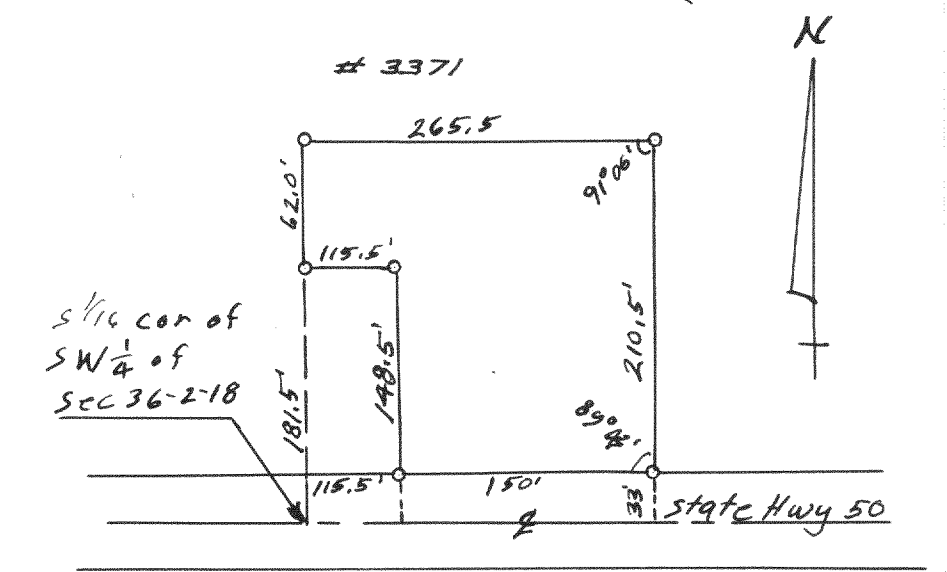

Survey in SE 1/4 SW 1/4 Sec 36, T2N, R18E