
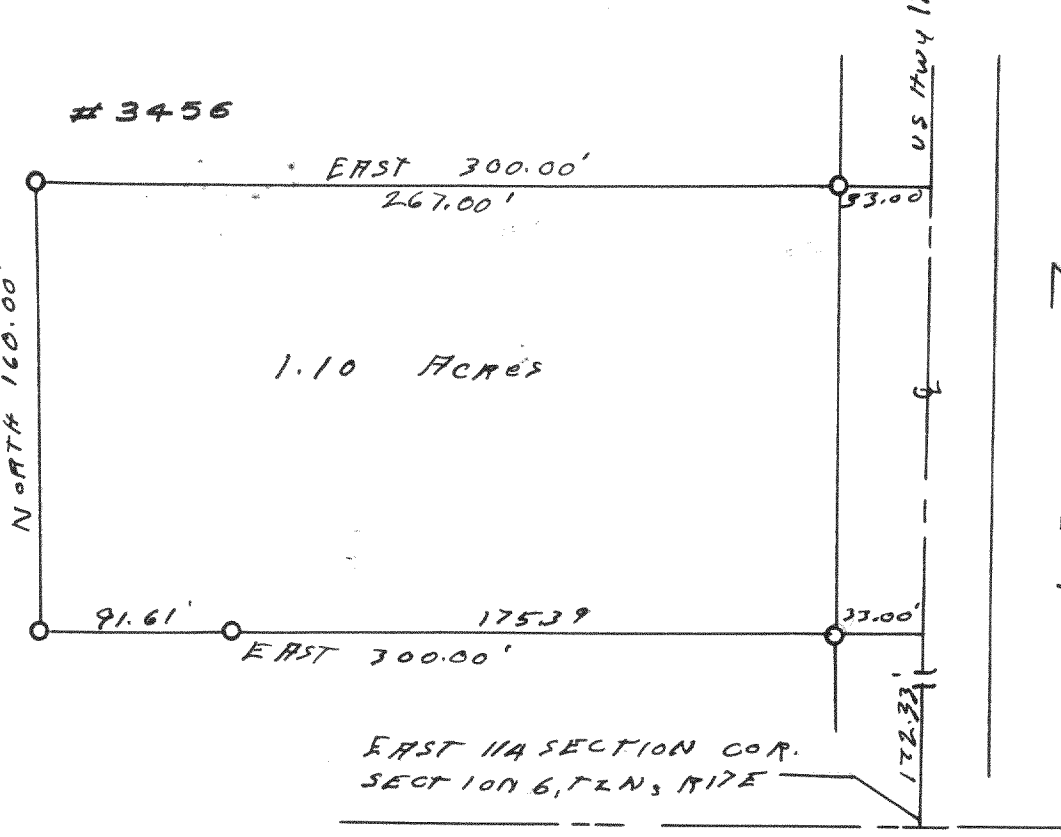


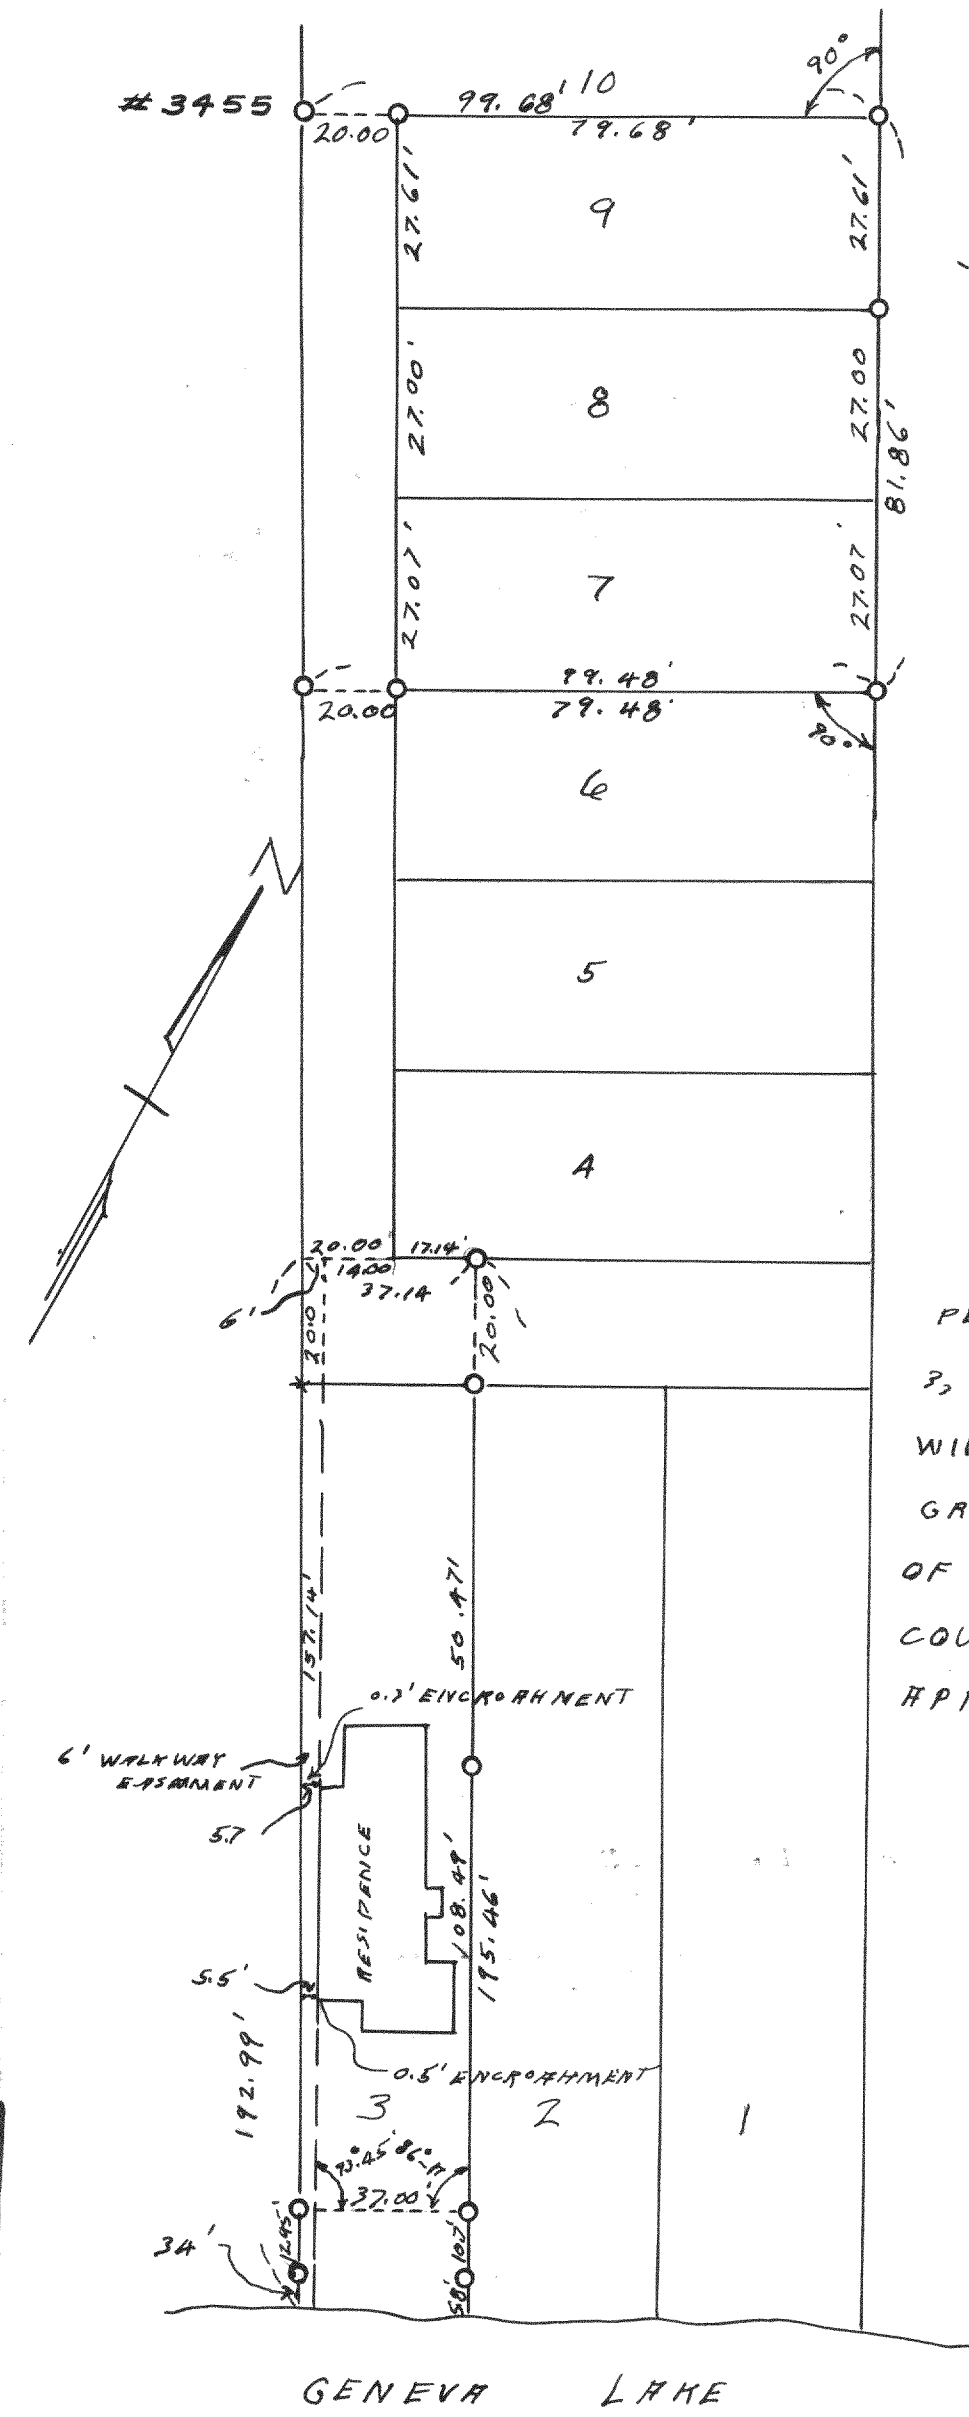


PLAT OF SURVEY OF A
PARCEL OF LAND IN THE
NW 1/4 OF SEC. 6, T2N, R1E
WALWORTH COUNTY WISCONSIN
FEB 58 LLOYD L. JENSEN
COUNTY SURVEYOR

PLAT OF SURVEY OF LOTS
3, 7, 8 AND 9 IN WILLIAM G.
WILLIAMSON'S SUB. OF LOT 7
GRAND TERRACE SUB., VILLAGE
OF WILLIAMS BAY, WALWORTH
COUNTY, WISCONSIN
APRIL 57 LLOYD L. JENSEN
COUNTY SURVEYOR

PLAT OF SURVEY OF OUT
LOTS 86 & 87 LOCATED IN THE
SOUTH WEST 1/4 OF SECTION
22, T1N, R1E, VILLAGE OF
WALWORTH, WALWORTH
COUNTY, WISCONSIN
MARCH 58 LLOYD L. JENSEN
COUNTY SURVEYOR

WEST 1/4 COR. OF
SEC. 22, T1N, R1E

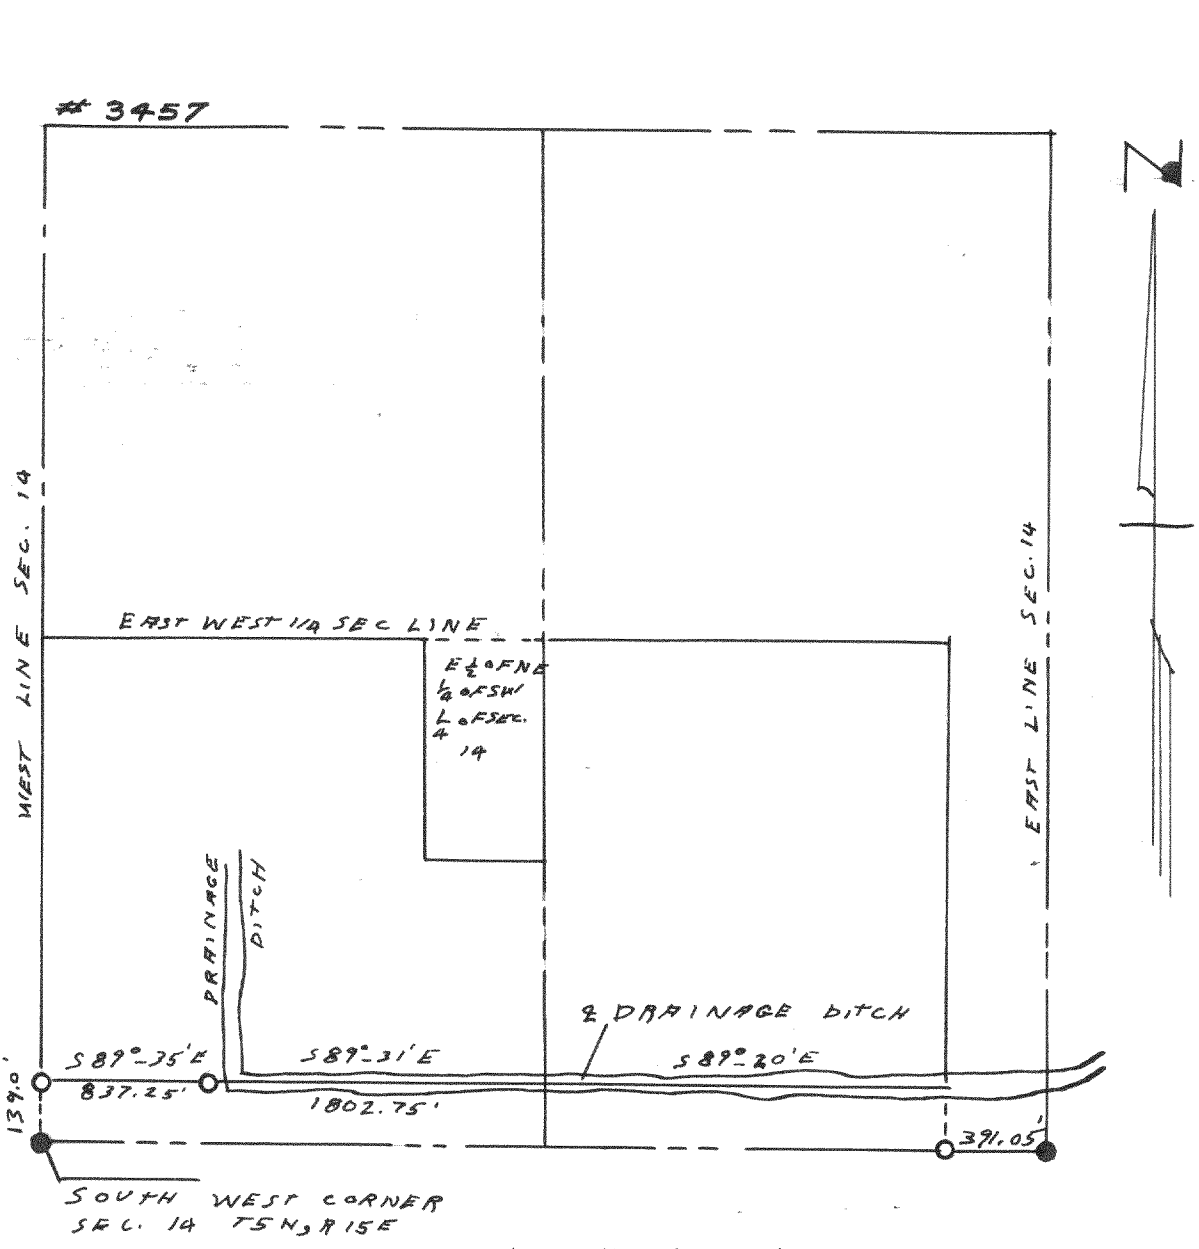

PLAT OF SURVEY OF PARCEL
OF LAND LOCATED IN THE
S 1/2 OF SECTION 14 T5N, R1E
JEFFERSON COUNTY, WISCONSIN
MARCH 58 LLOYD L. JENSEN
COUNTY SURVEYOR

