



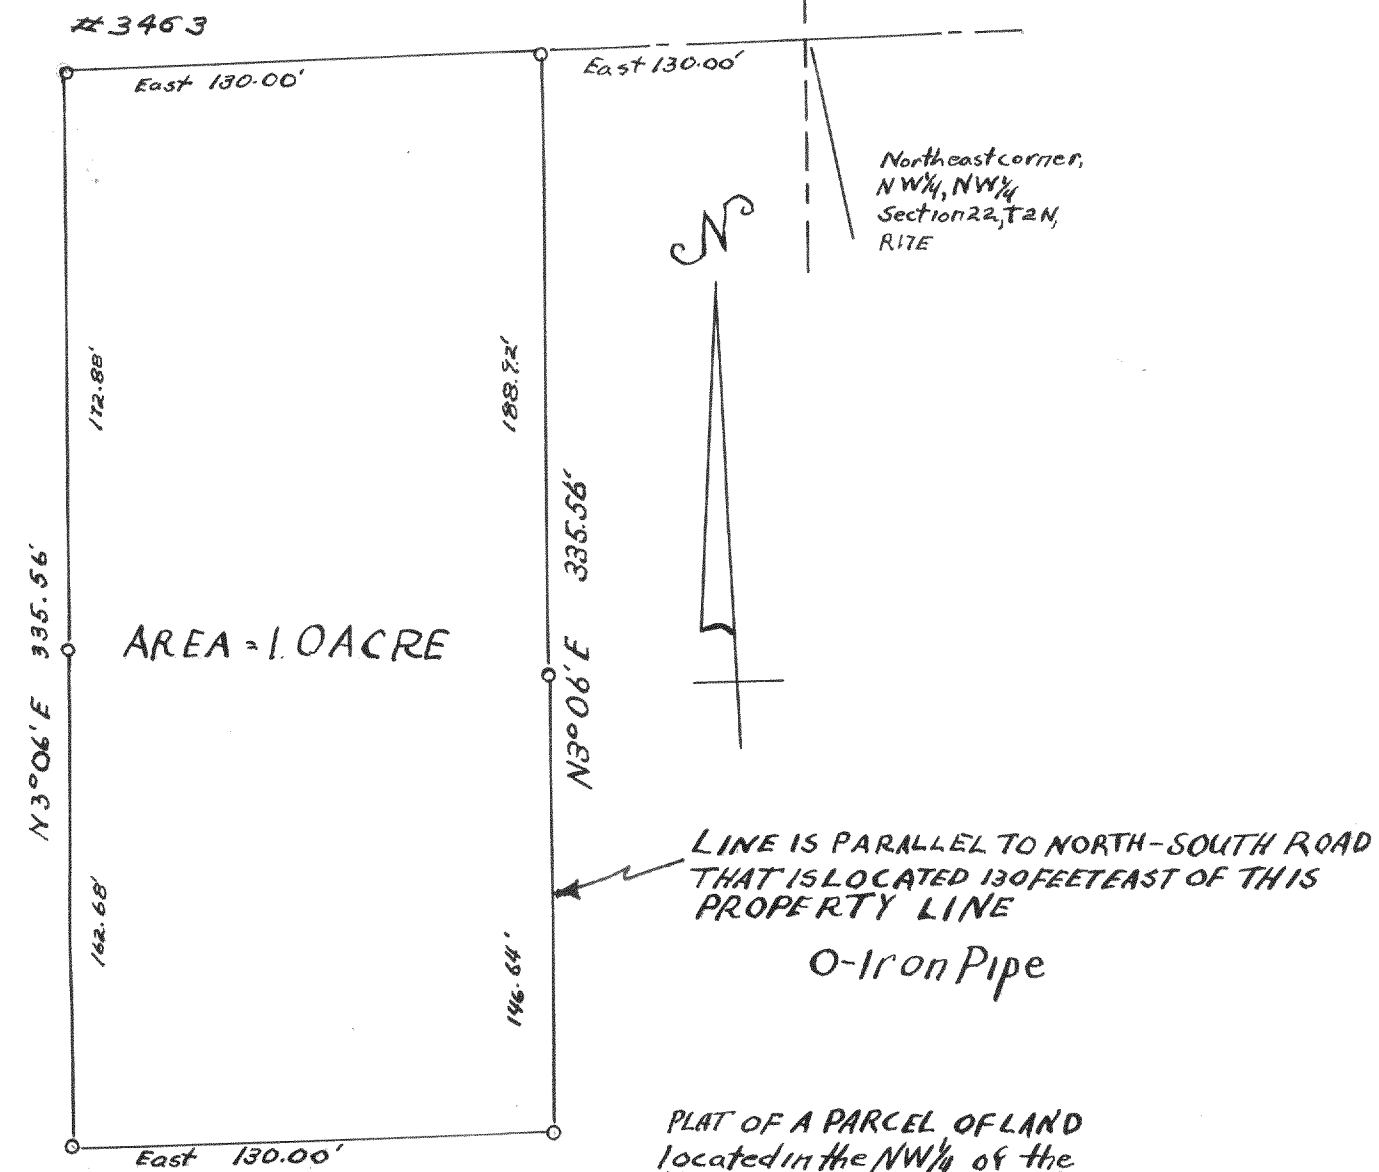

PLAT OF A PARCEL OF LAND located in the NW 1/4 of the NW 1/4 of Section 22, T2N, R17E, Walworth County, Wisconsin Nov, 1957 Lloyd L. JENSEN SURVEYOR

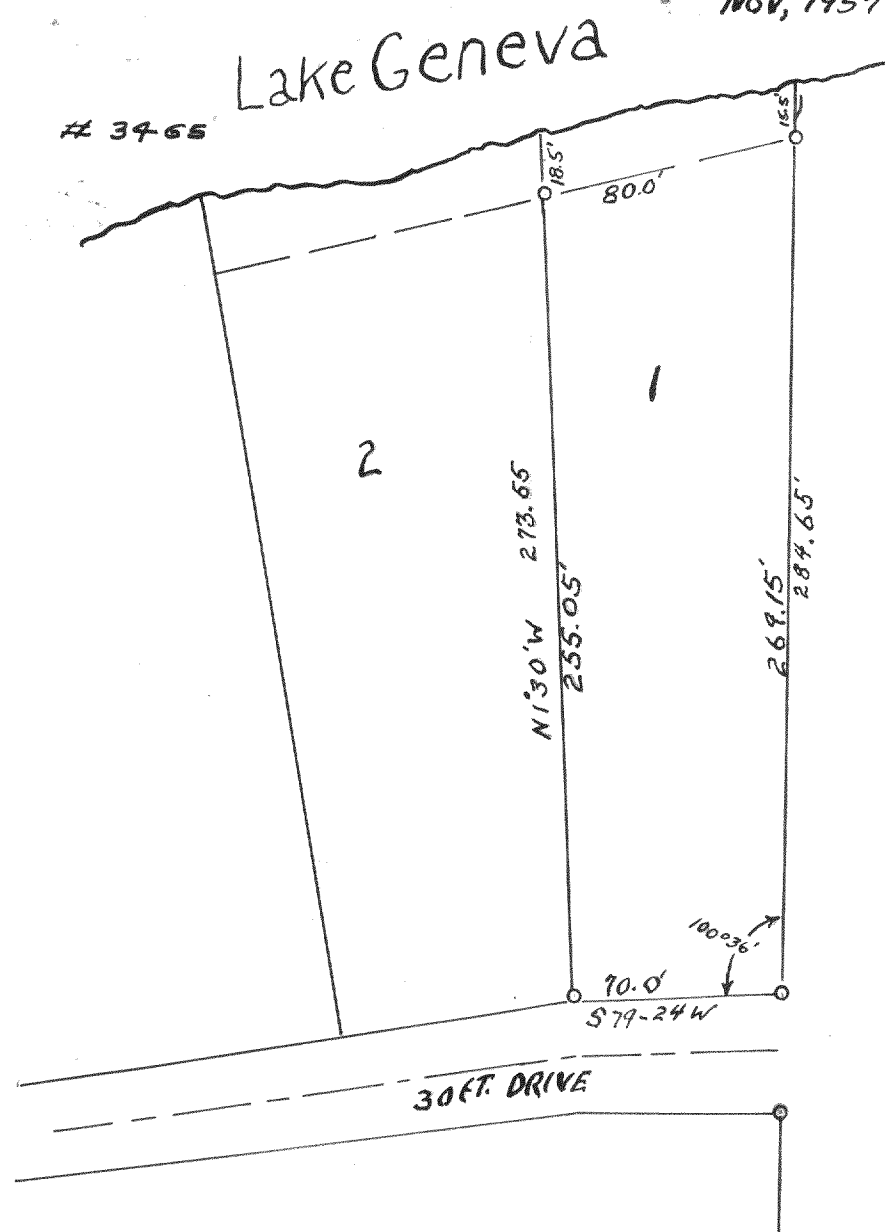

PLAT OF SURVEY OF Lot 1 of the Birches First Addition, Located in Section 9, T1N, R17E of Walworth County, Wisconsin Nov, 1957 Lloyd L. Jensen County Surveyor

- IRON PIPE
- IRON PIPE IN CONCRETE

3464

Satinwood Road

