



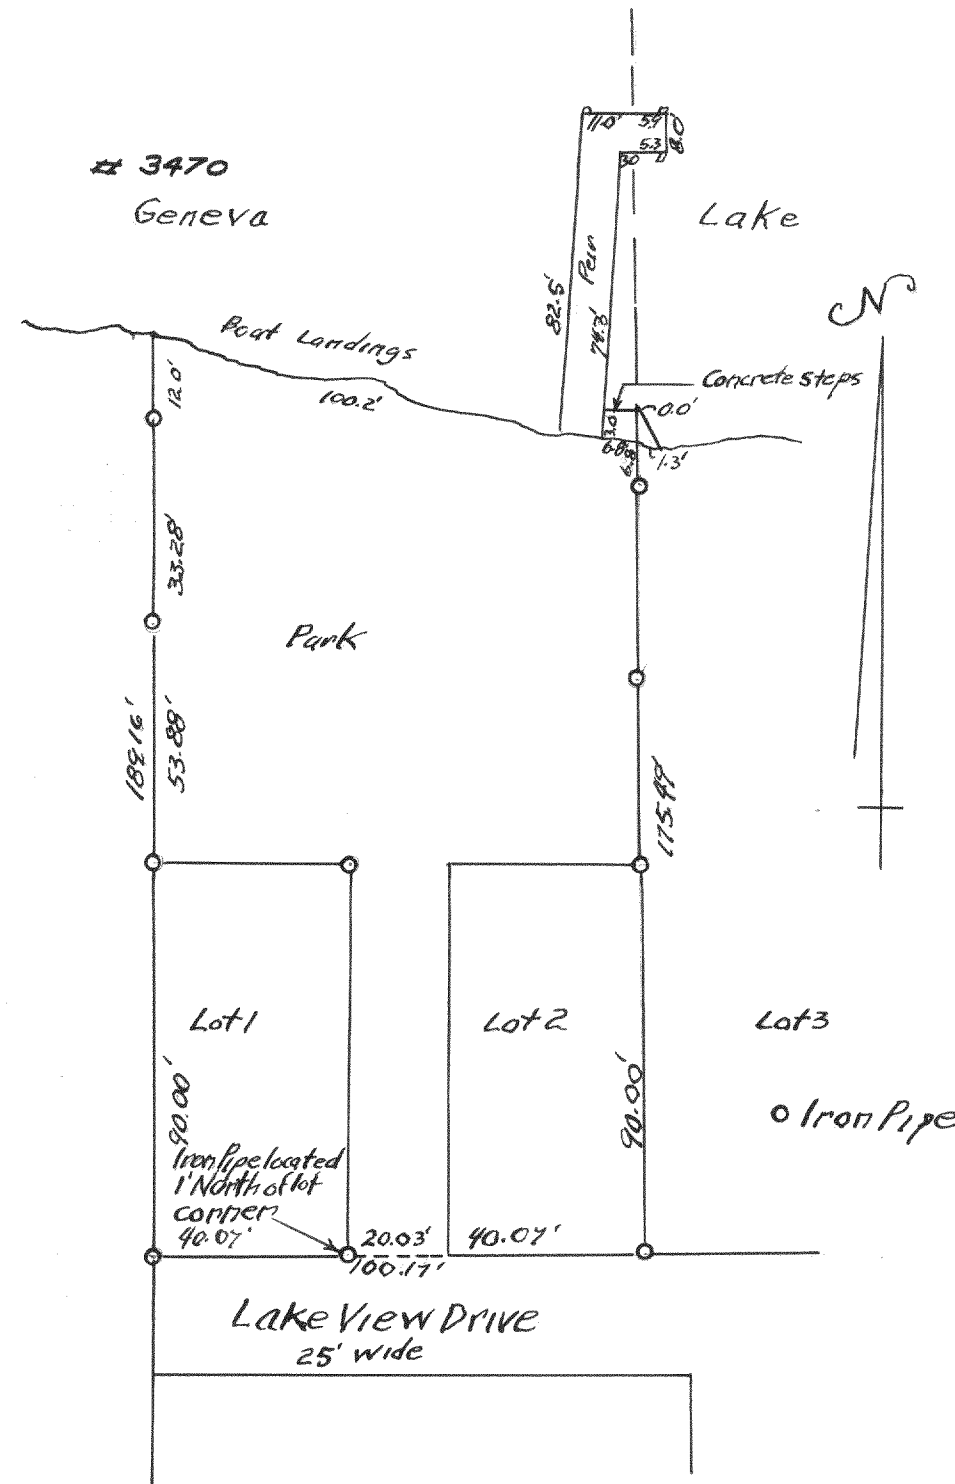


Plat Of Survey of Park
located in Edgewater Terrace,
in Section 9, T1N, R17E, Walworth
County, Wisconsin
July, 1957

Lloyd L. Jensen
County Surveyor

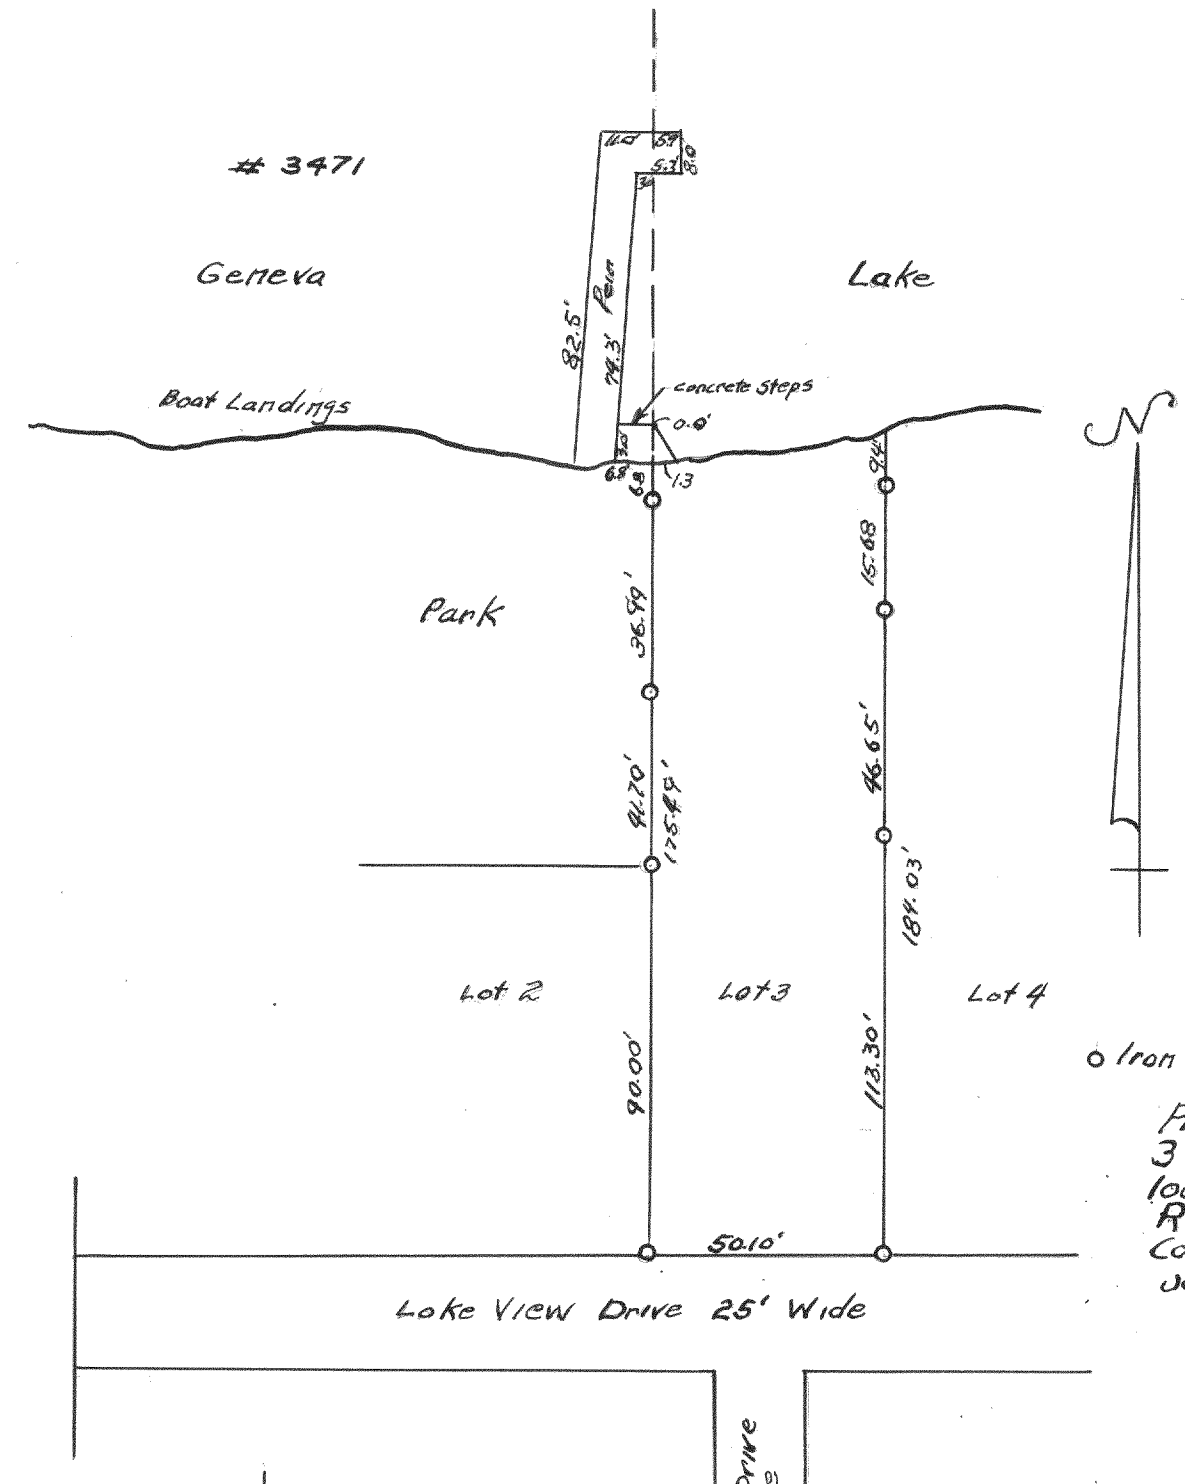

Plat Of Survey of lot
3 of Edgewater Terrace
located in Section 9, T1N,
R17E, Walworth
County, Wisconsin
July, 1957

Lloyd L. Jensen
County Surveyor

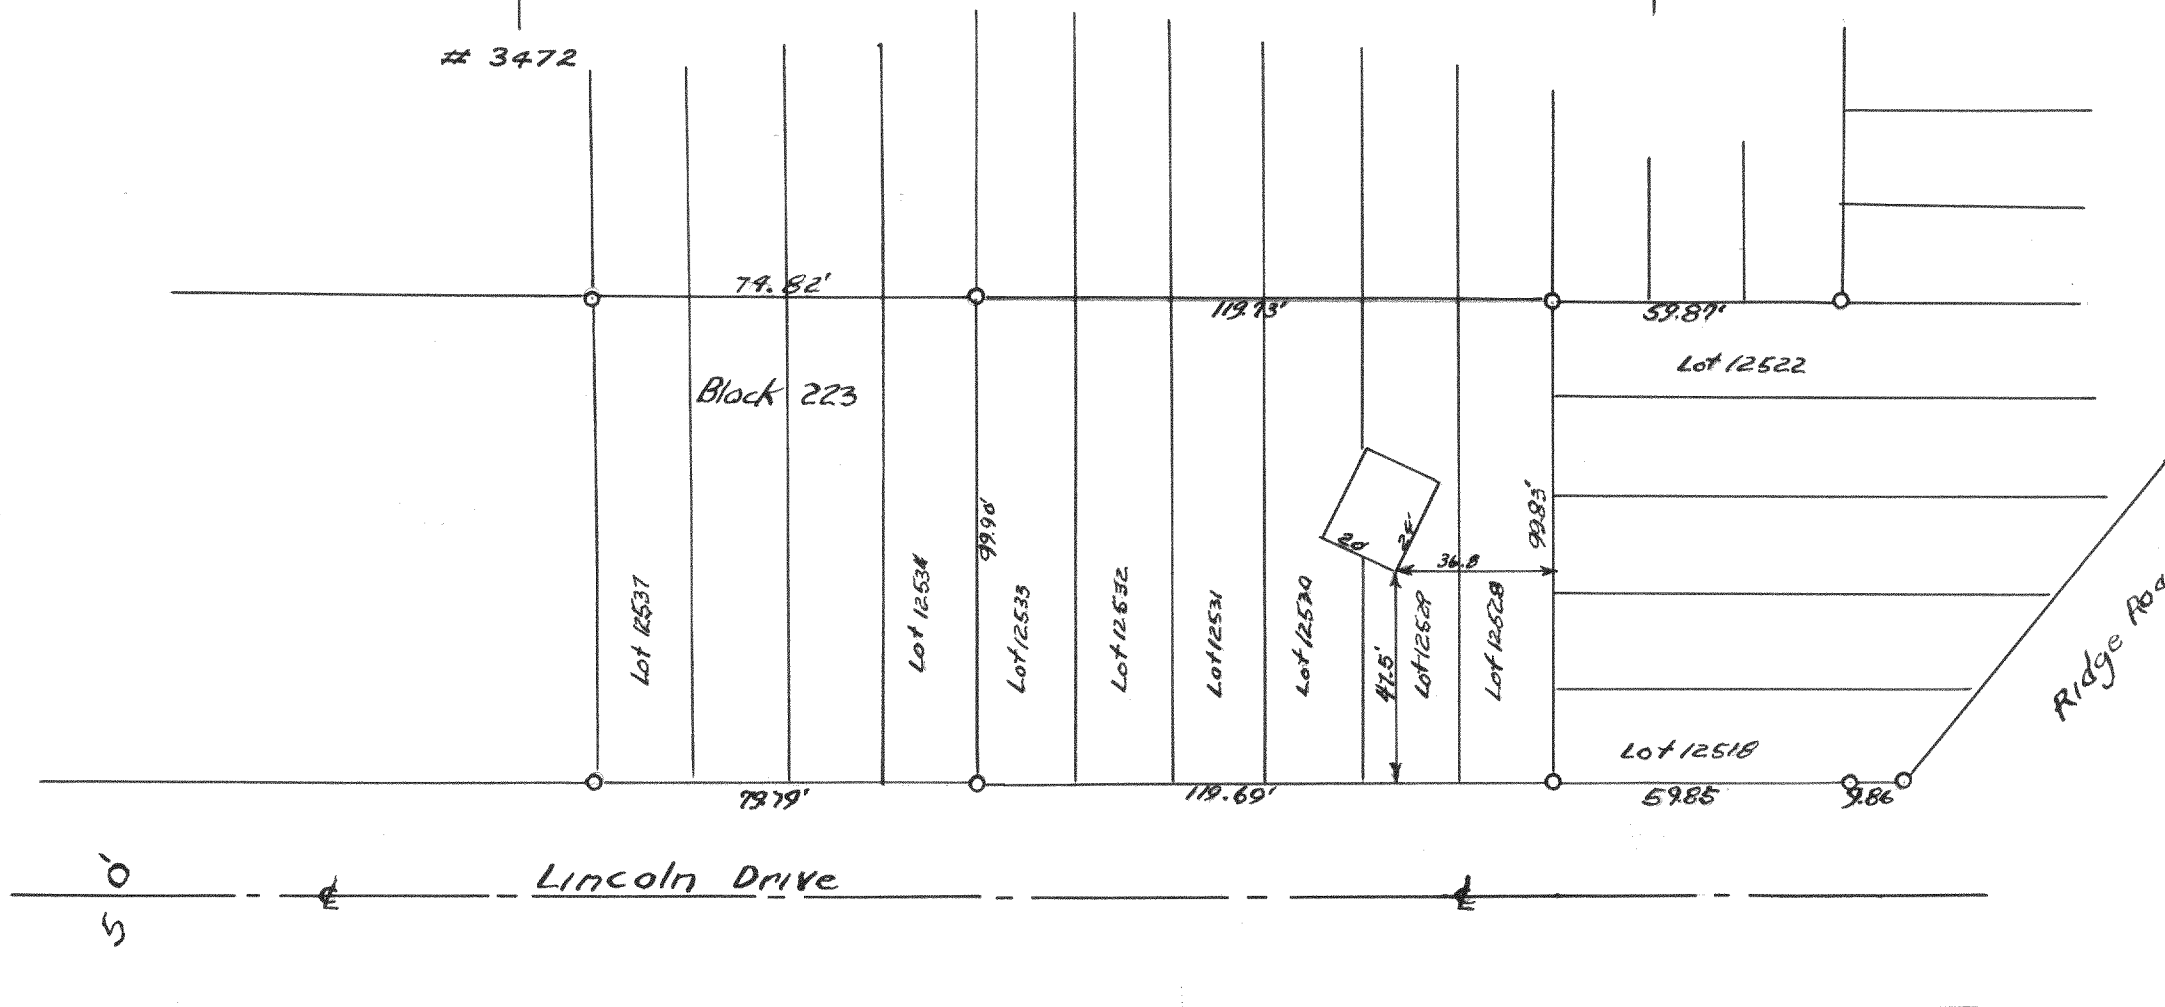

Plat Of Survey of
Lots 12528 to 12533,
Block 223, Lake Como
Beach, NE 1/4 Section 29,
T2N, R17E, Walworth
County, Wisconsin
June, 1957

Lloyd L. Jensen
County Surveyor