


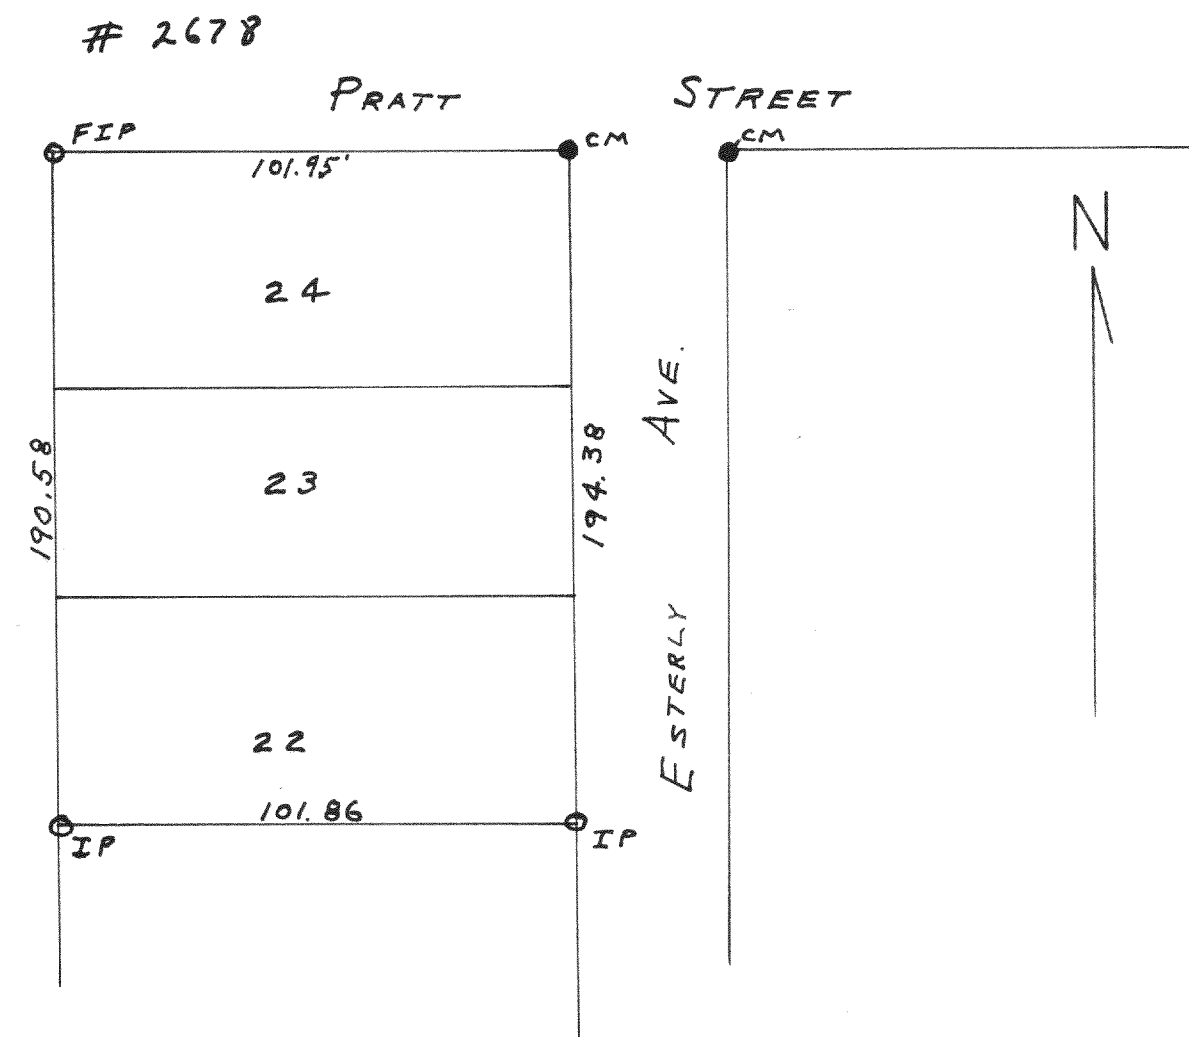


PLAT OF SURVEY OF LOTS 22, 23, + 24 OF BLOCK
2 OF FISH & JOHNSON'S ADDITION TO THE CITY
OF WHITEWATER.

JUNE 30, 1952

2680

Lloyd L Jensen SA
COUNTY SURVEYOR

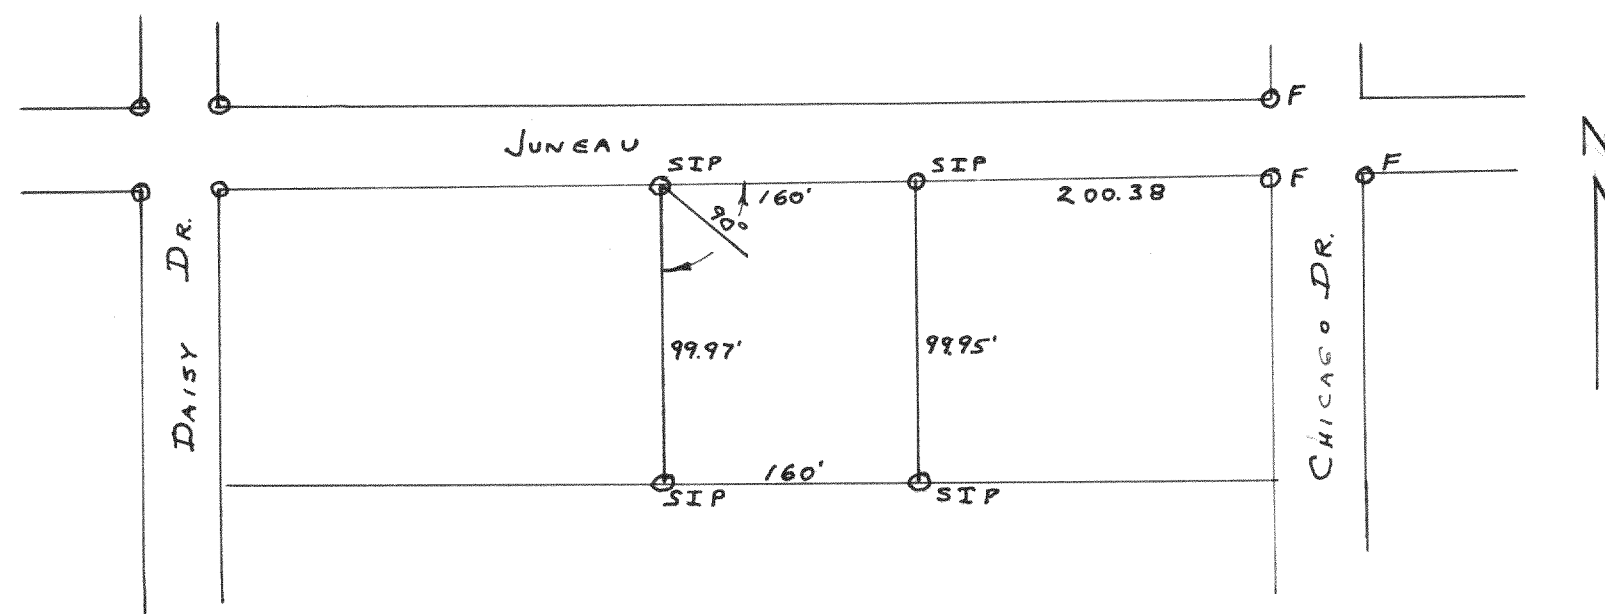


PLAT OF SURVEY OF LOTS 442 TO 449 BLOCK 2
OF PELL LAKE ADDITION

AUGUST 2, 1952

Lloyd L Jensen SA
COUNTY SURVEYOR

2679

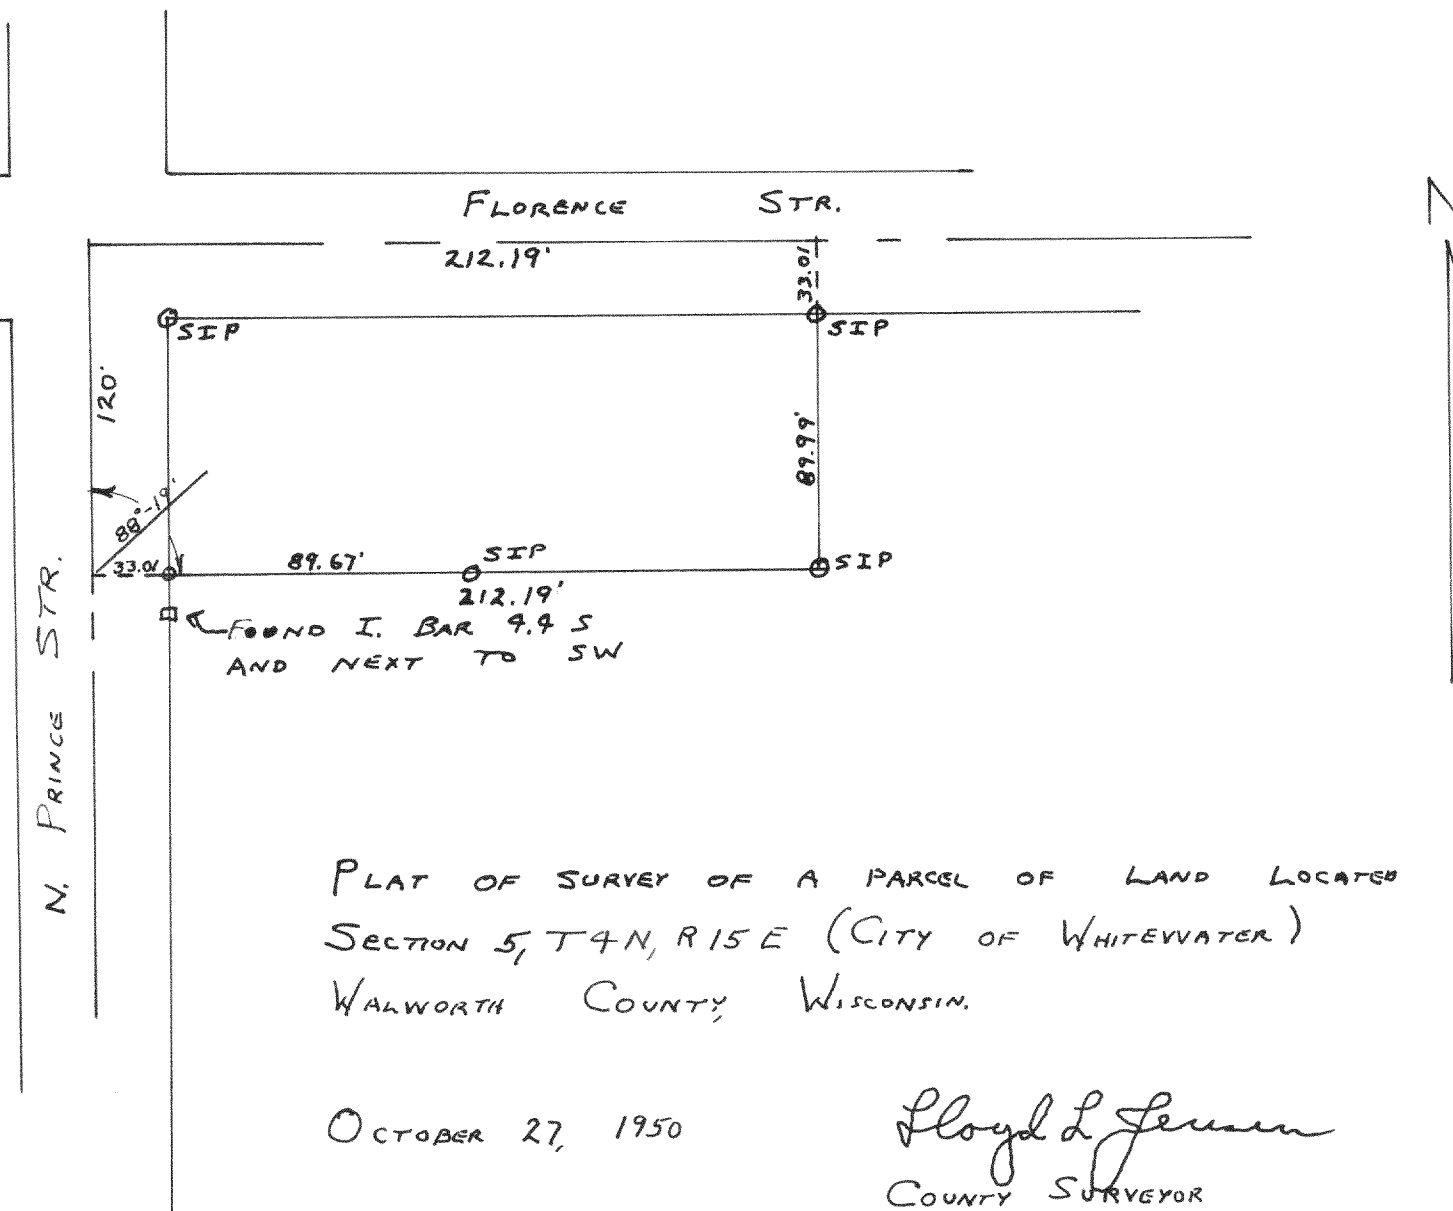


PLAT OF SURVEY OF A PARCEL OF LAND LOCATED IN
SECTION 5, T4N, R1E (CITY OF WHITEWATER)
WALWORTH COUNTY, WISCONSIN.

OCTOBER 27, 1950

Lloyd L Jensen
COUNTY SURVEYOR

2681

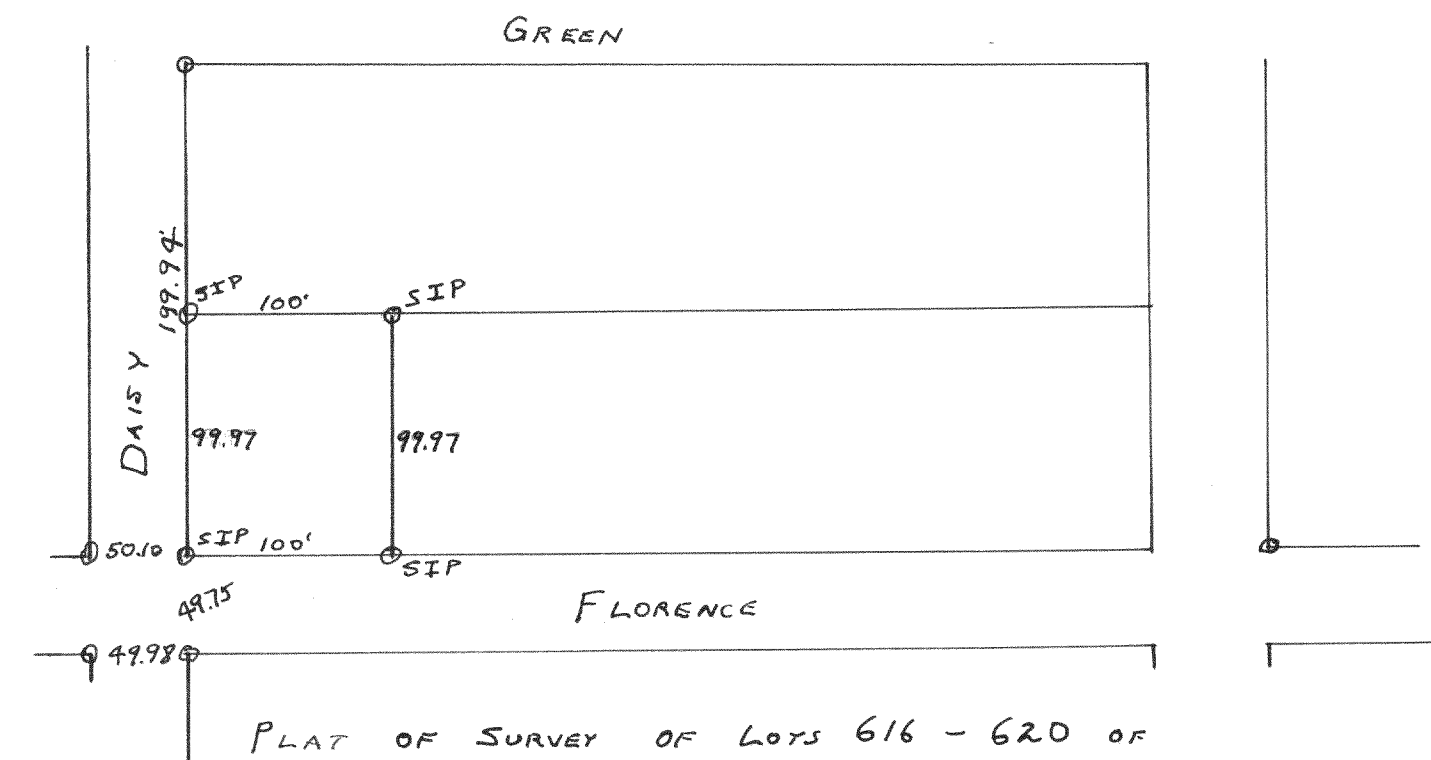

PLAT OF SURVEY OF LOTS 616 - 620 OF
BLOCK 10 OF PELL LAKE ADDITION.

AUGUST 2, 1952

Lloyd L Jensen
COUNTY SURVEYOR