



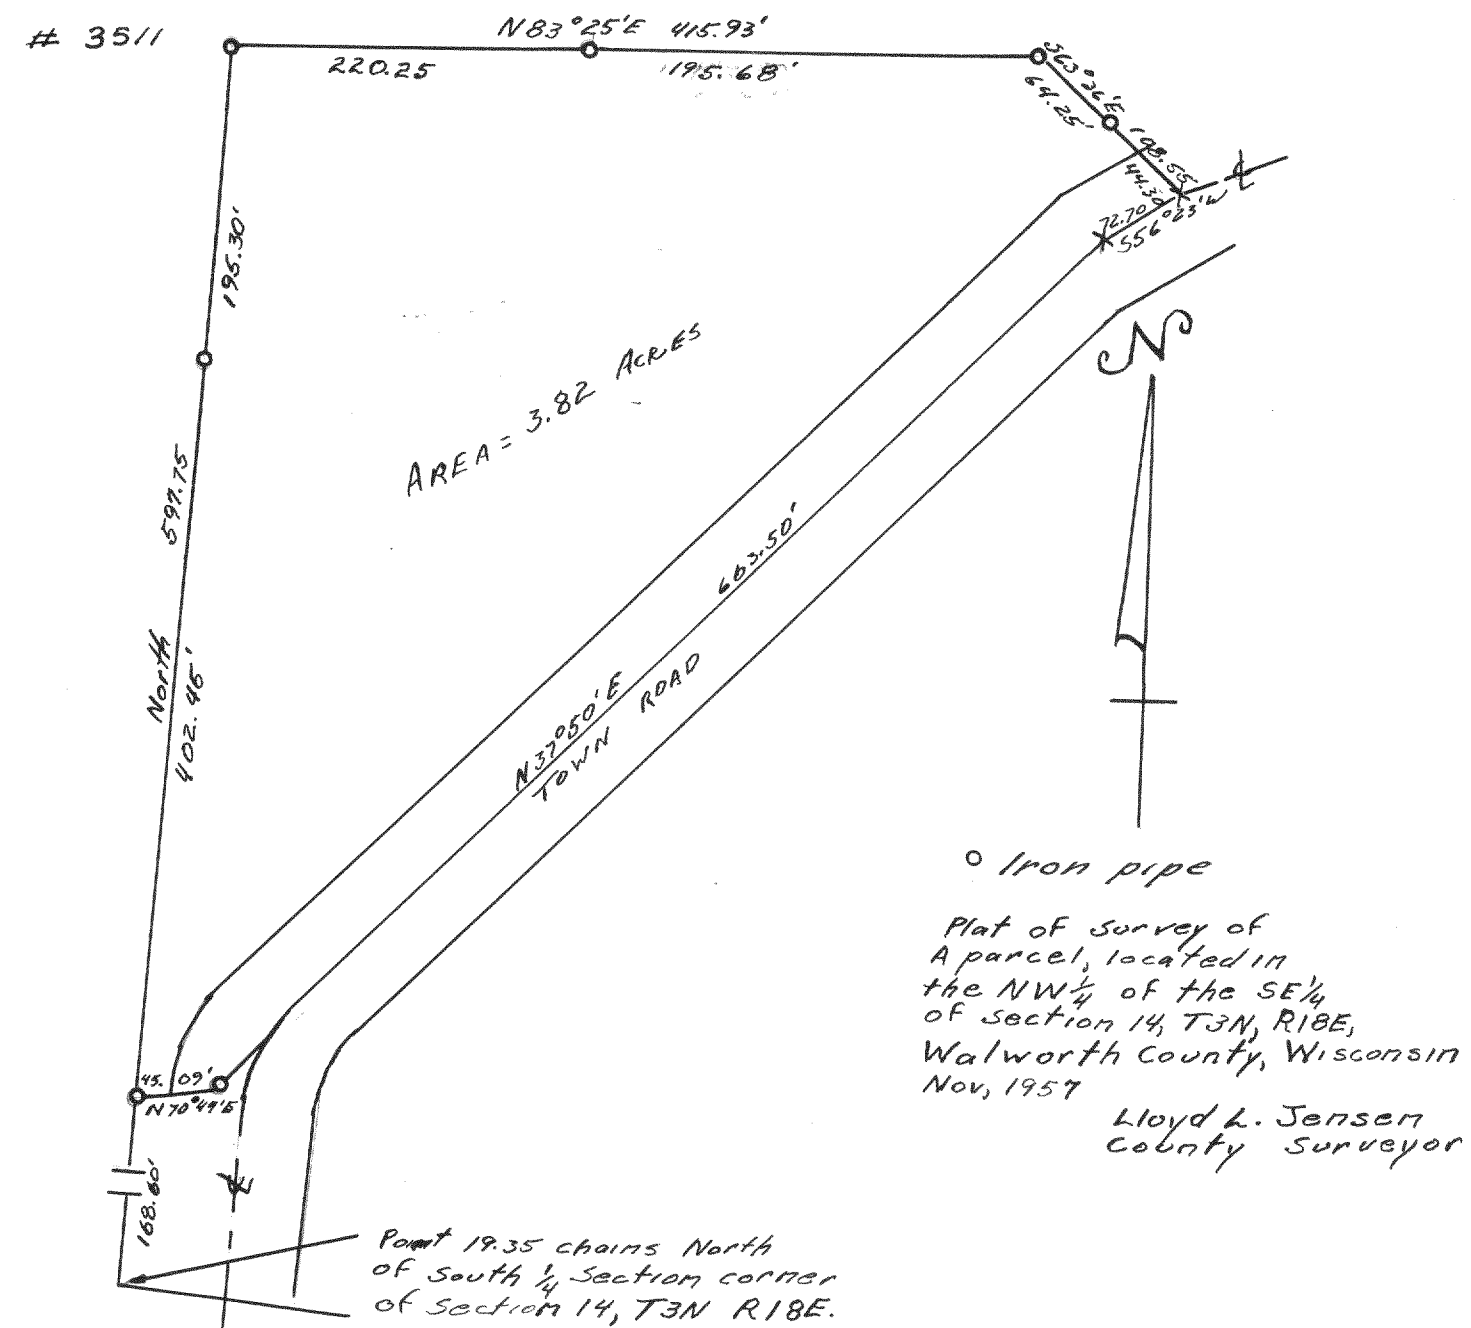


3512

Plat of Survey of Lots 11, 12, 13, Block 2, MIRAMAR Subdivision, Section 11 T4N, R18E, Walworth County, Wisconsin Sept 1957

Lloyd L. Jensen County Surveyor

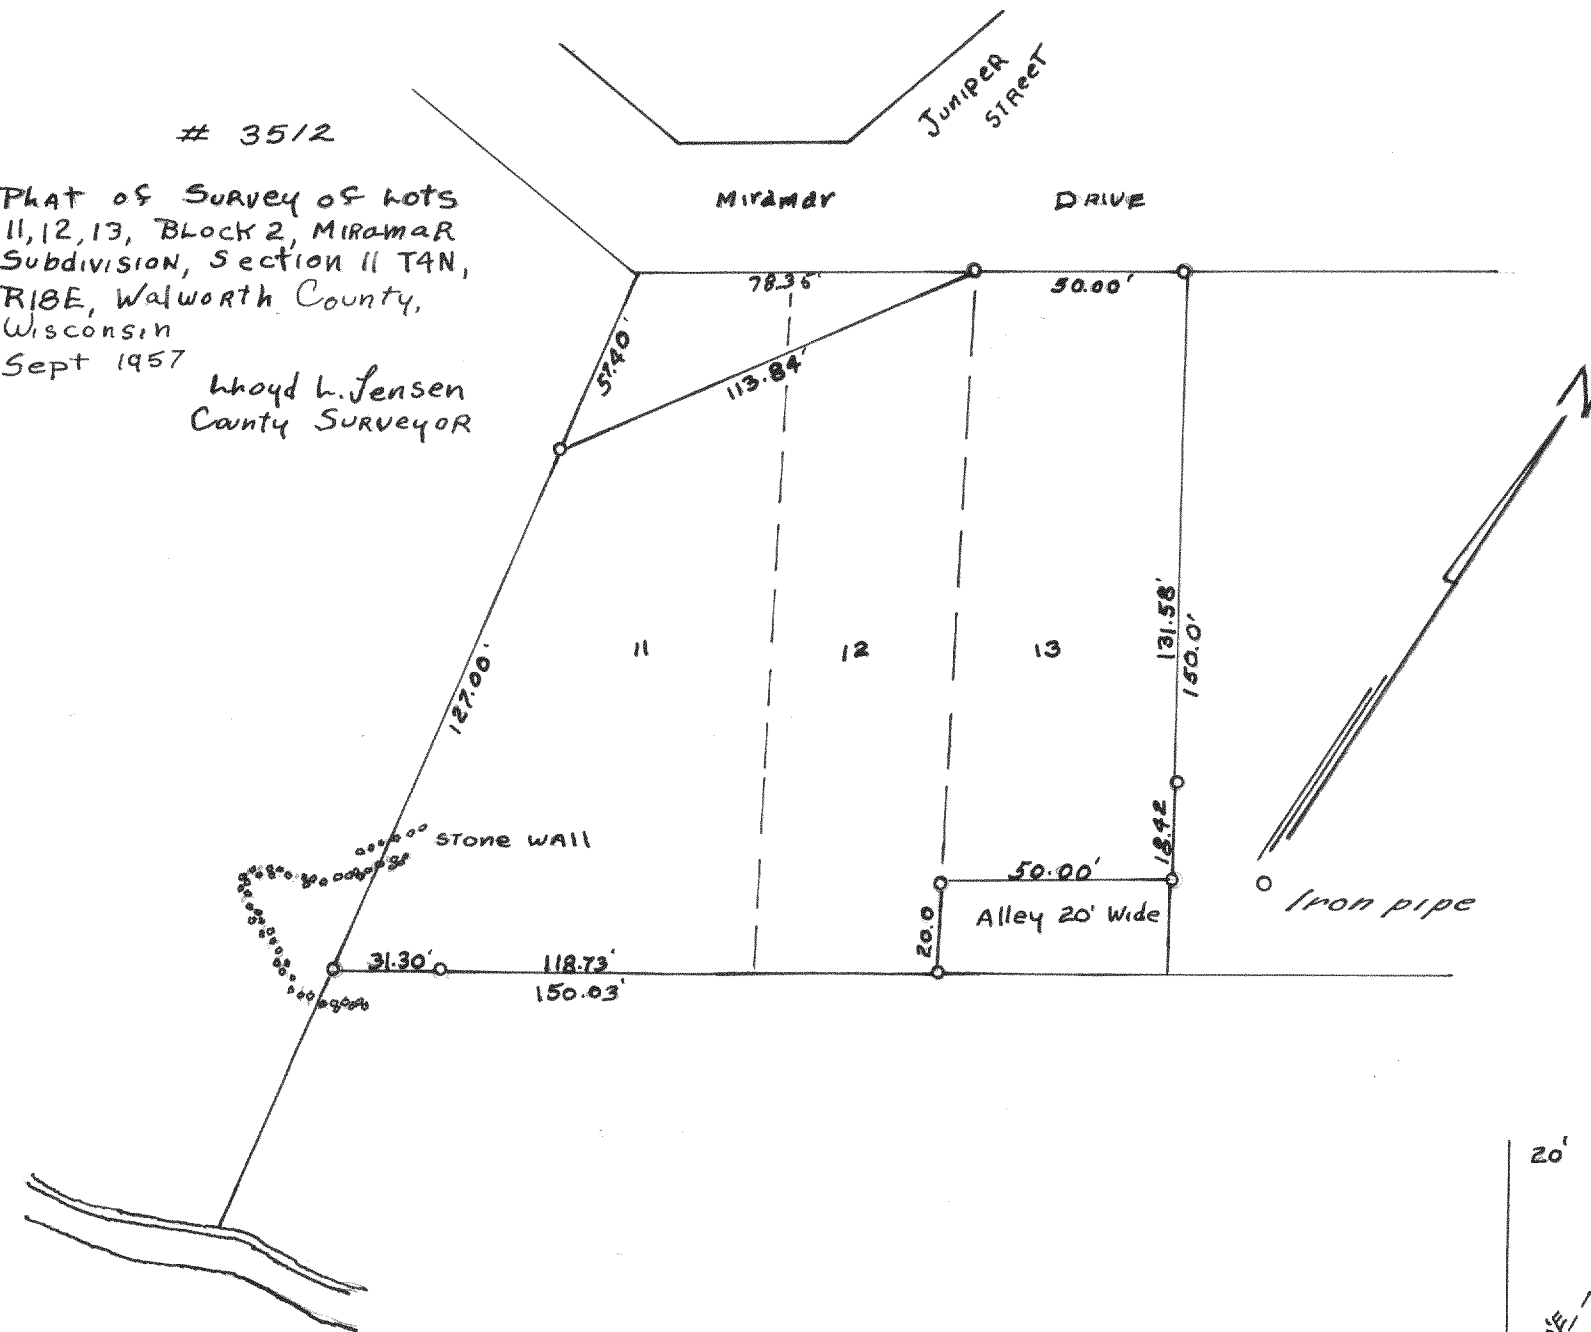

3513

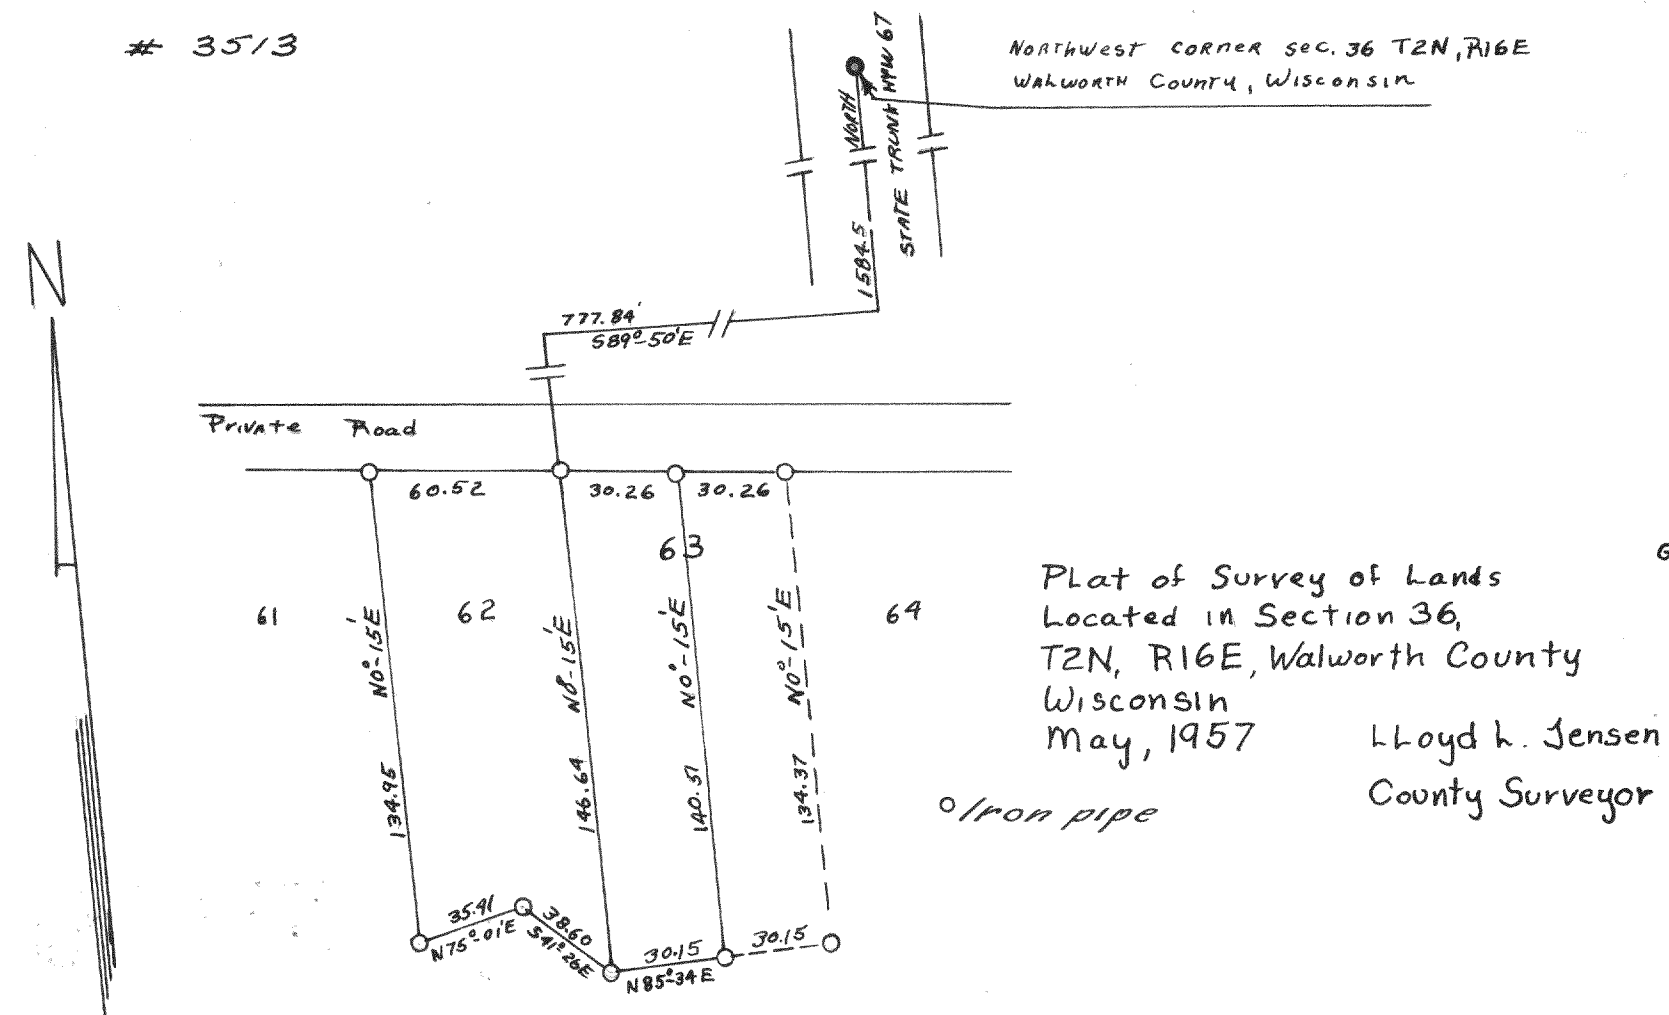

3514

