

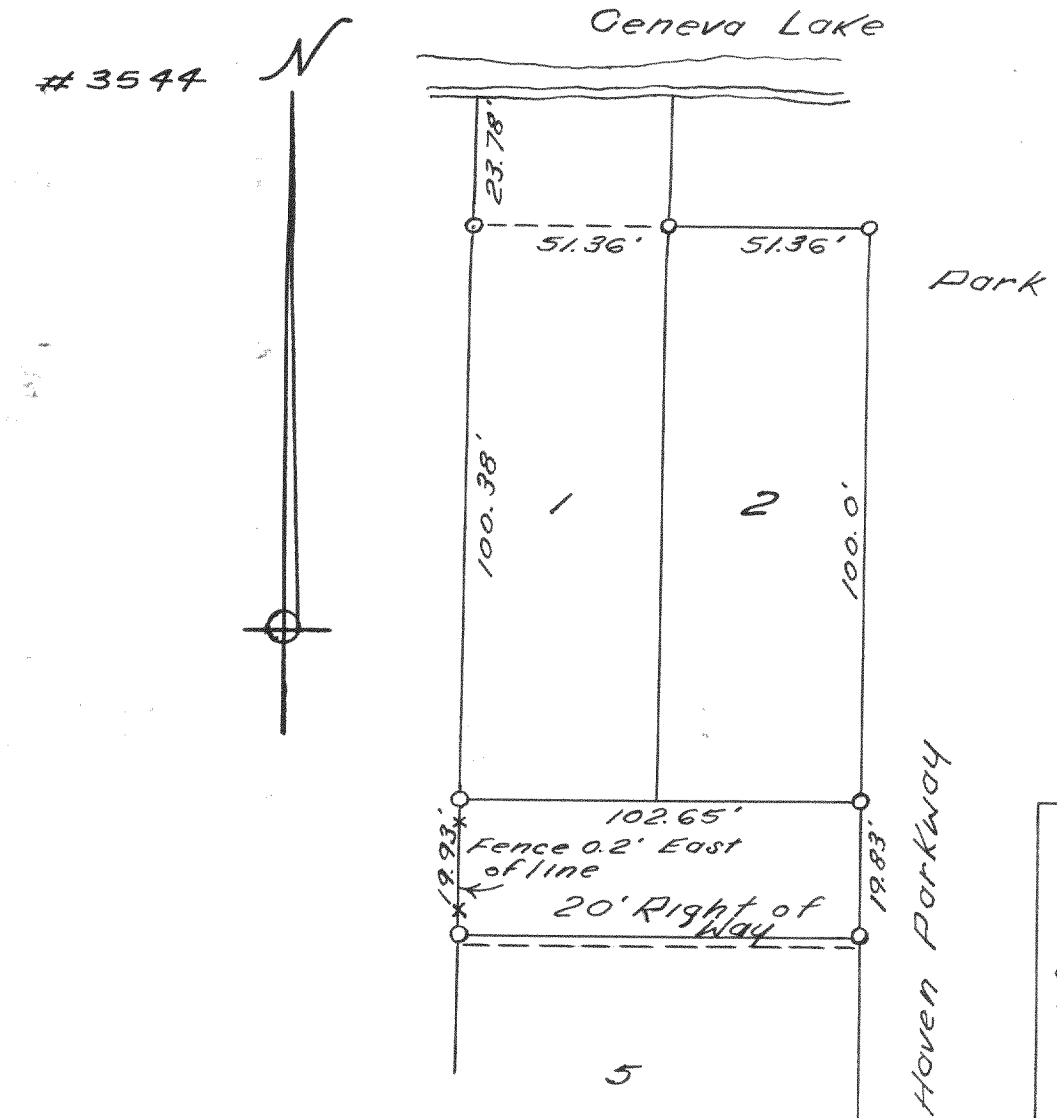


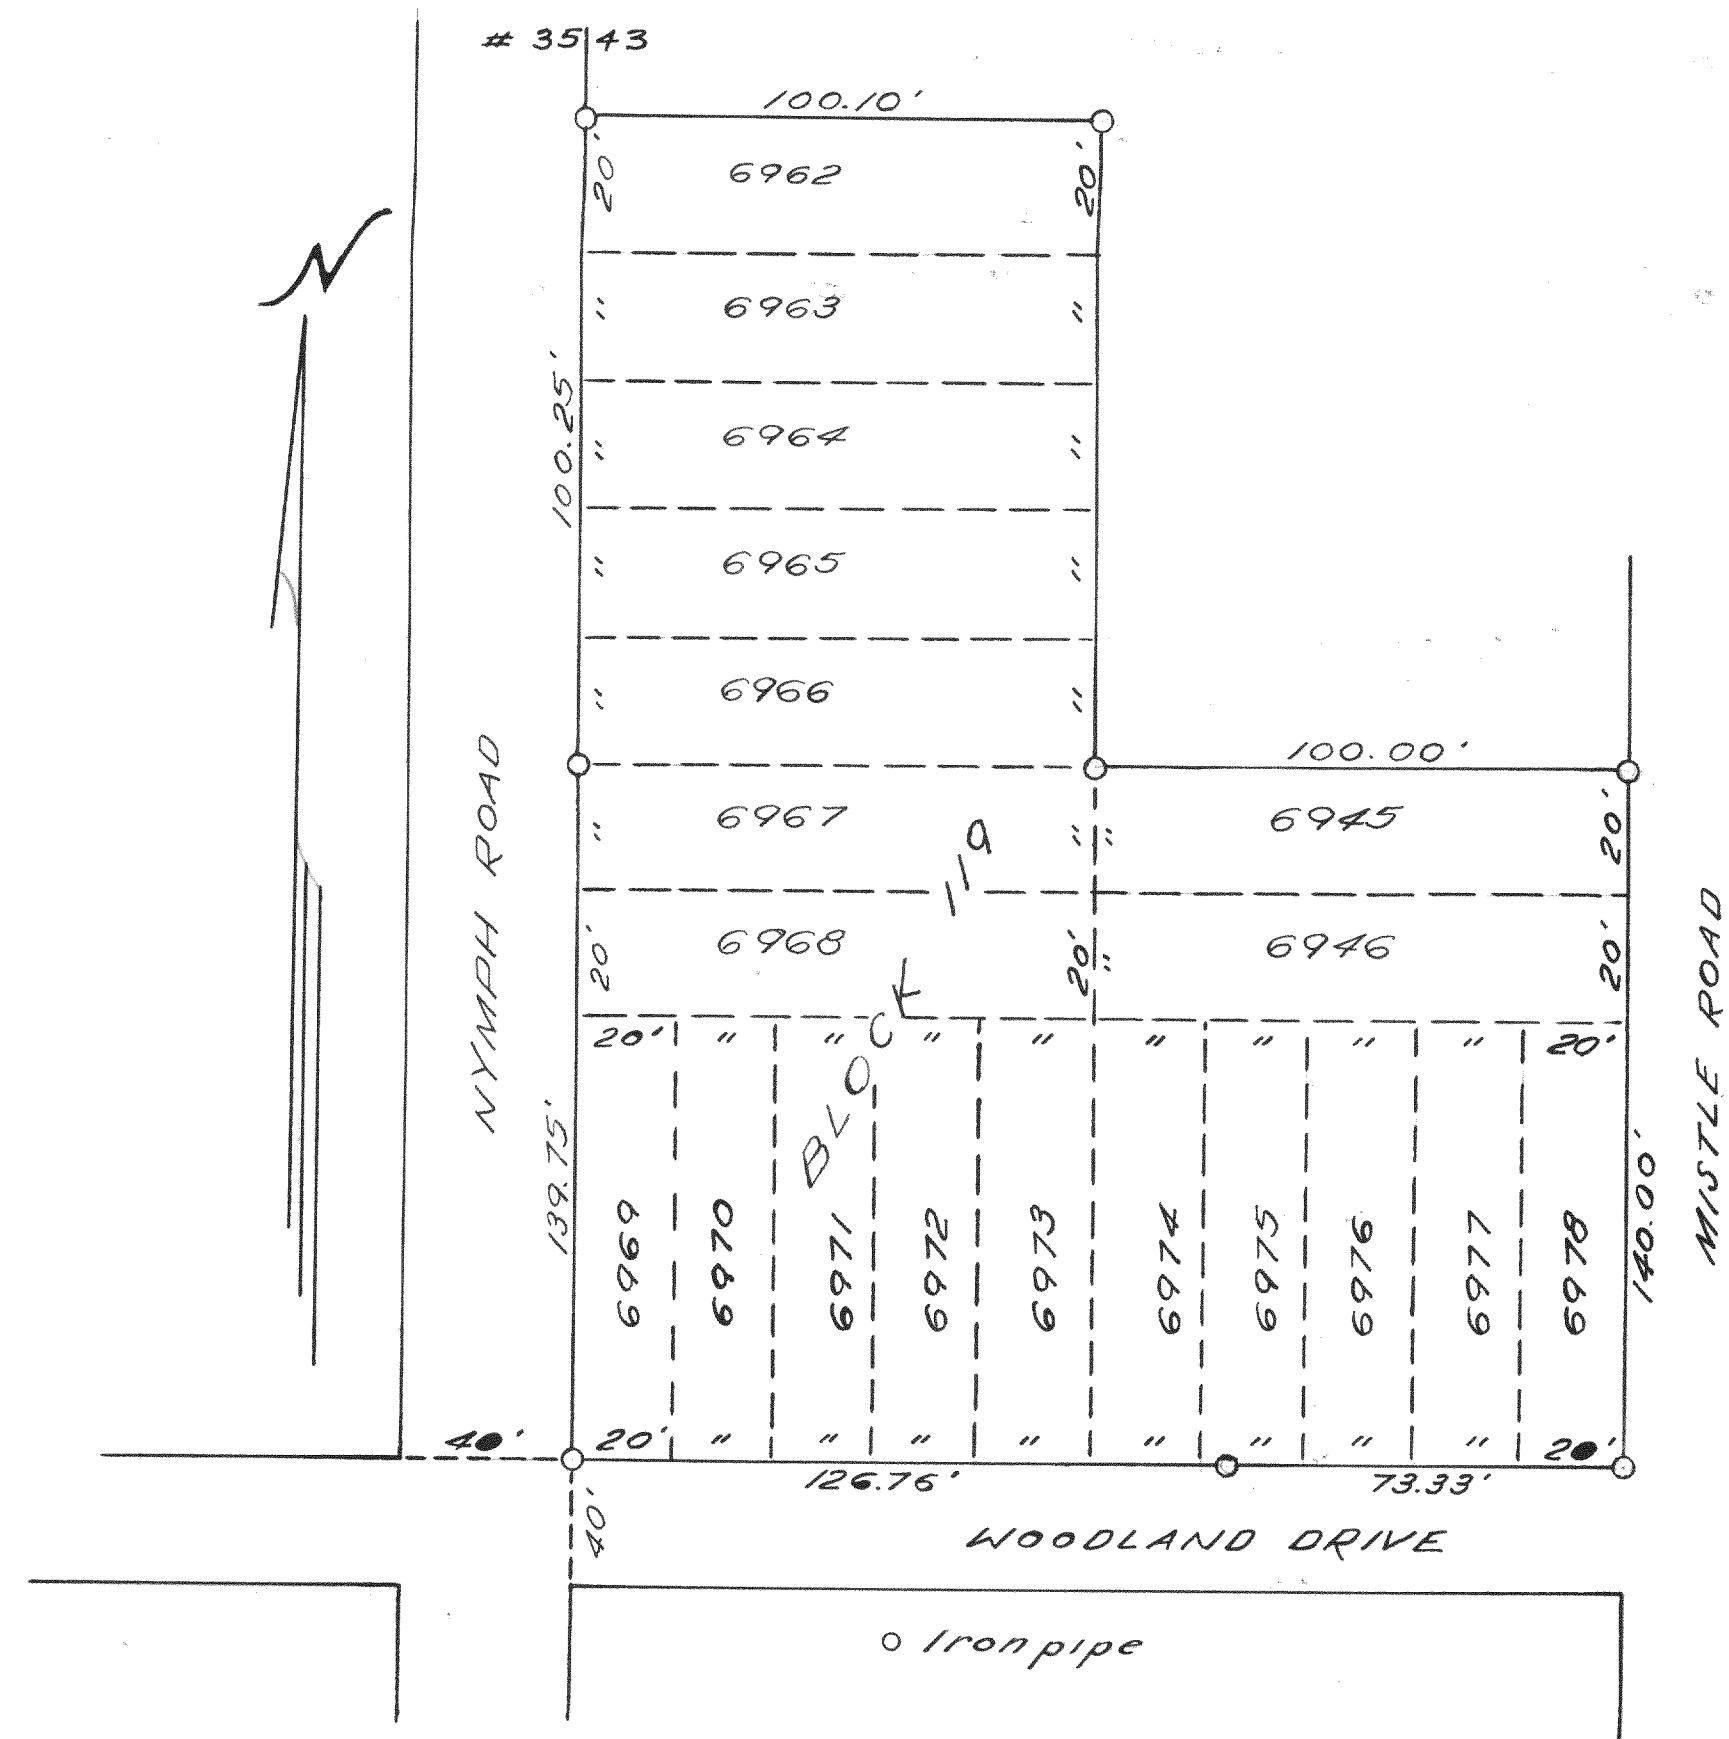

3545

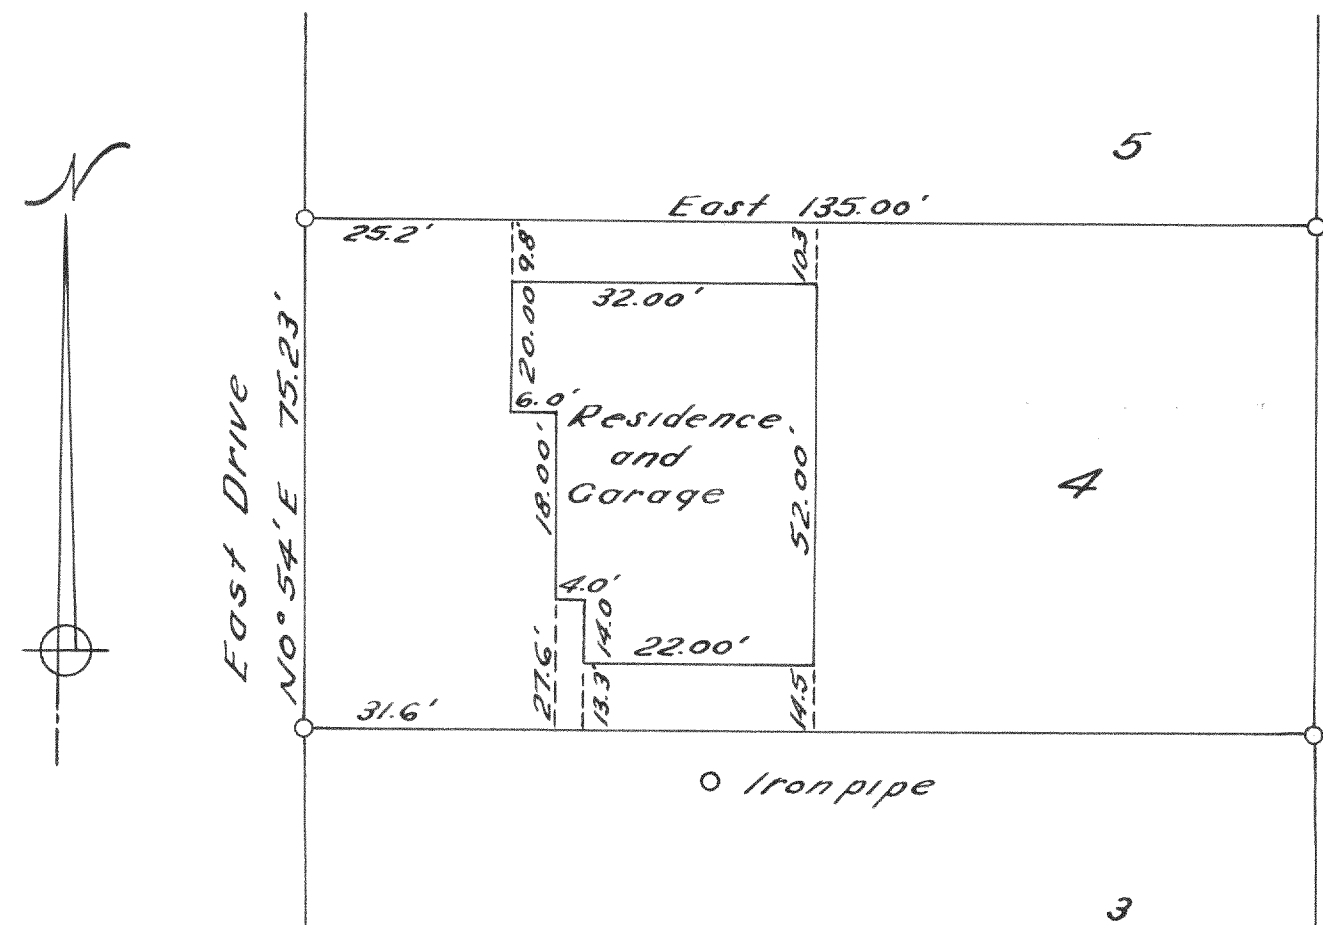

Plat of Survey of lot 4 of Lyndale Subdivision in the Village of East Troy, Walworth County, Wisconsin. Showing house location. August 1958. Lloyd L. Jensen County Surveyor.