




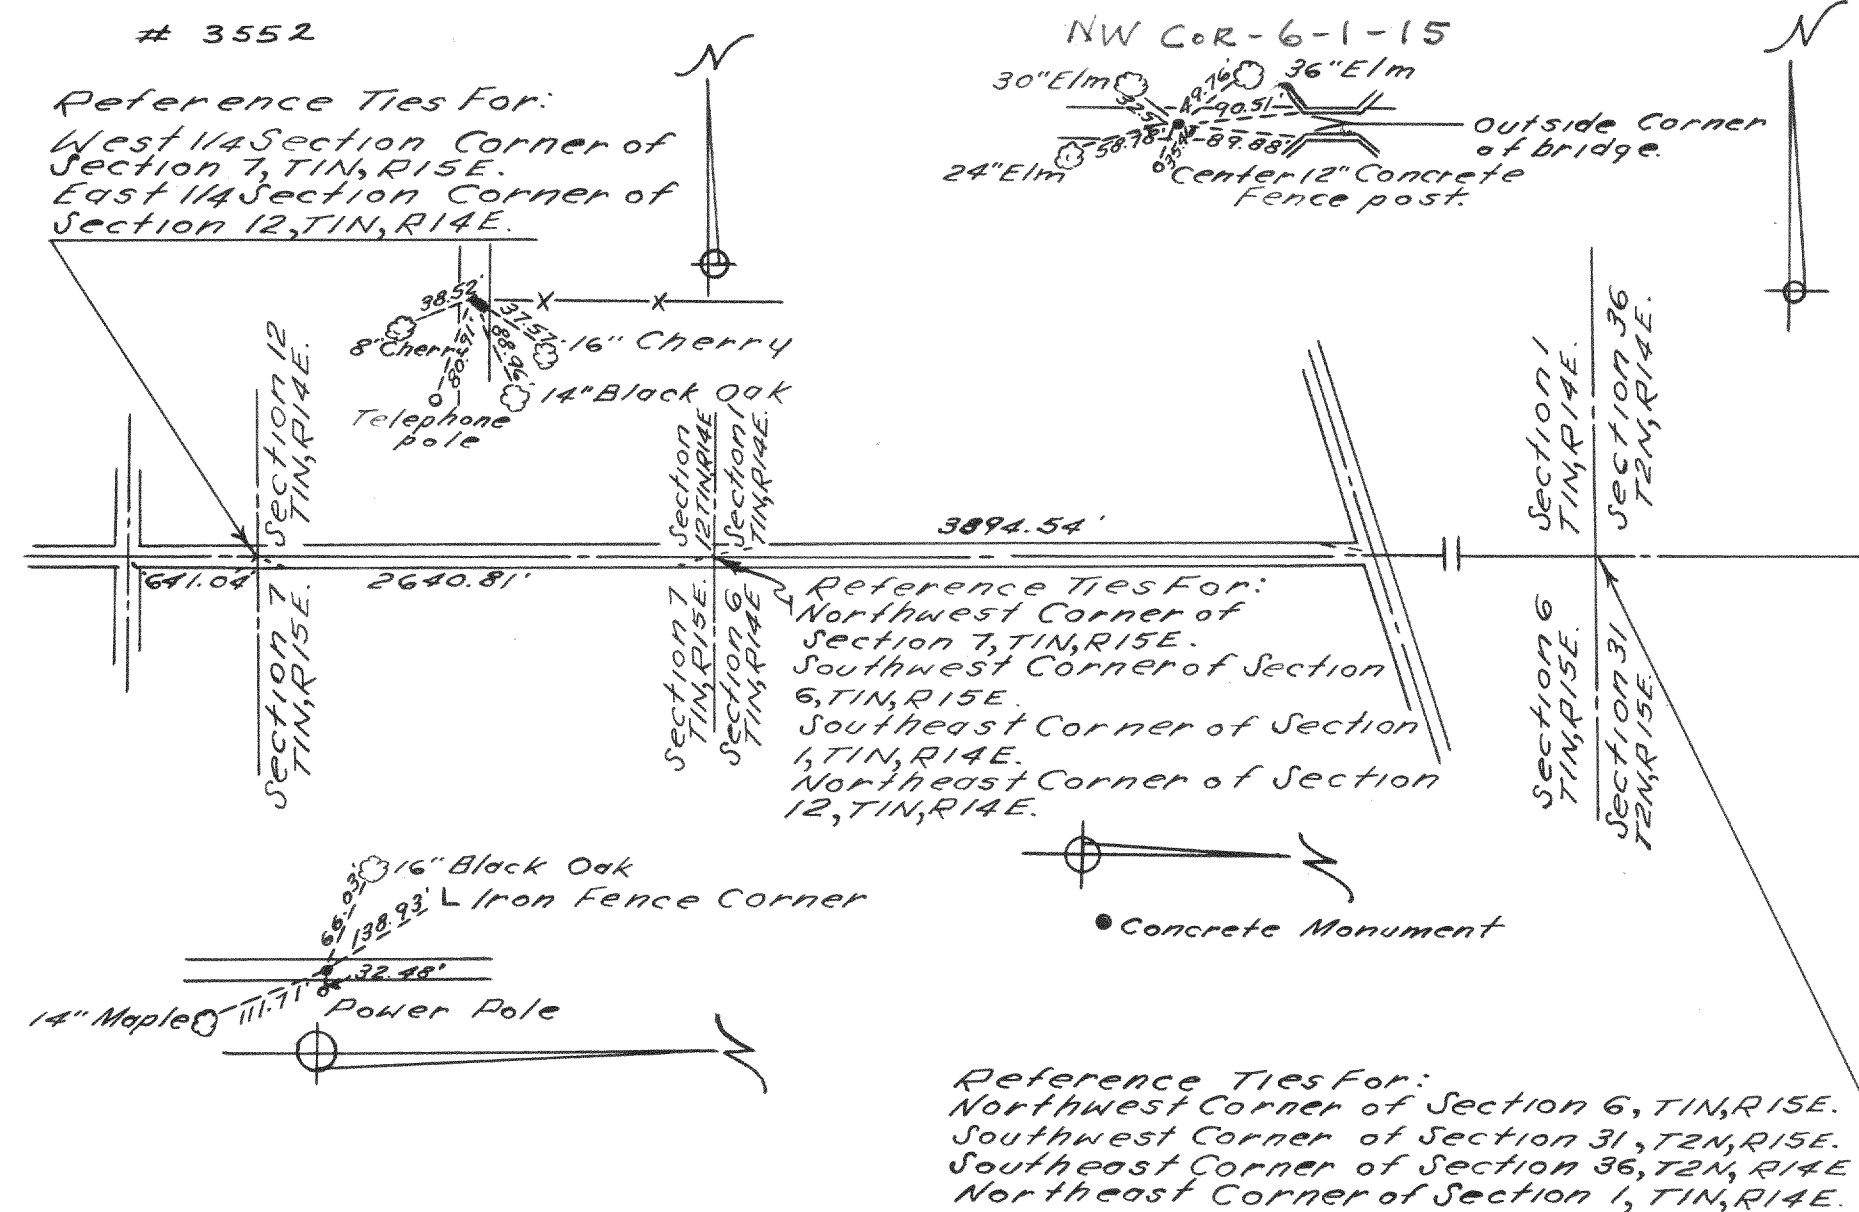

Plat of Survey of:
Sharon Town Road along West
Line of Section 6 and 7, T1N, R15E,
Walworth County, Wisconsin.
May 1958. Lloyd L. Jensen
County Surveyor

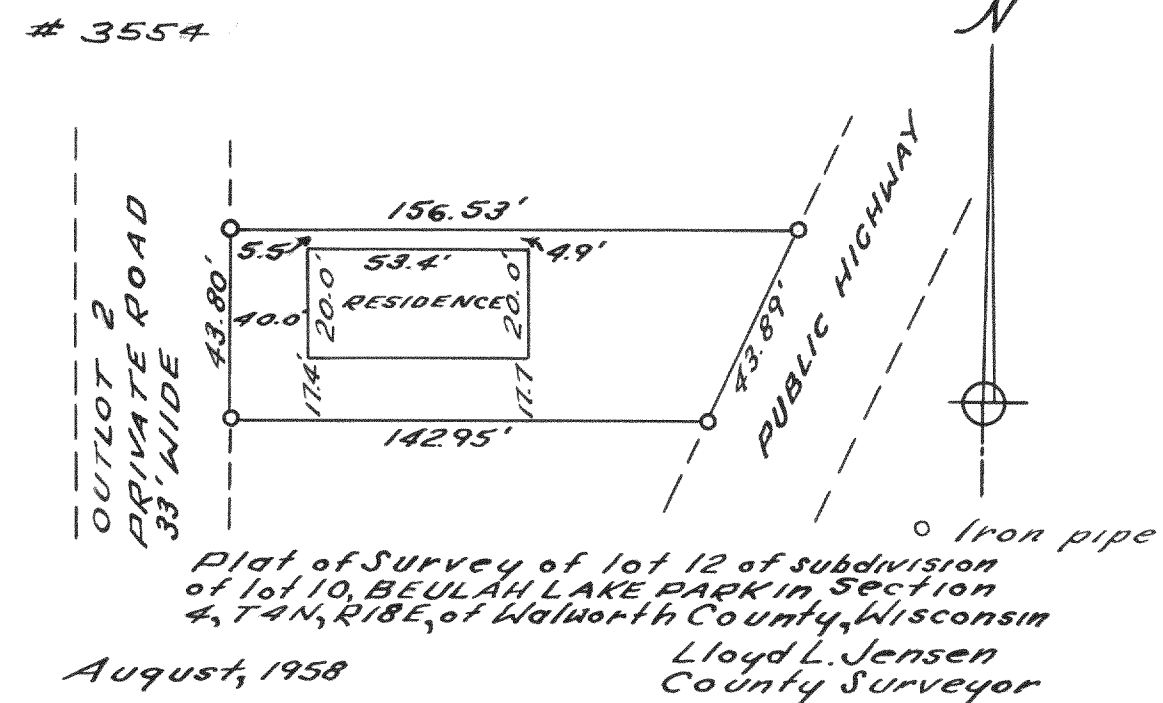

3555

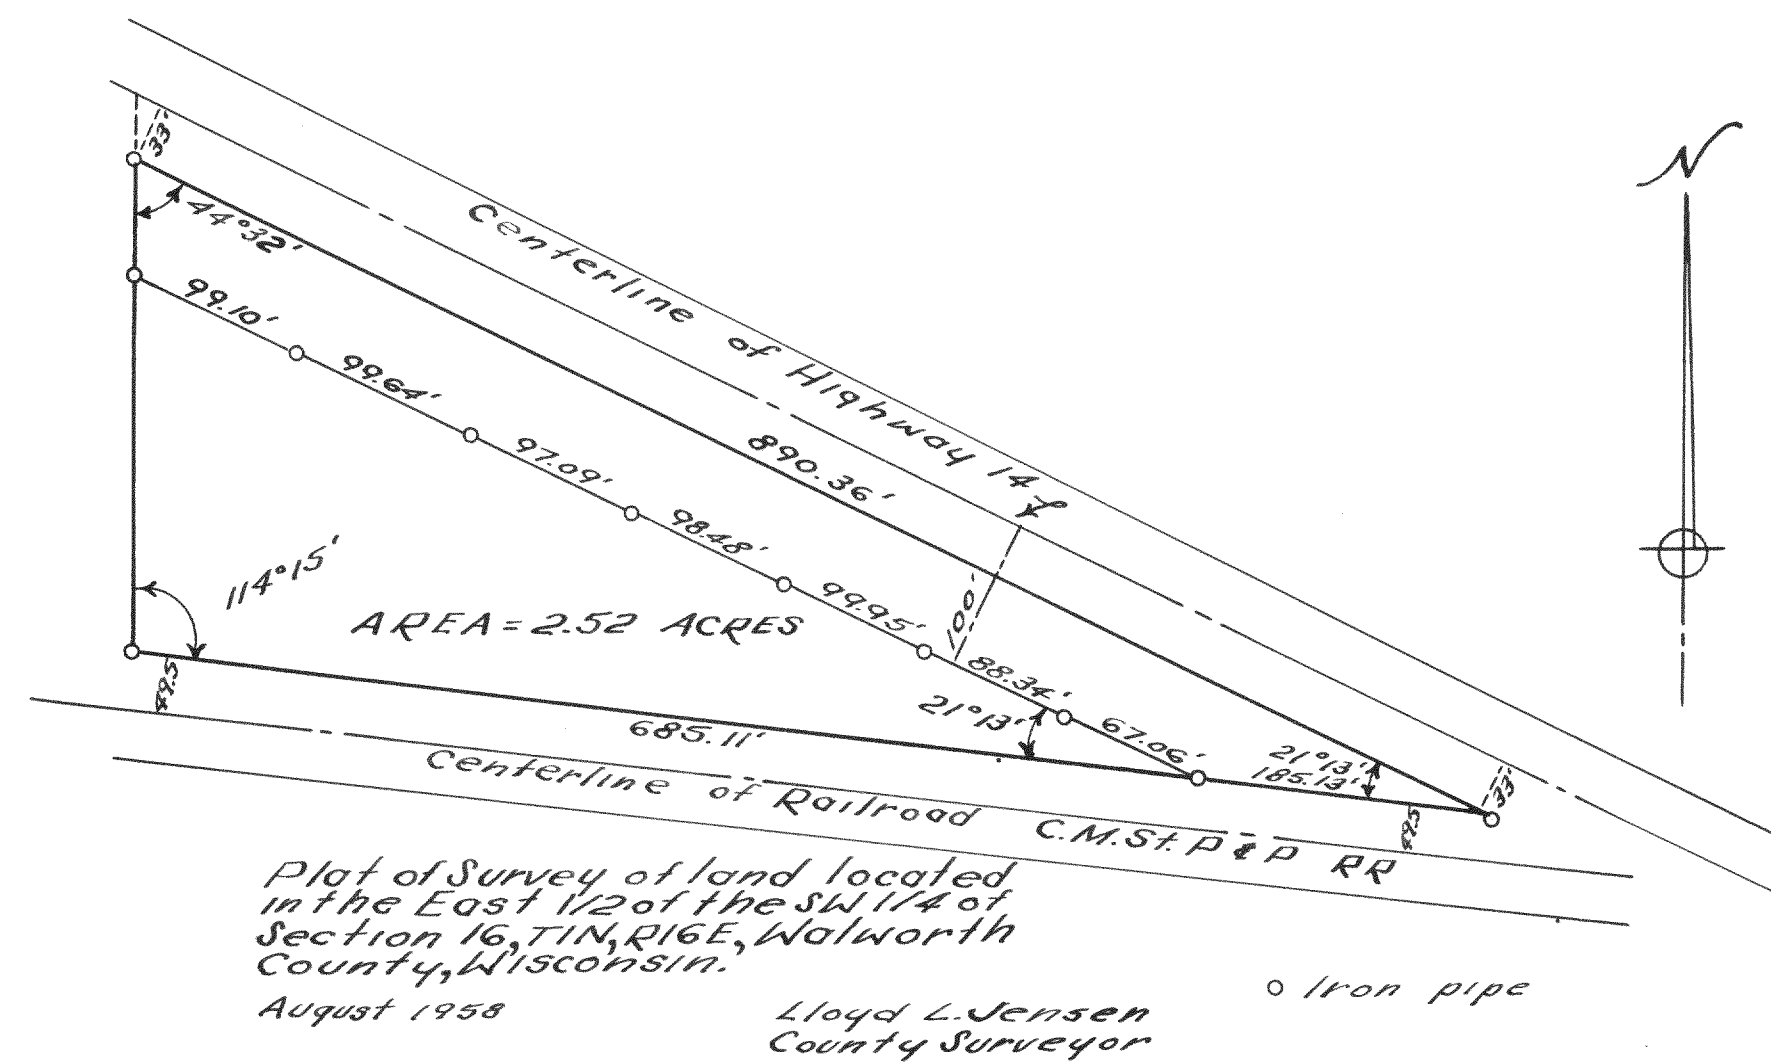

3553

