


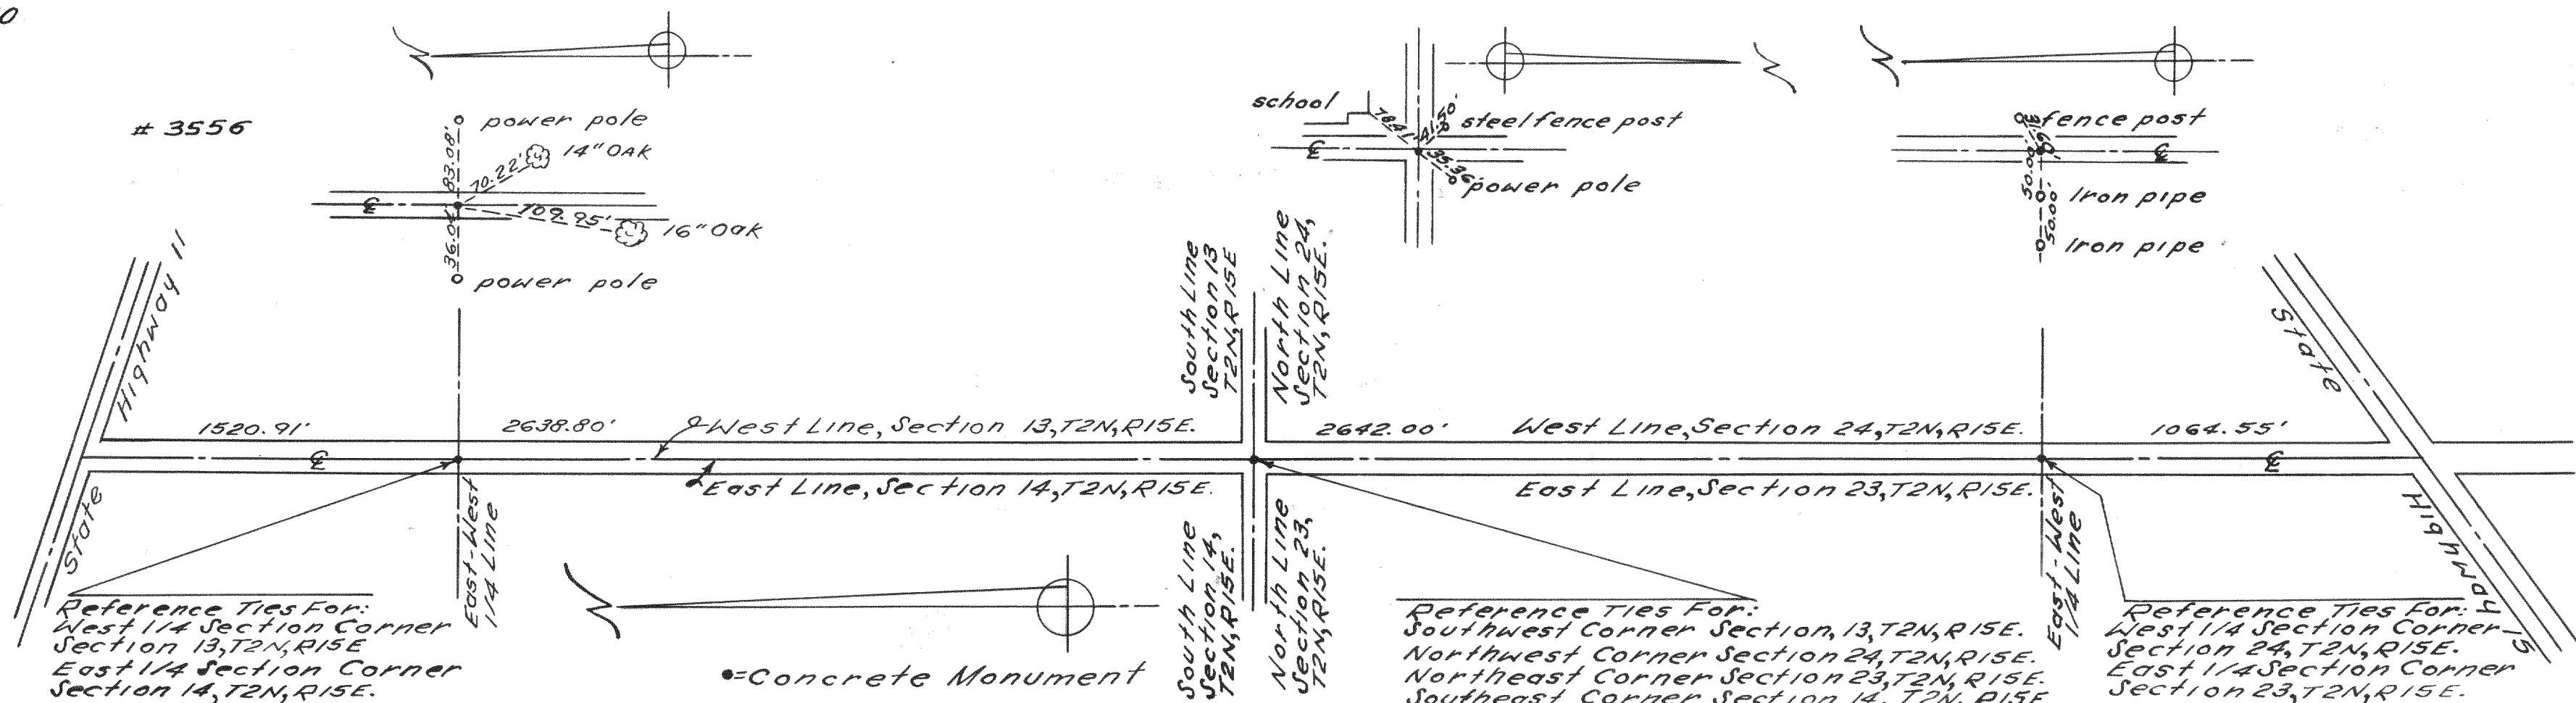

Reference Ties For:
West 1/4 Section Corner
Section 13, T2N, R15E
East 1/4 Section Corner
Section 14, T2N, R15E.


•=Concrete Monument

Reference Ties For:
 Southwest Corner Section 13, T2N, R15E.
 Northwest Corner Section 24, T2N, R15E.
 Northeast Corner Section 23, T2N, R15E.
 Southeast Corner Section 14, T2N, R15E.

Reference Ties For:
West 1/4 Section Corner -
Section 24, T2N, R15E.
East 1/4 Section Corner
Section 23, T2N, R15E.


*Plot of Survey of Darien Town Road
Along West Line of Sections 13
and 24, T2N, R15E, Walworth County,
Wisconsin. April 1957.*

Lloyd L. Jensen.
County Surveyor.

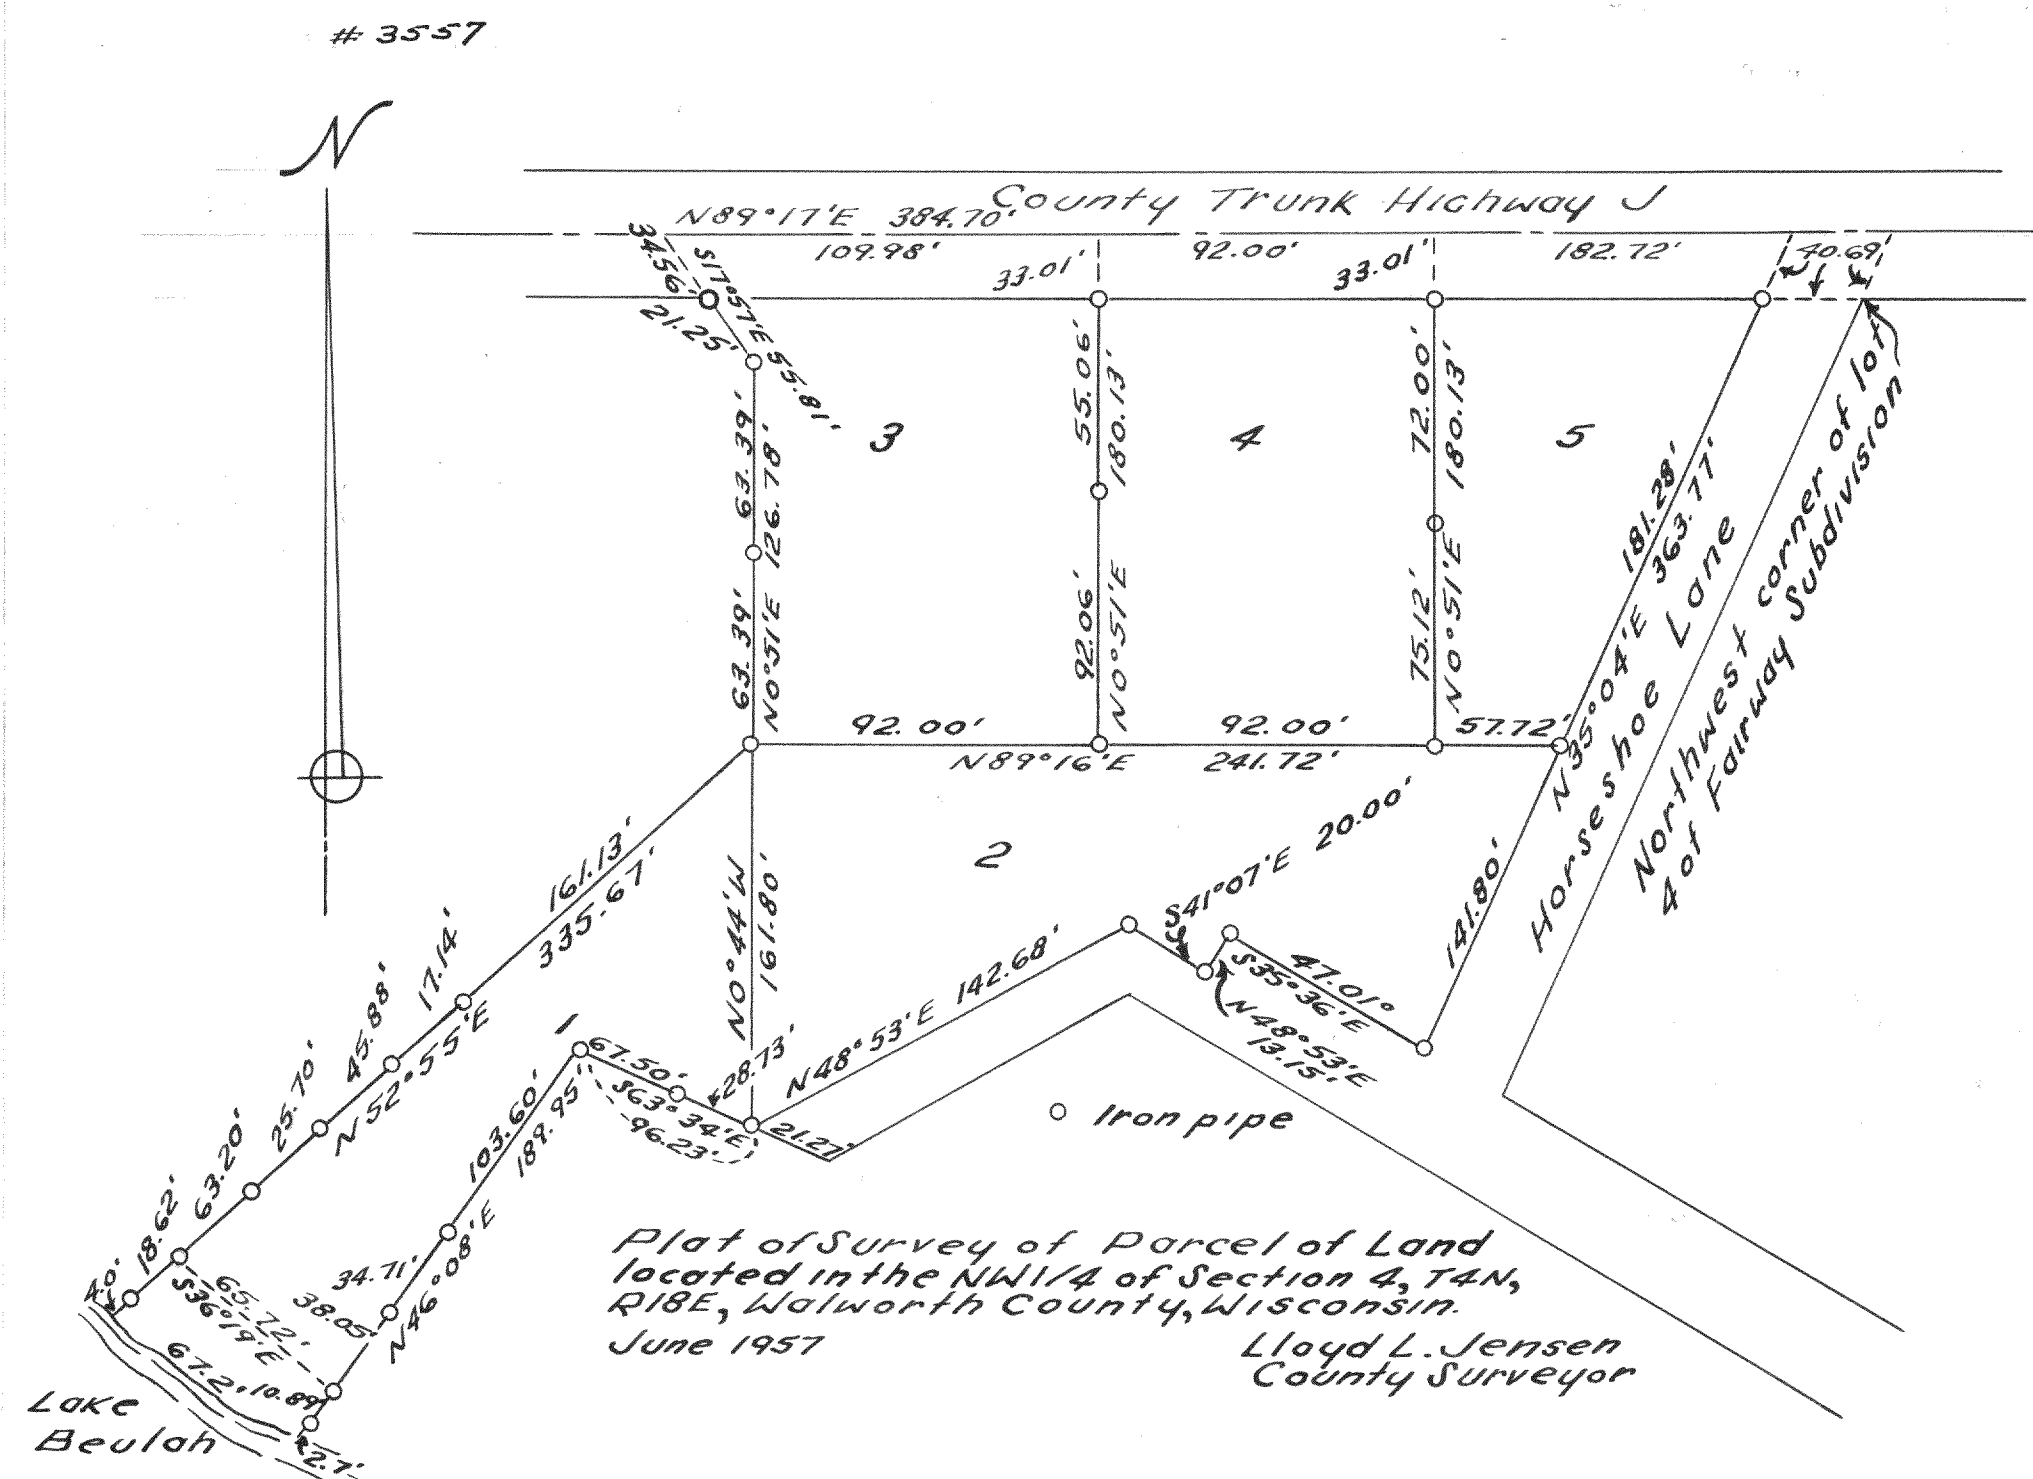

*Plot of Survey of Parcel of Land
located in the NW 1/4 of Section 4, T4N,
R18E, Walworth County, Wisconsin.
June 1957 Lloyd L. Jer*

Lloyd L. Jensen
County Surveyor

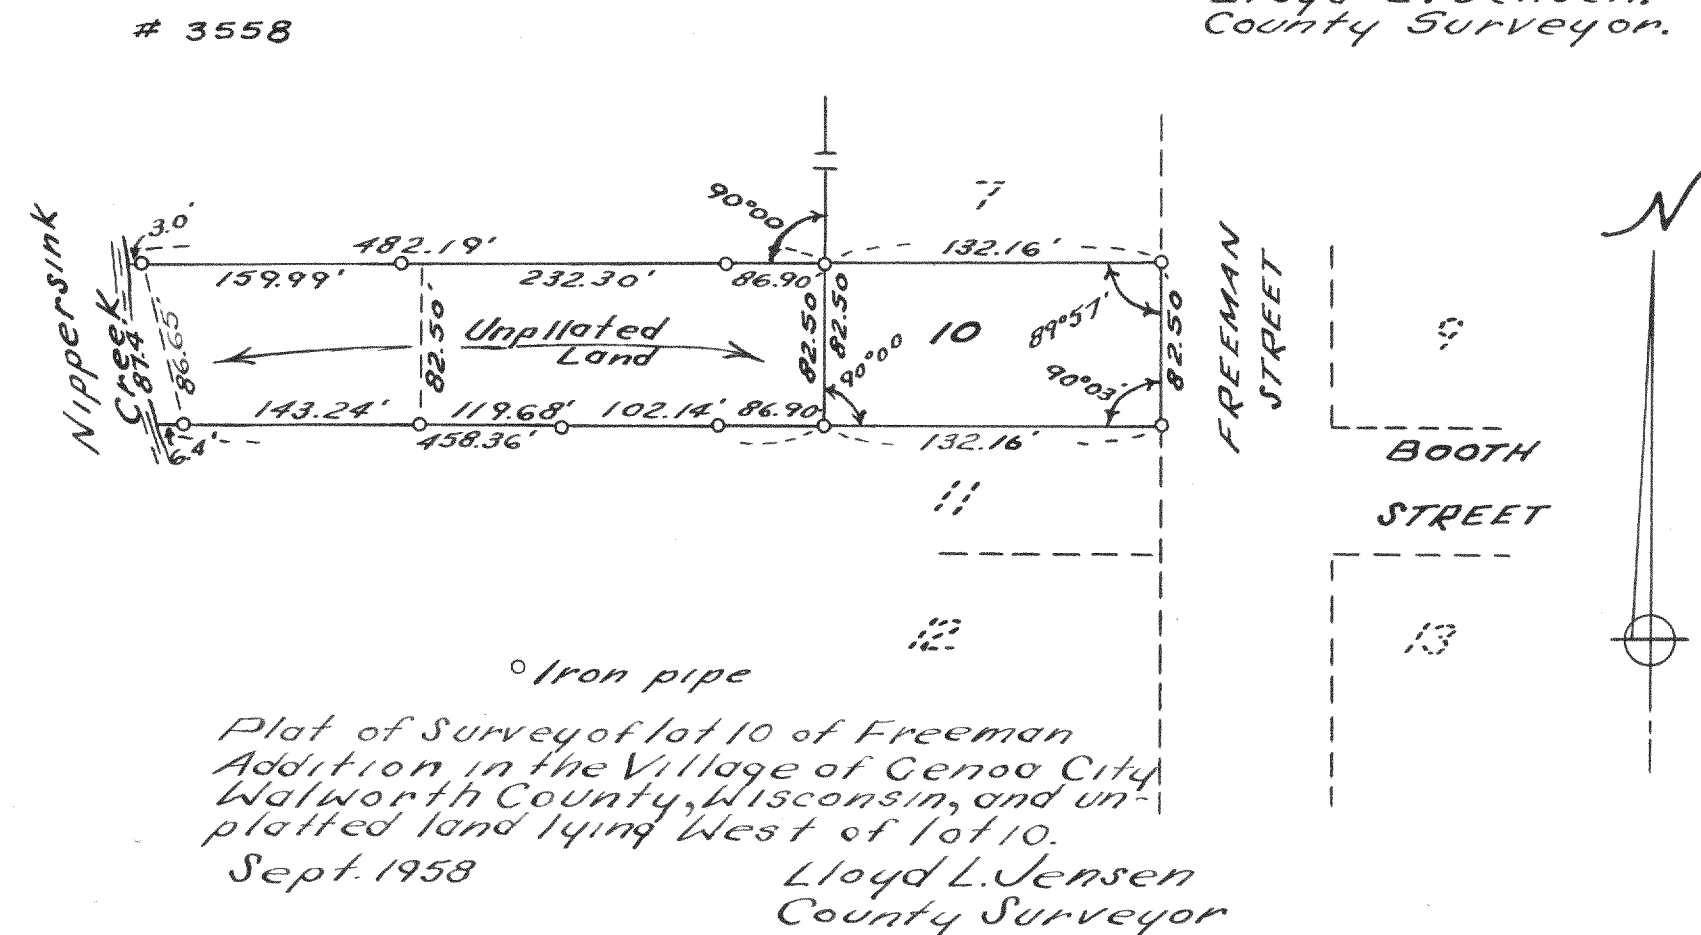

Plot of Survey of lot 10 of Freeman
Addition in the Village of Genoa City
Walworth County, Wisconsin, and un-
platted land lying West of lot 10.

Sept. 1958

Lloyd L. Jensen
County Surveyor