



#3609

Plat of Survey of A Parcel of
Land Located in the NE 1/4 of
Sec. 7, T1N, R18E Walworth
County, Wisconsin
Lloyd L. Jensen
County Surveyor
Nov. 1958

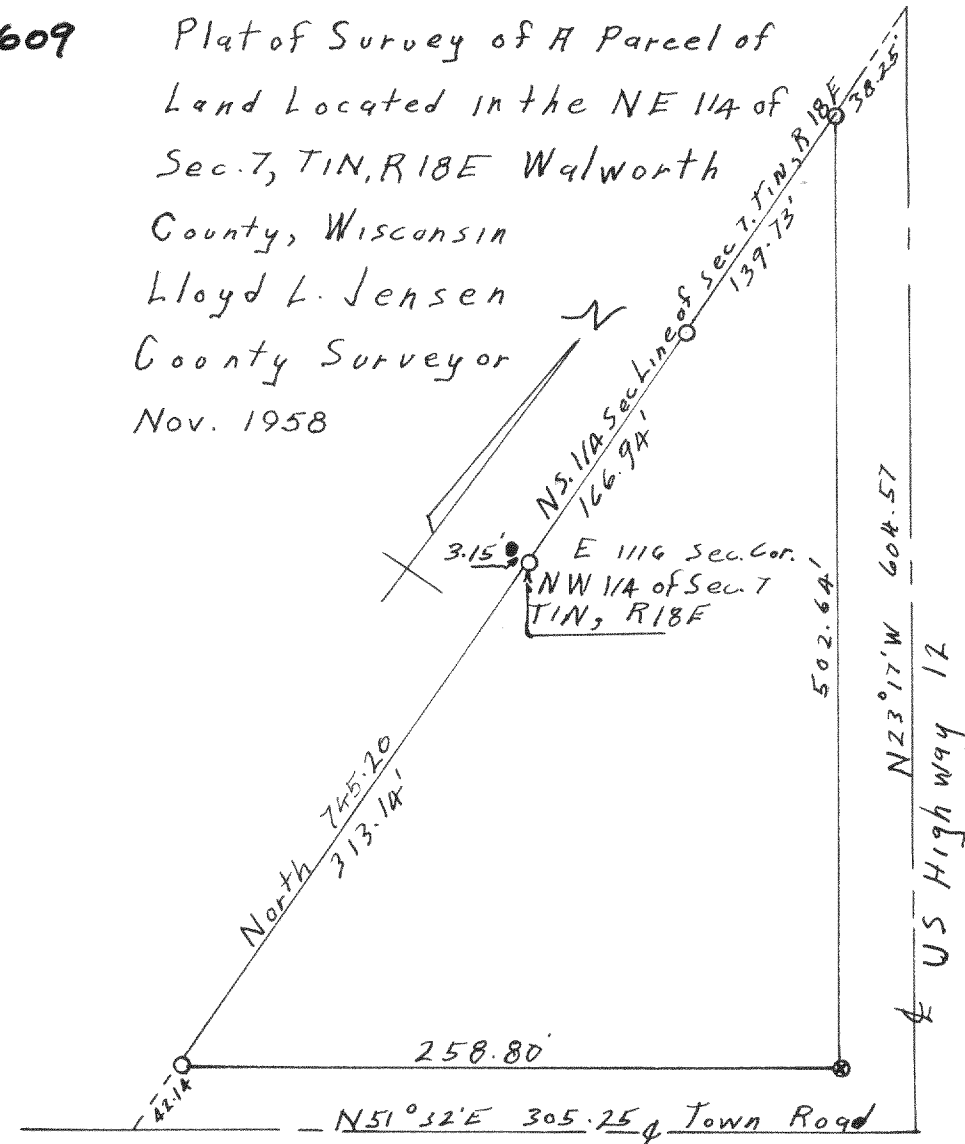


#3610

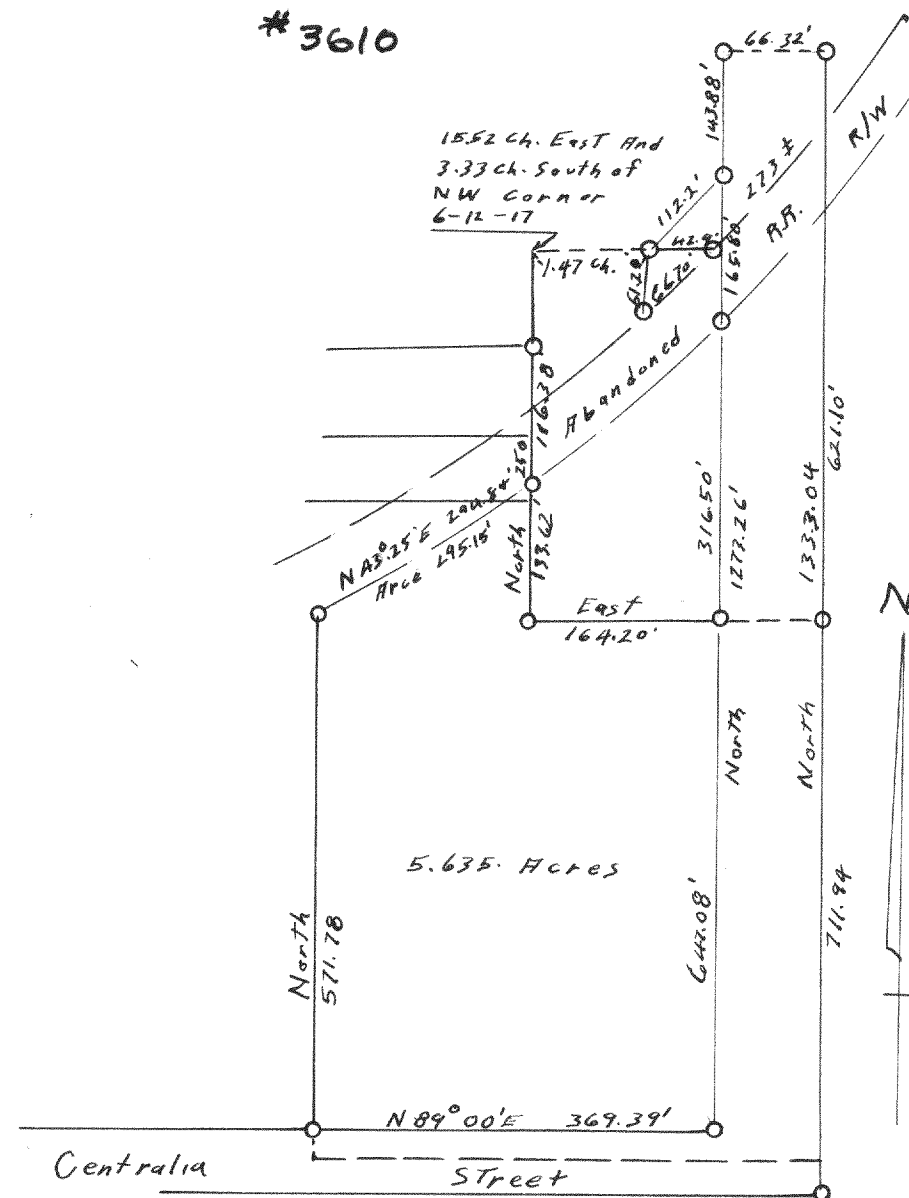

Plat of Survey of Land
in the NW 1/4 of Section
6, T2N, R17E City of
Elkhorn, Walworth
County Wisconsin
Lloyd L. Jensen
Nov. 58 County Surveyor


#3611

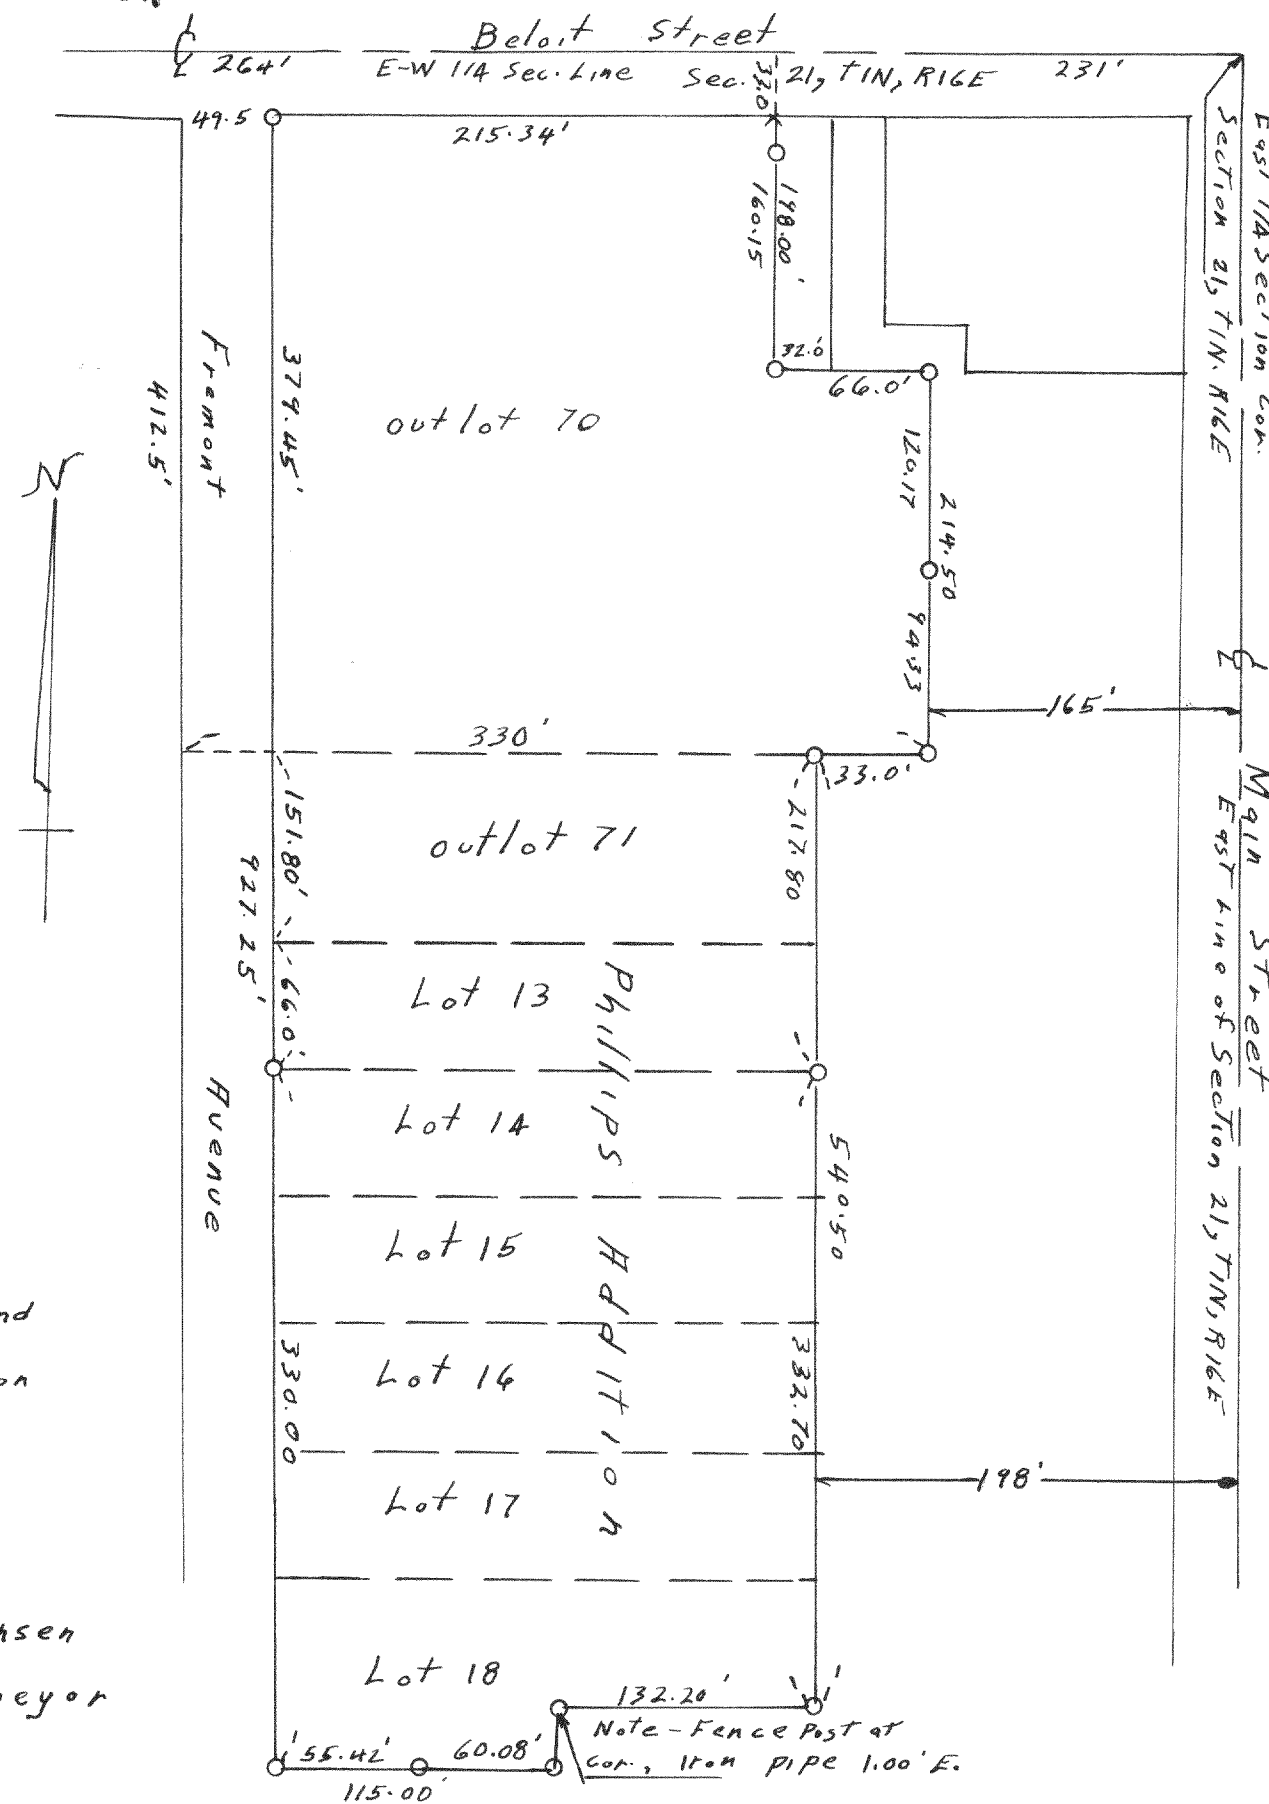

Plat of Survey of outlots 70 and
71 and Lots 13 to 18 Phillips Addition
Village of Walworth, Walworth
County, Wisconsin
Lloyd L. Jensen
Jan 59 County Surveyor

#3612

221

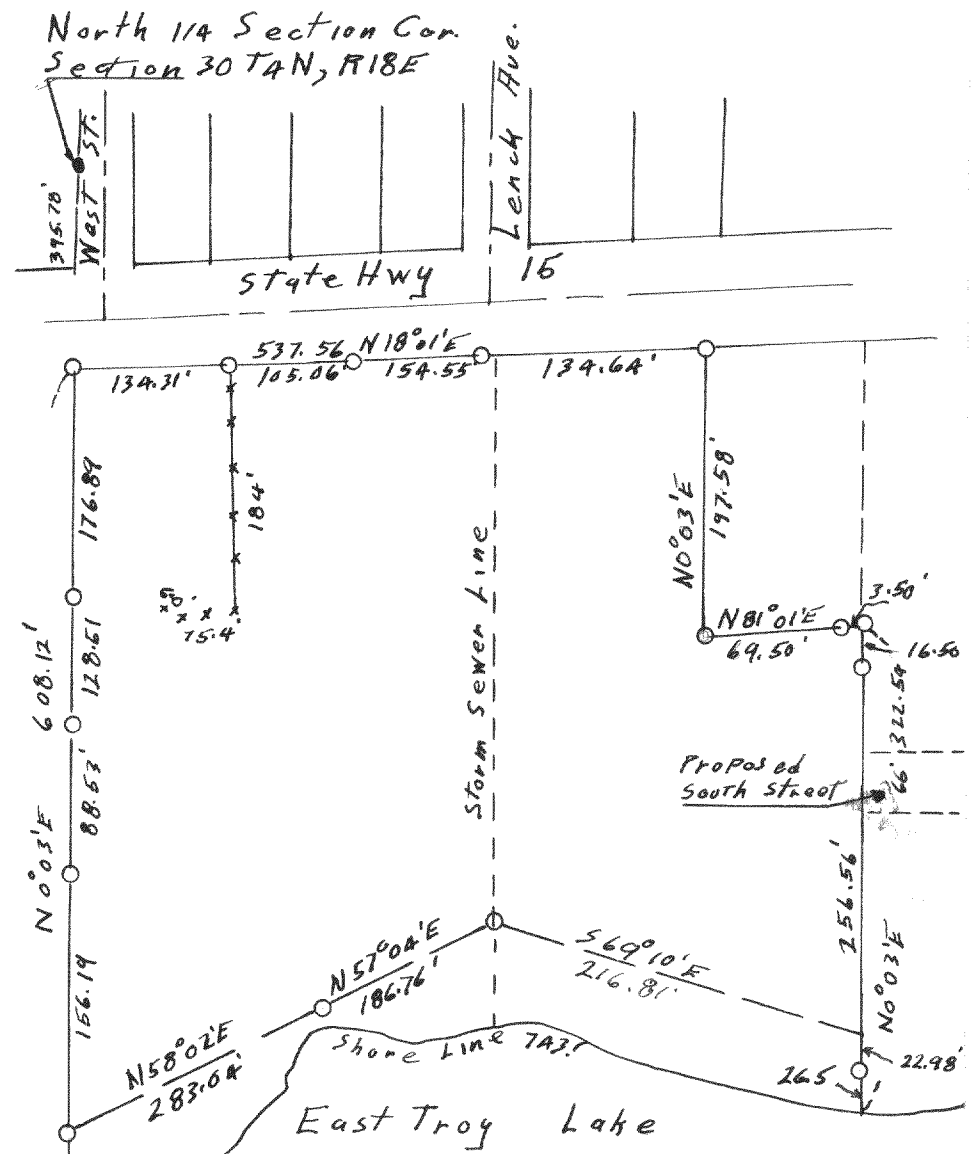

Plat of Survey of A Parcel
of Land Located in the NW 1/4 of
the NE 1/4 of Section 30 T4N-
R18E Village of East Troy
Walworth County Wisconsin
June 58 Lloyd L. Jensen
County Surveyor