




227
#3629

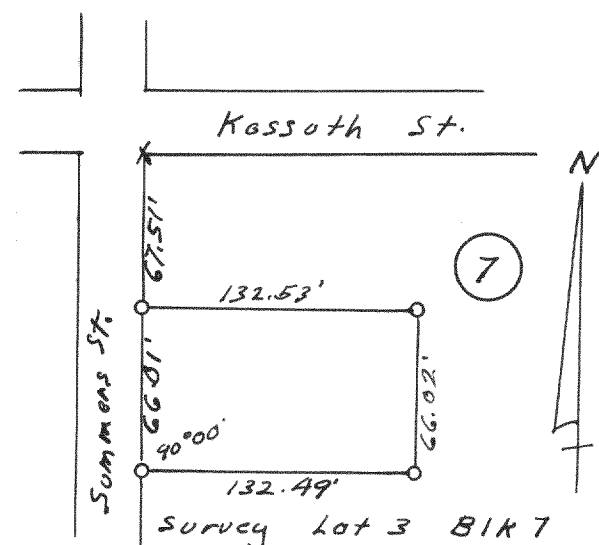

Survey Lot 3 Blk 7
Freeman's 2nd Add to
Genoa City,
the Village of Walworth
#3630 (8-22-58) Lloyd L. Jensen
County Surveyor

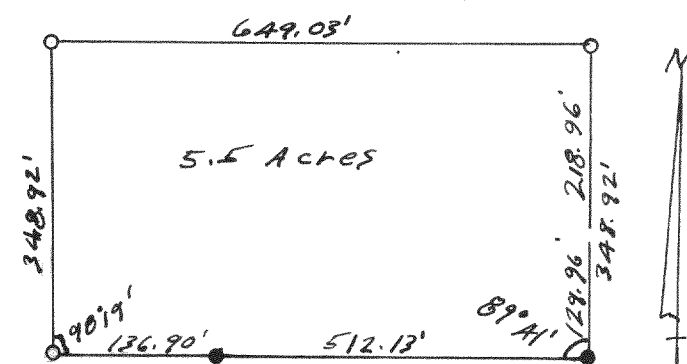


Survey in NE 1/4 NE 1/4 of Section 1
City of Lake Geneva Lloyd L. Jensen
County Surveyor
July 1957

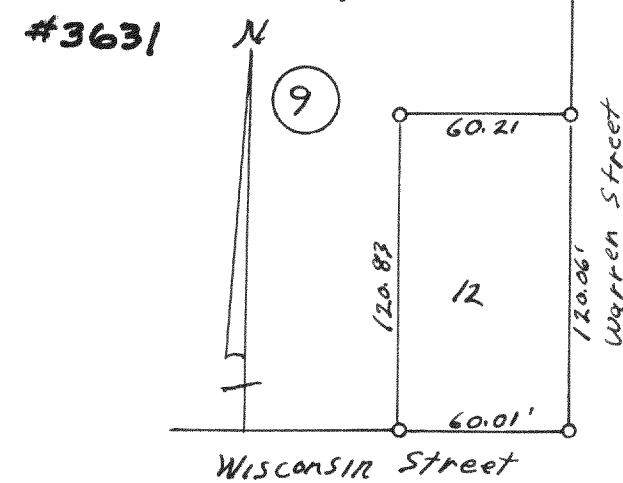


Survey of South 120' of Lot
12, Blk 9, Orig. Plat of
the City of Lake Geneva
June 1958 Lloyd L. Jensen
County Surveyor

#3632

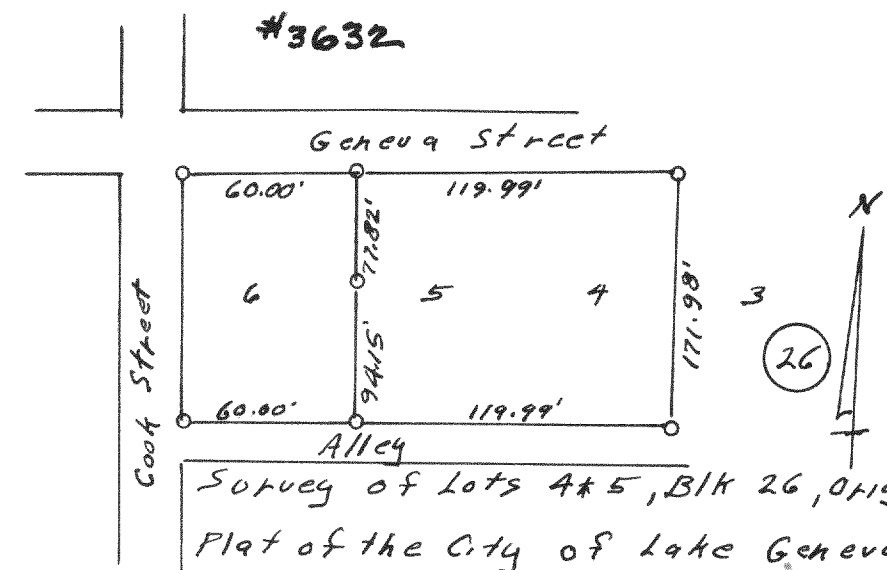


Survey of Lots 4 & 5, Blk 26, Orig.
Plat of the City of Lake Geneva
Aug. 1958 Lloyd L. Jensen
County Surveyor

#3633

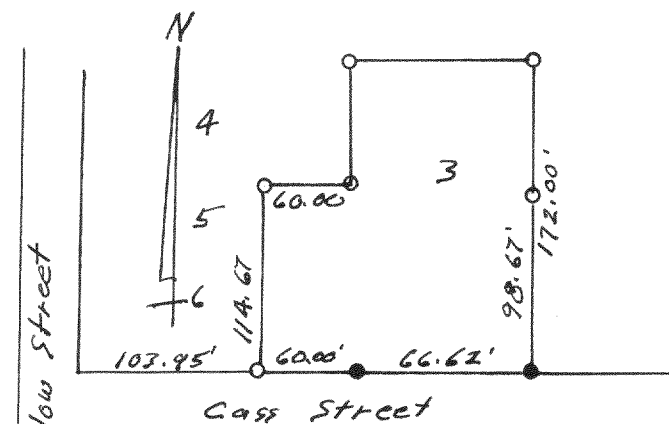


Survey of Lot 3 and the East
60' of Lots 5 and 6 Newberry's
Subd. City of Lake Geneva
Oct 20, 1958 Lloyd L. Jensen
County Surveyor

#3634

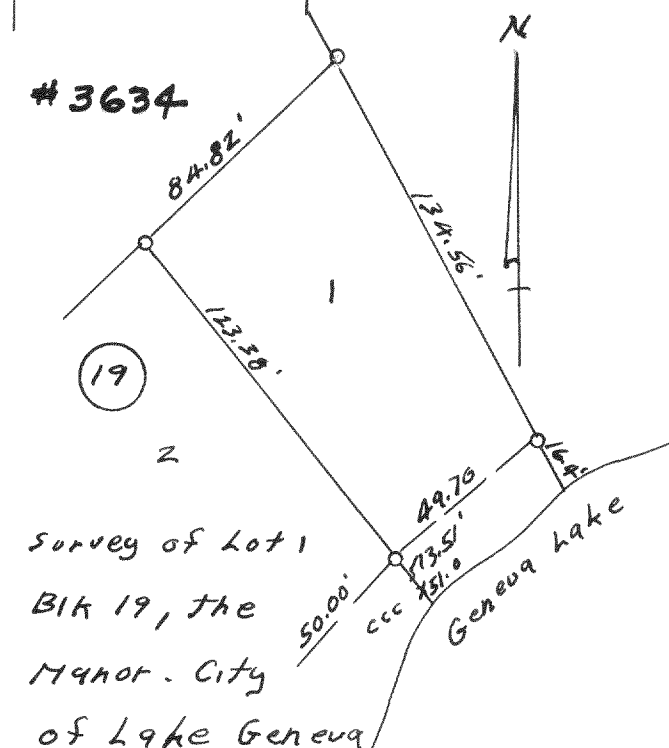


Survey of Lot 1
Blk 19, the
Mayor City
of Lake Geneva
Oct 1958 Lloyd L. Jensen
County Surveyor

#3635

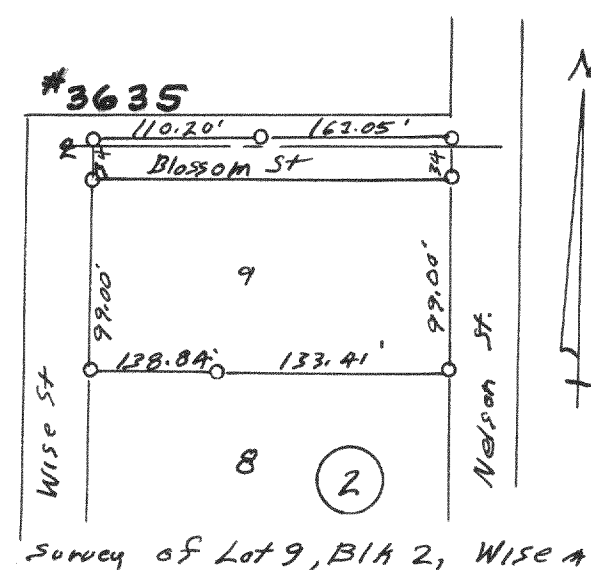


Survey of Lot 9, Blk 2, Wise &
Nelsons Add to the Village
of Sharon Lloyd L. Jensen
May 1957 County Surveyor

#3636

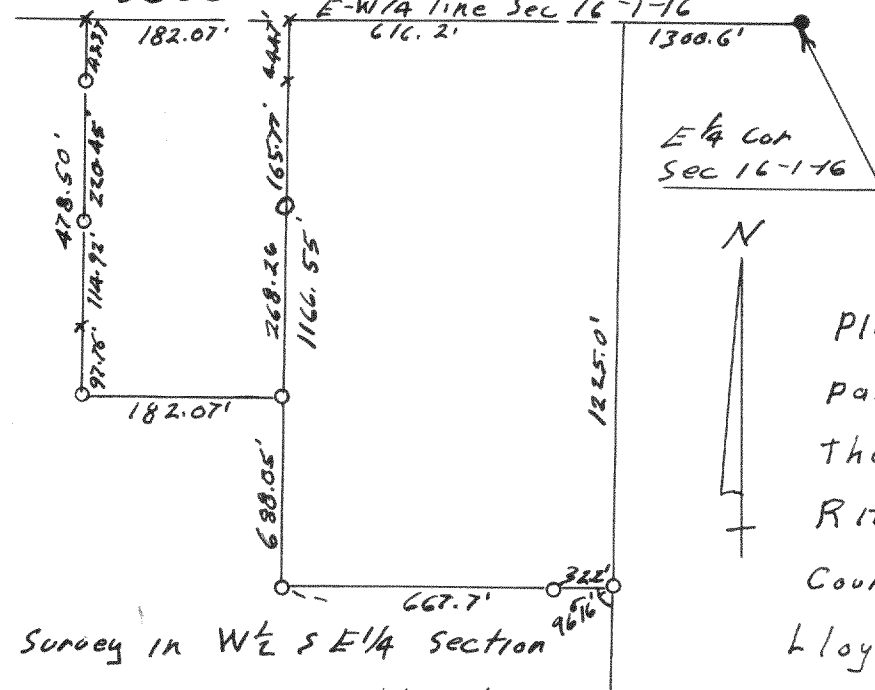


Survey in W 1/2 S E 1/4 Section
16, T1N, R16E Lloyd L. Jensen
1958 County Surveyor

#3637

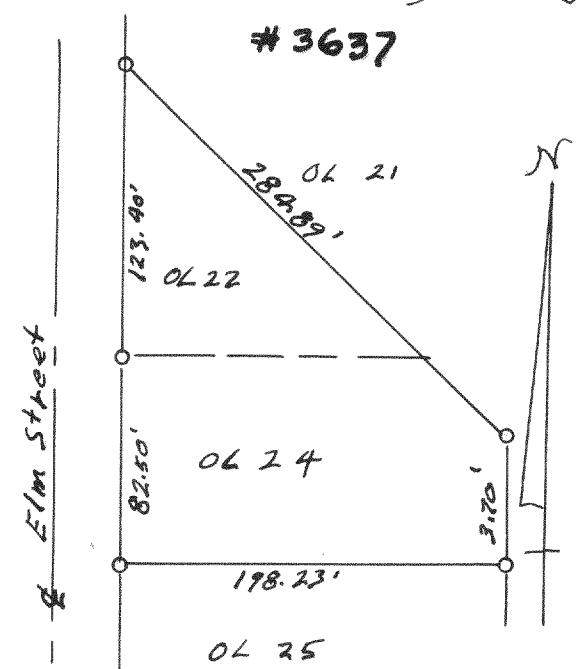

Survey of Outlots 22 & 24
Village of Walworth
Sept 1958 Lloyd L. Jensen
County Surveyor

#3638

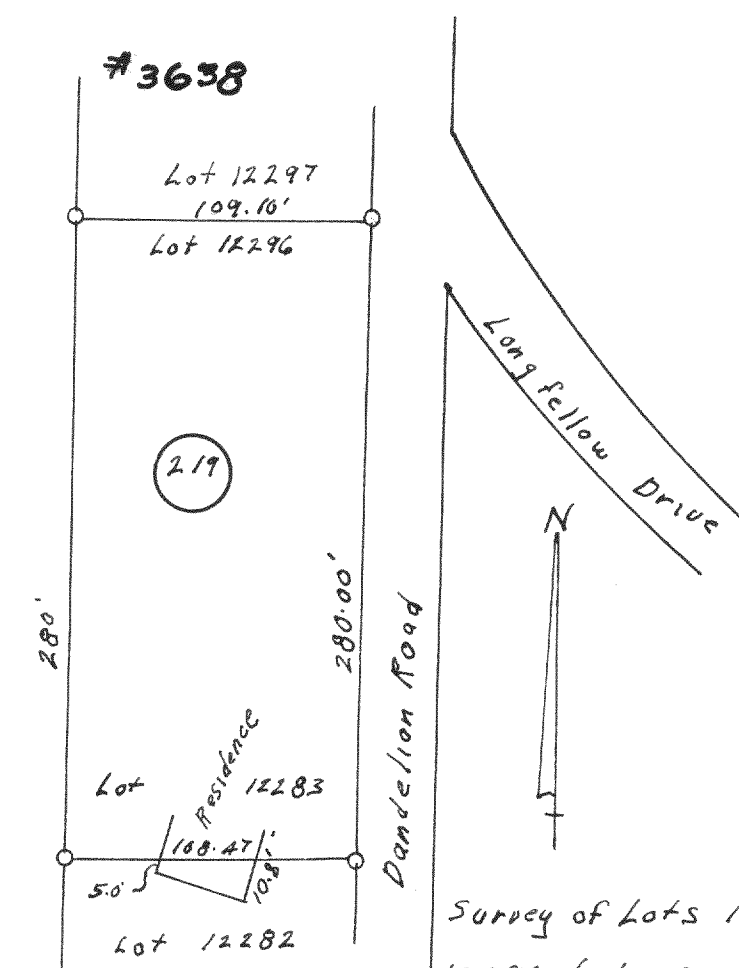

Survey of Lots 12283 -
12296 Lake Como Beach
T2N, R17E, Walworth County, Wisconsin
#3639 Oct 1958 Lloyd L. Jensen
County Surveyor

