


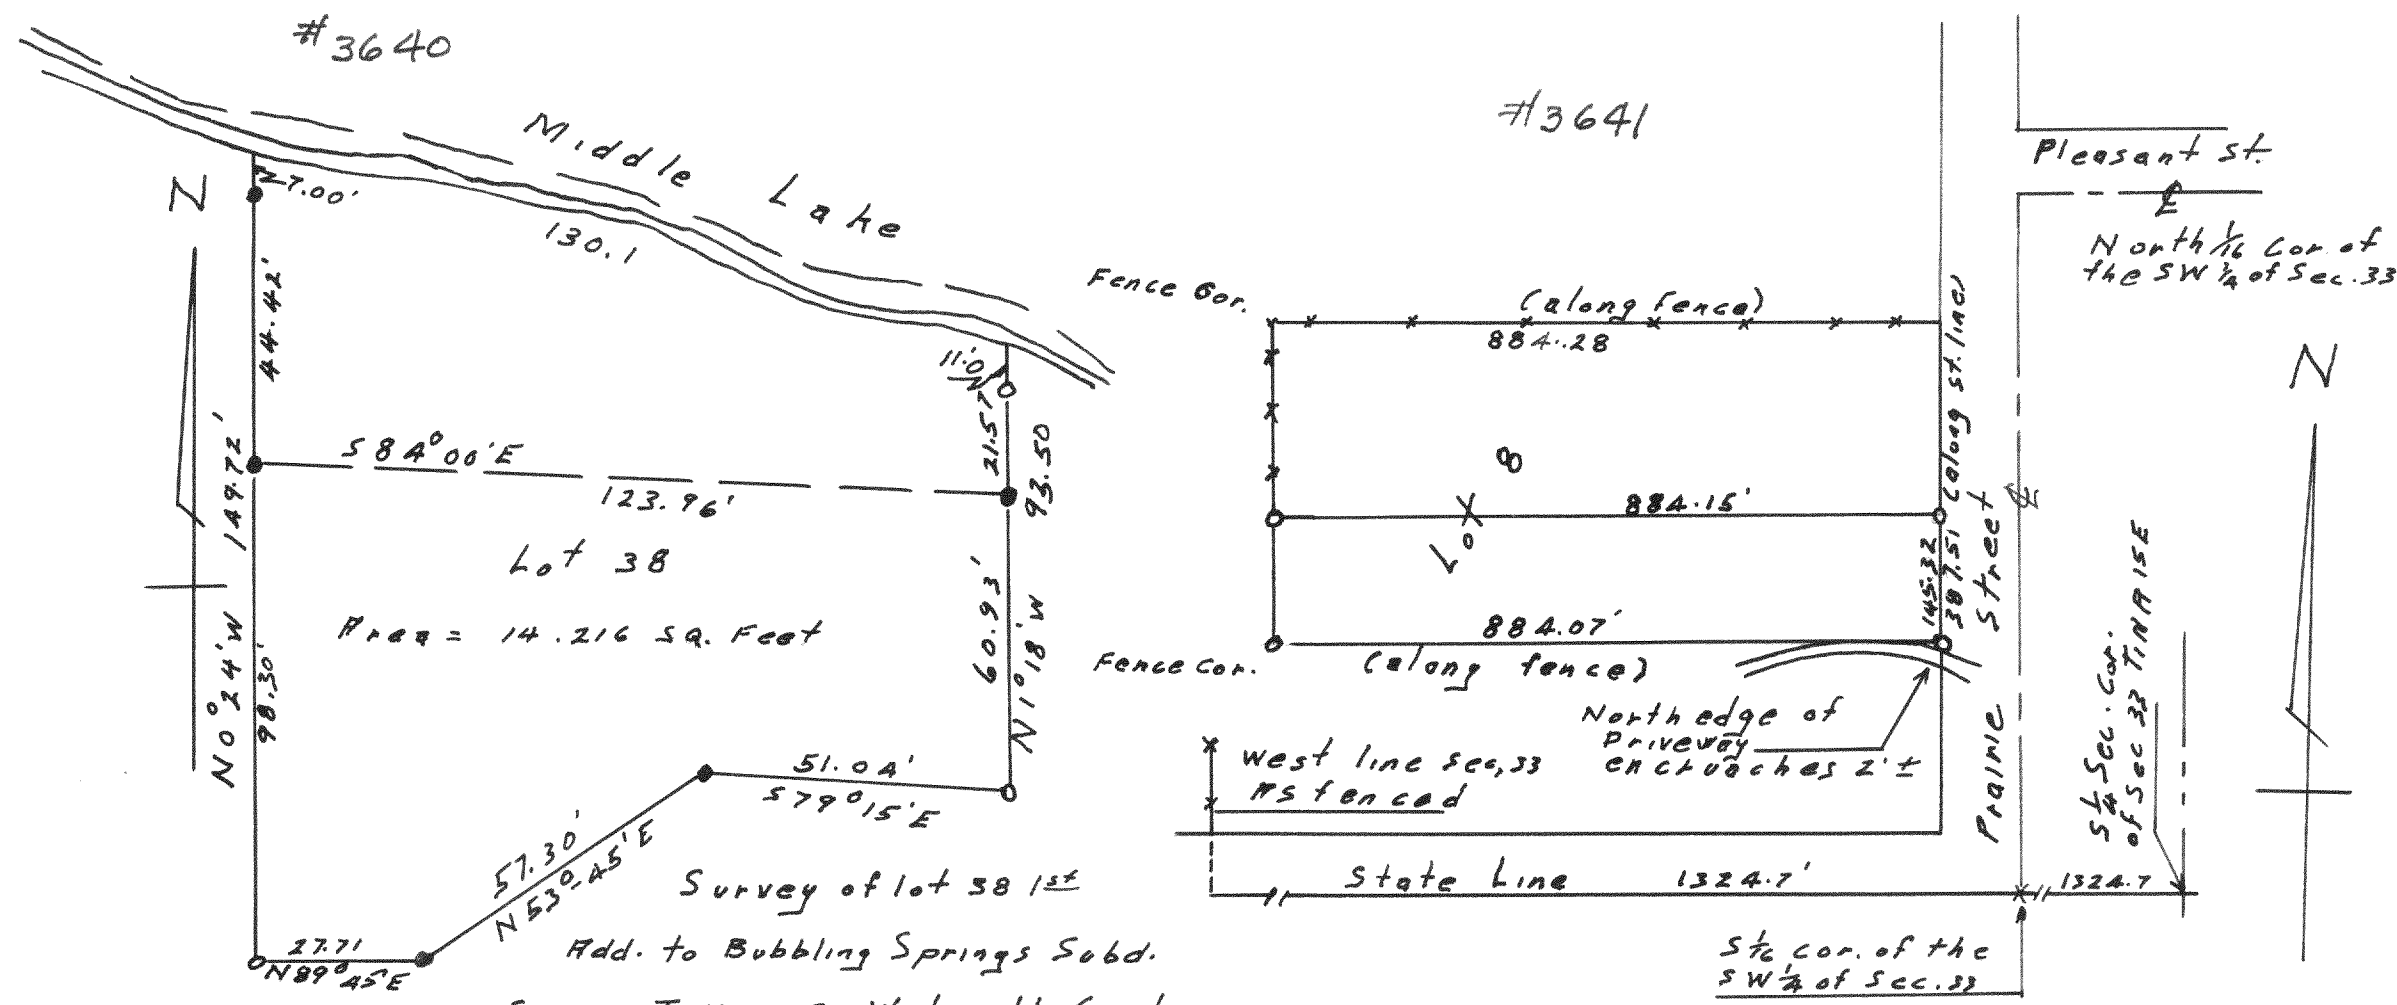

Survey of lot 38 1st  
Add. to Bubbling Springs Subd.  
Sec. 35, T4N R15E Walworth County  
Wisconsin July 1961

Lloyd S. Jensen  
County Surveyor

The south 1/2 of lot 8 block 10 of Citizens  
Add. to Sharon Wisconsin, Walworth  
County Wisconsin Sept. 1961

Lloyd S. Jensen  
County Surveyor


A parcel of land located in  
Government lot 1, the fractional NE  
1/4 of the SE 1/4 of Sec. 32, T4N R15E  
Walworth County Wisconsin  
Sept. 1961

Lloyd S. Jensen  
County Surveyor

North line Sec. 5, T4N R15E  
NE cor. of the NW 1/4 of  
the NE 1/4 of Sec. 5, T4N R15E

#3643  
Plat of proposed land to be vacated,  
located in the NW 1/4 of the NE 1/4 of  
Section 5, T4N R15E City of Whitewater  
Walworth County Wisconsin

Lloyd S. Jensen  
County Surveyor

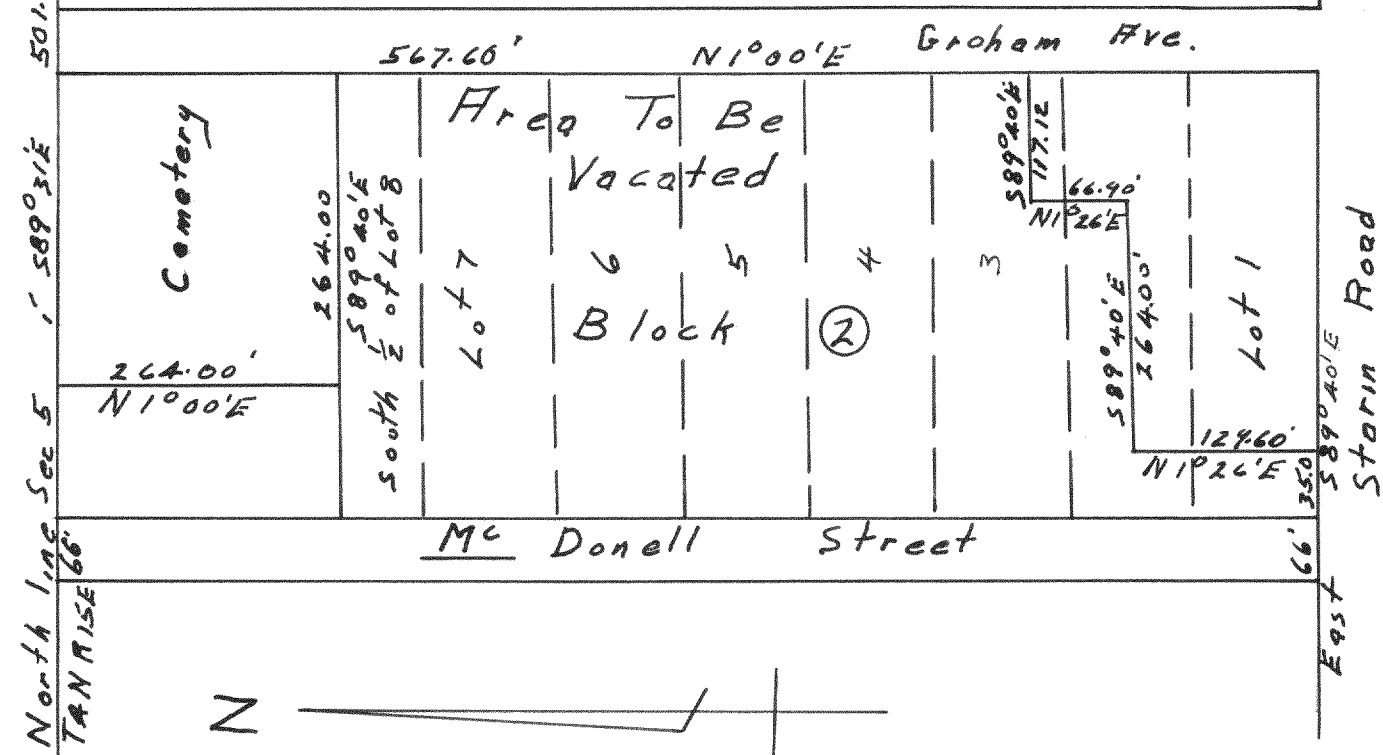

#3644

Survey of unrecorded Subd. in  
the SW 1/4 Sec. 21, T4N R15E  
Kenosha County Wisconsin June 1961

Lloyd S. Jensen  
County Surveyor

