



#3687

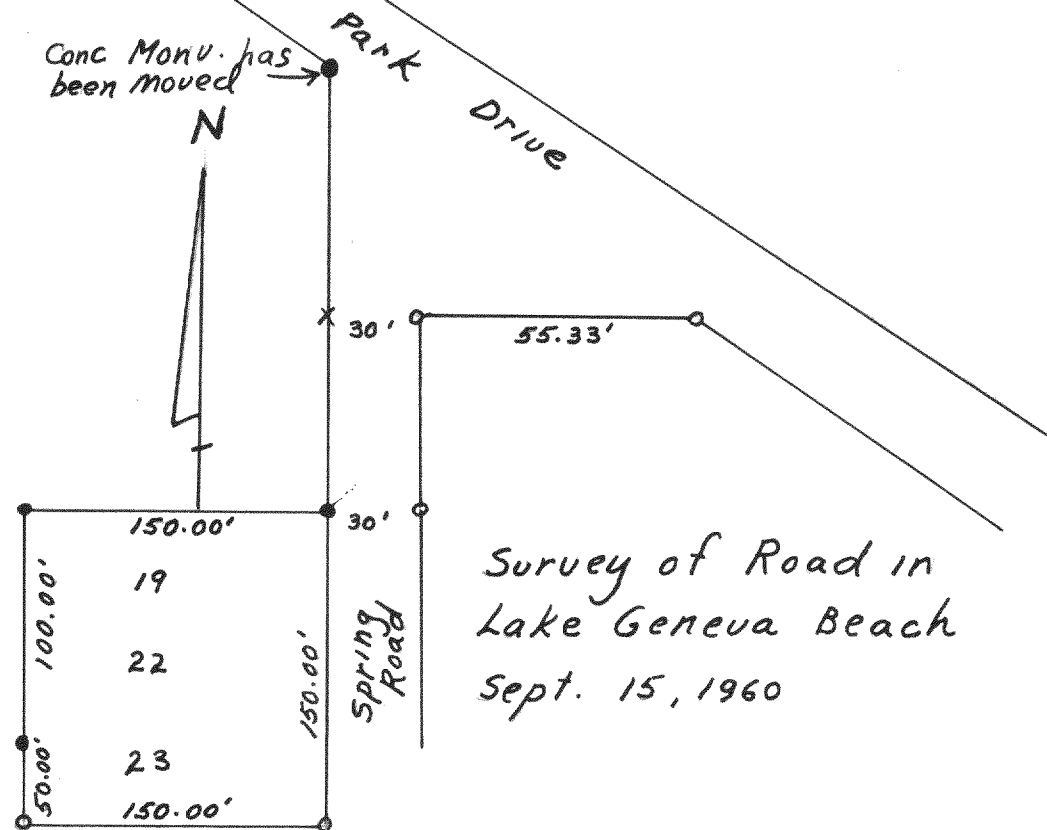

Survey of Lots 19, 22 & 23,
Lake Geneva Beach
Oct 6, 1960

Lloyd S. Jensen
County Surveyor


#3690

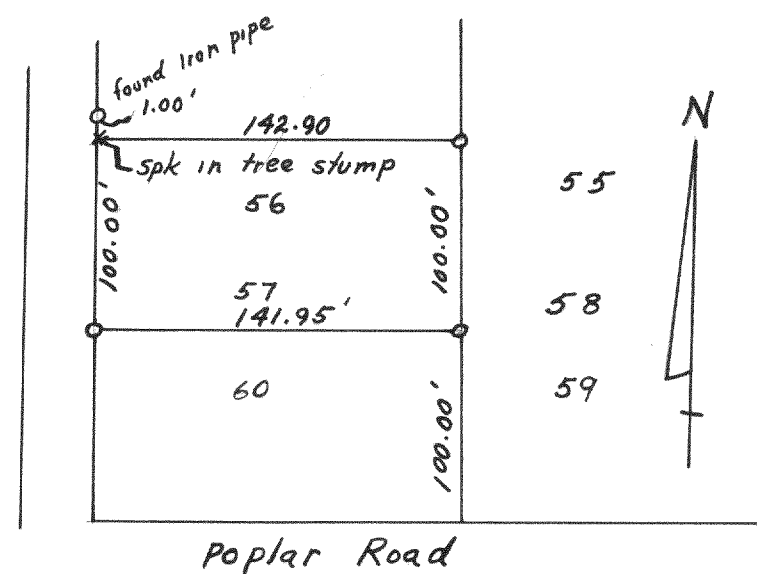

Survey of Lots 56 & 57,
Lake Geneva Beach
Oct 6, 1960

Lloyd S. Jensen
County Surveyor


#3688

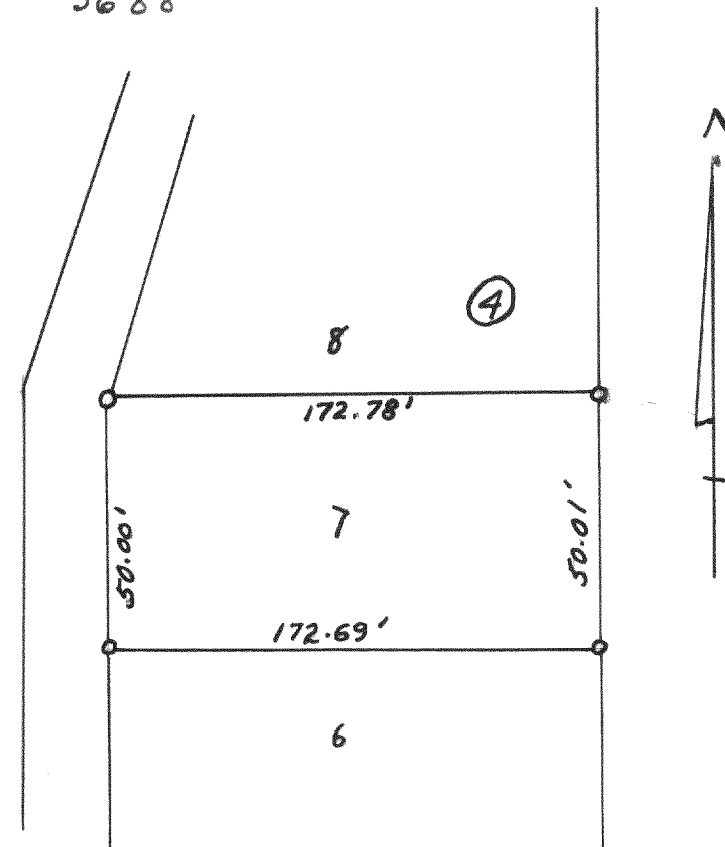

Survey of Lot 7, Block 4,
Sunset Hills, TIN, RITE
June 21, 1961

Lloyd S. Jensen
County Surveyor

#3691

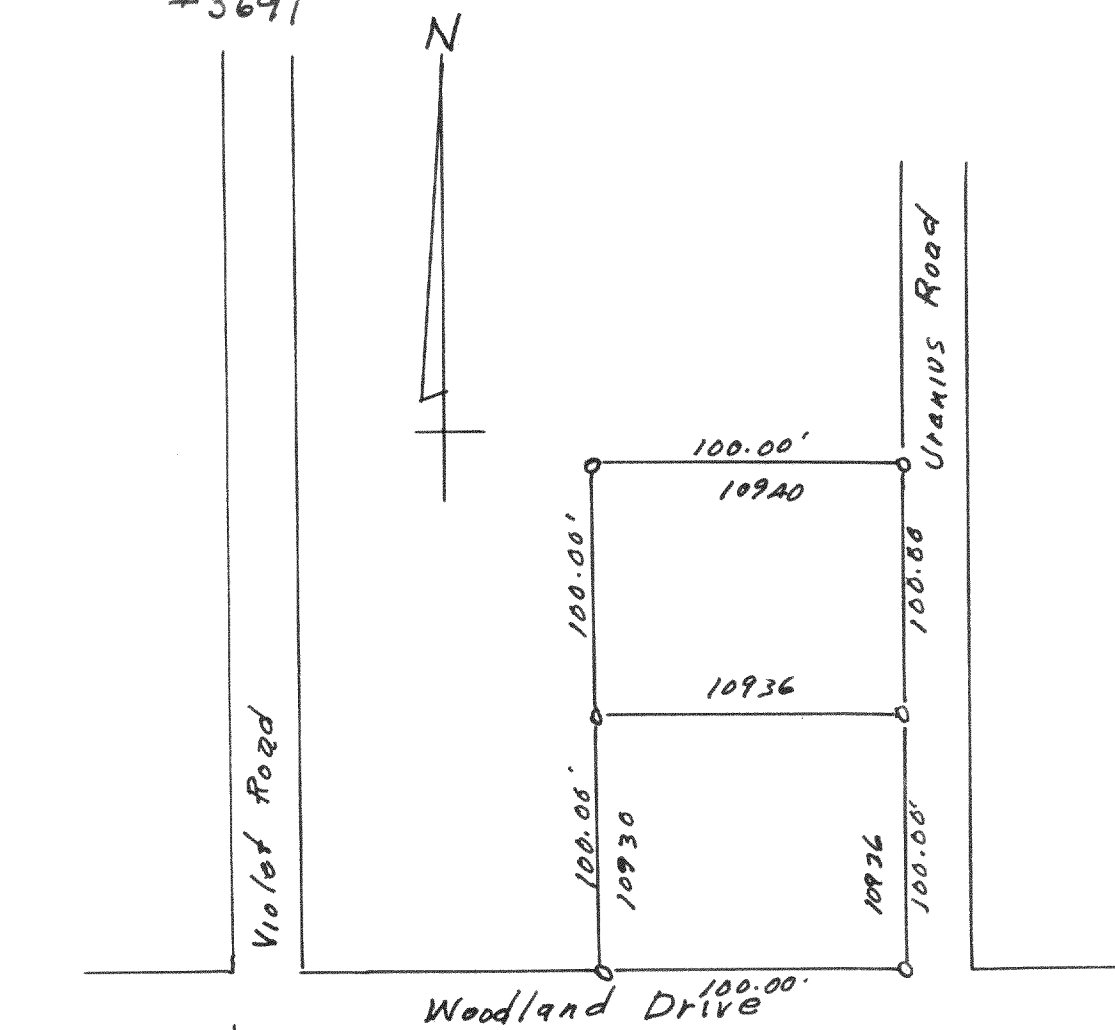


Survey of Lots 10926-30 &
10936-40, Lake Como Beach
April 6, 1960

Lloyd S. Jensen
County Surveyor

235


Survey of road in
NW 1/4 Sec 25-2-17
Apr. 18, 1960

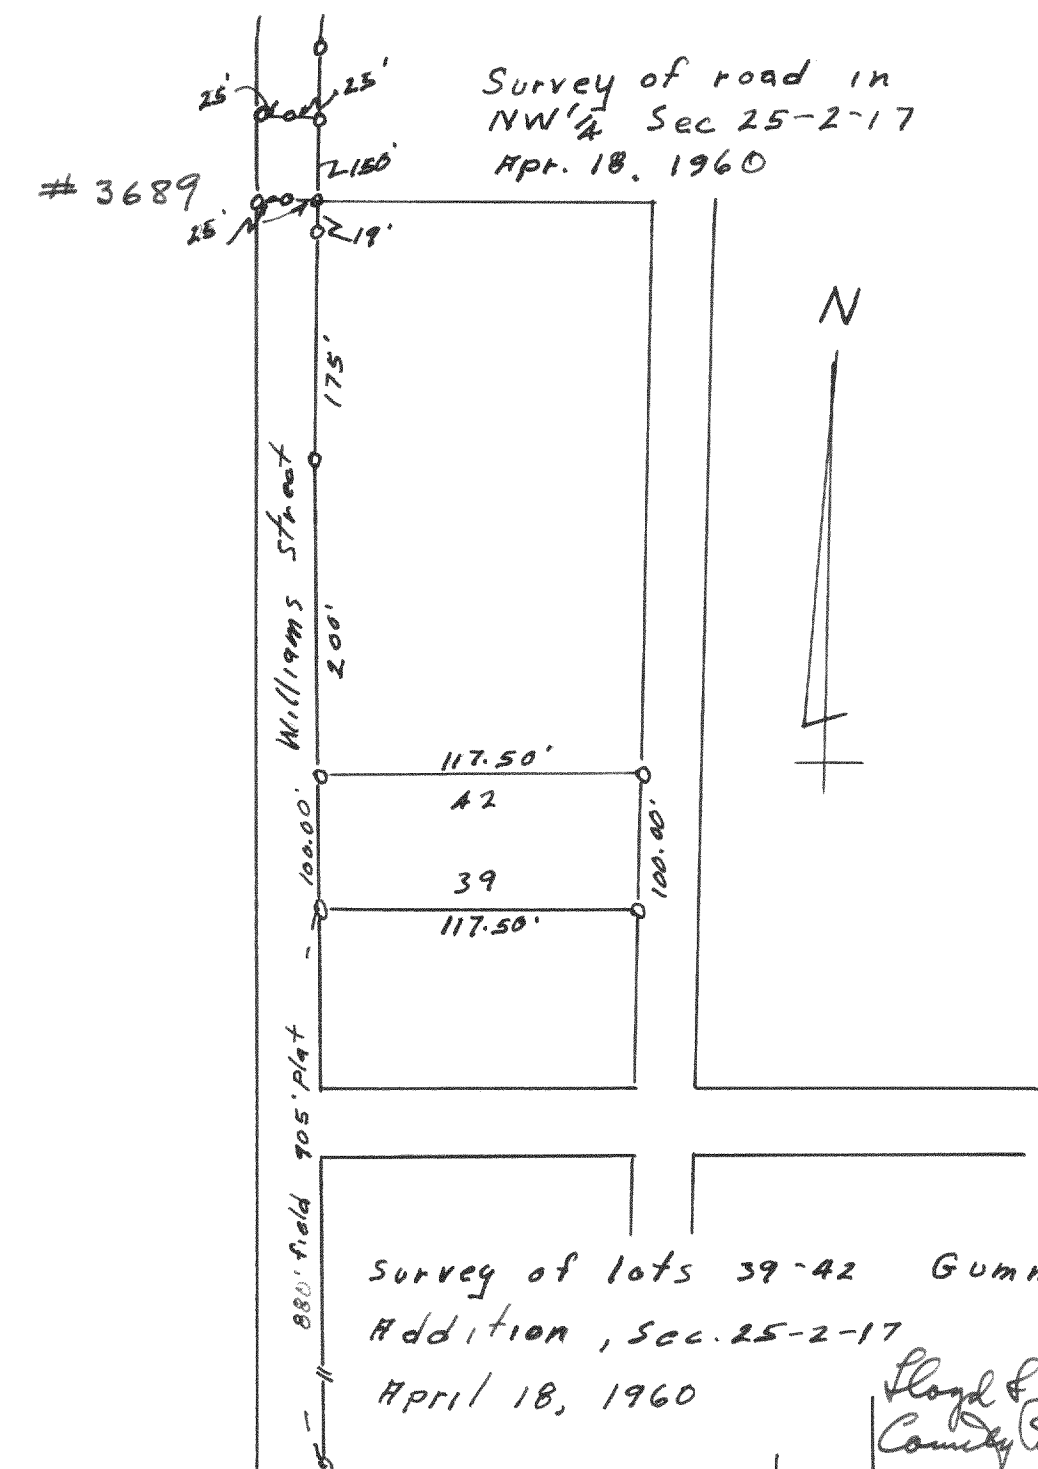

Survey of lots 39-42 Gummow
Addition, Sec. 25-2-17
April 18, 1960

Lloyd S. Jensen
County Surveyor

#3692

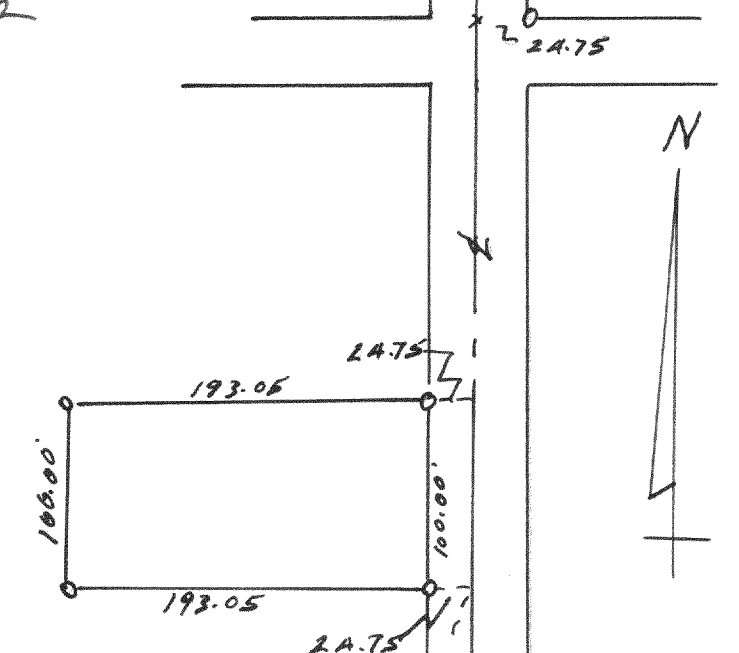

Survey in the NE 1/4, SW 1/4
SE 1/4 of Sec. 16-2-17
April 20, 1960

Lloyd S. Jensen
County Surveyor