



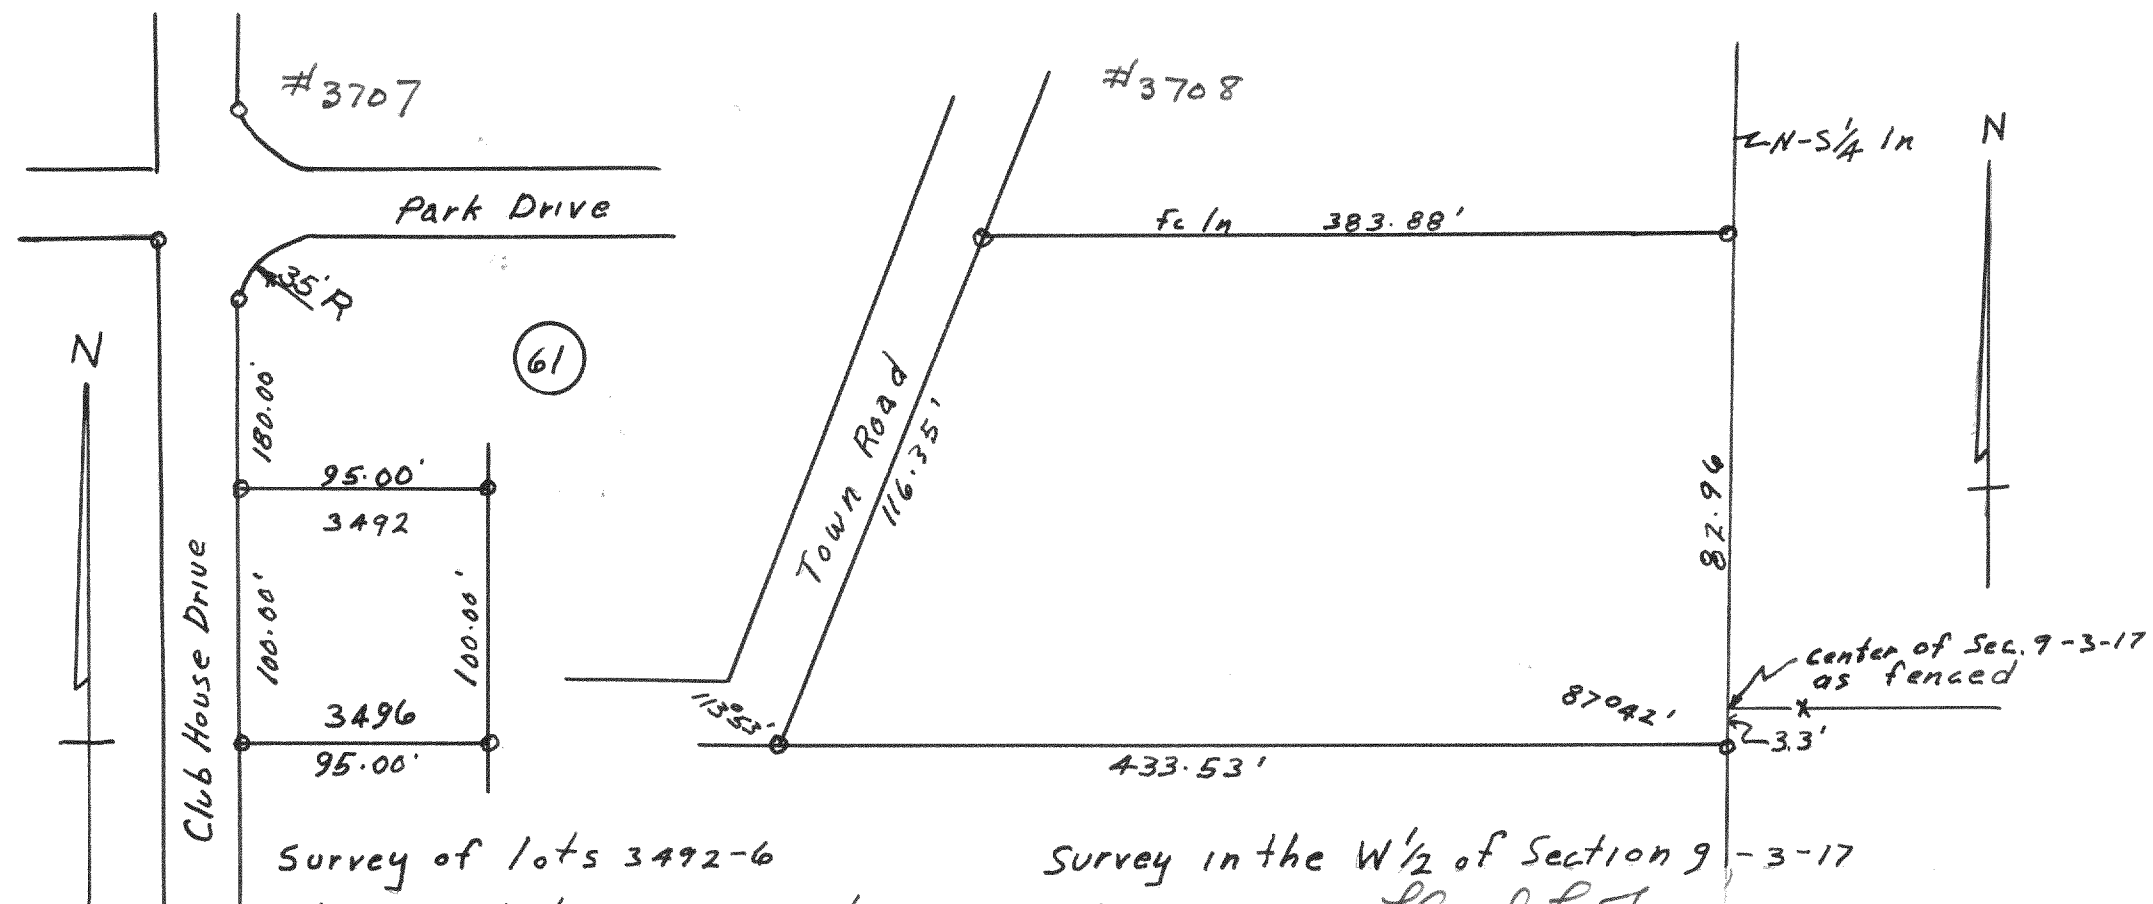


#3709

(141)

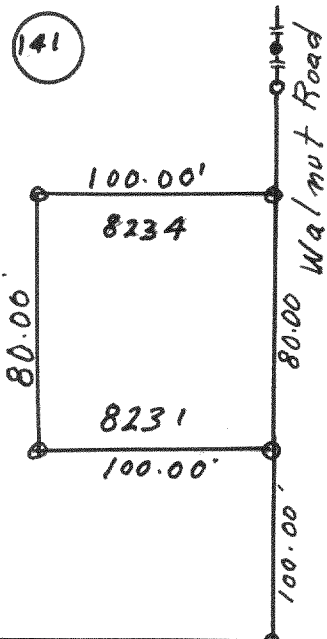


#3710

NE cor Sec 34-3-17

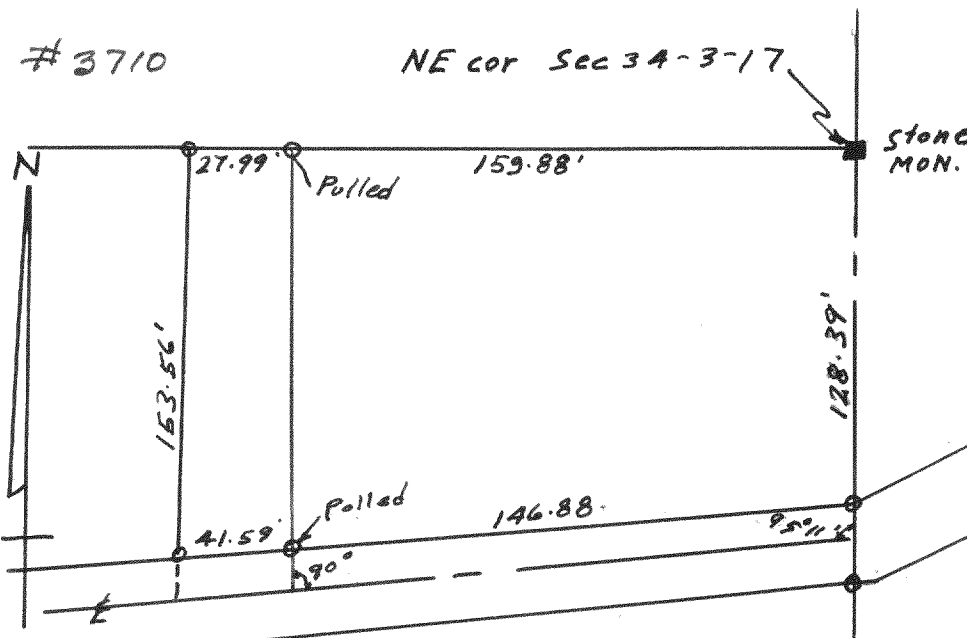

Survey in the E 1/2 NE 1/4 Sec 34-3-17
Nov. 19, 1960 Lloyd S. Jensen
County Surveyor

Survey of lots 8231-4
Block 141, Lake Como
Aug 29, 1961 Lloyd S. Jensen
County Surveyor

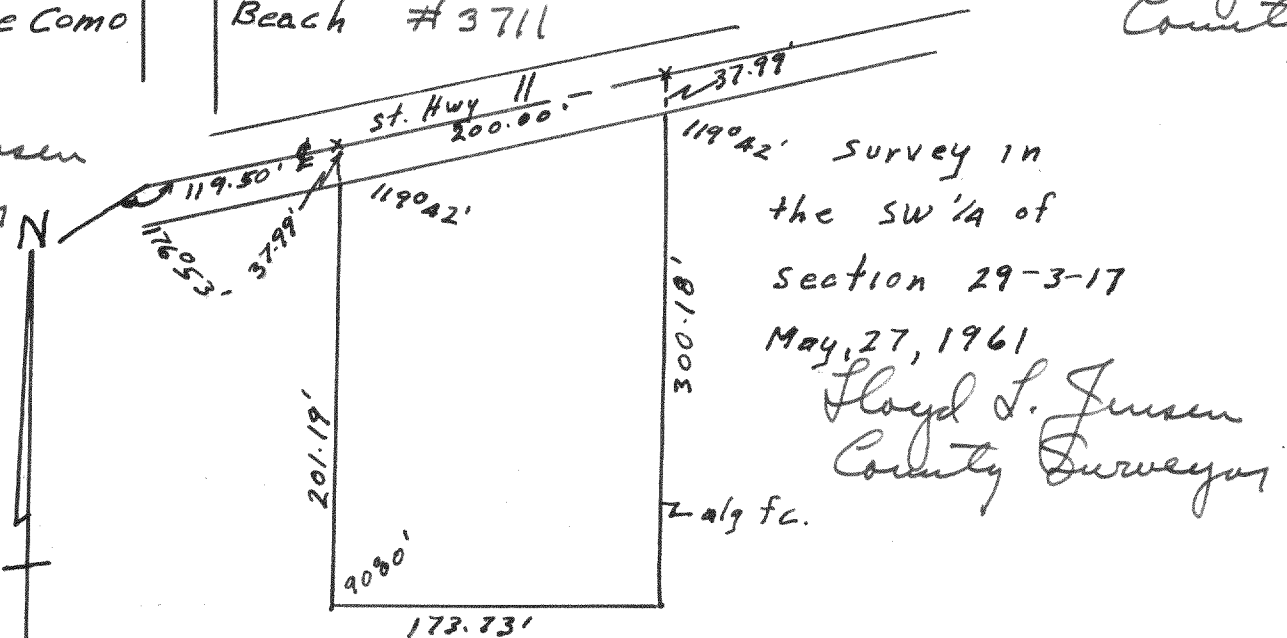

Survey in the SW 1/4 of Section 29-3-17
May 27, 1961 Lloyd S. Jensen
County Surveyor